


REVISIONS

Rev:

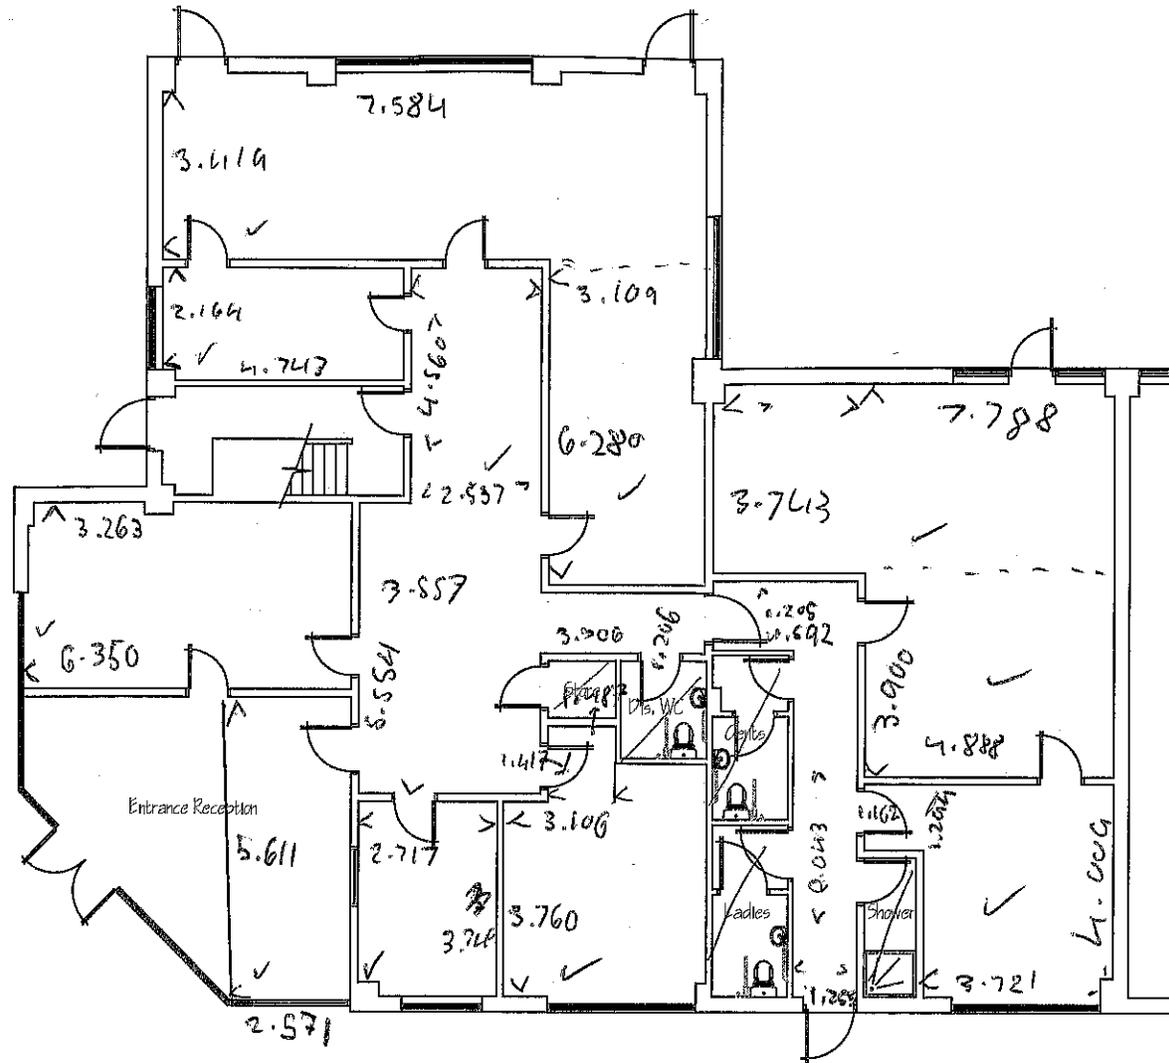

Unit 8&9 - Ground Floor Level Plan



ORIEL DESIGN LIMITED

Ty Cefn, Rectory Road, Cardiff, CF5 1QL

tel: 029 2030 0003

fax: 029 2030 0006

**ALTERATION & FIT OUT WORKS
UNIT 8&9, LLYS Y FEDWEN,
PARC MENAI, BANGOR**

EXISTING GFL PLAN


Drw No. 0760/40 | Rev: | Scale: 1:100@A3 | Date: Feb 2015

DO NOT SCALE

THIS DRAWING IS COPYRIGHT

REVISIONS

Rev:

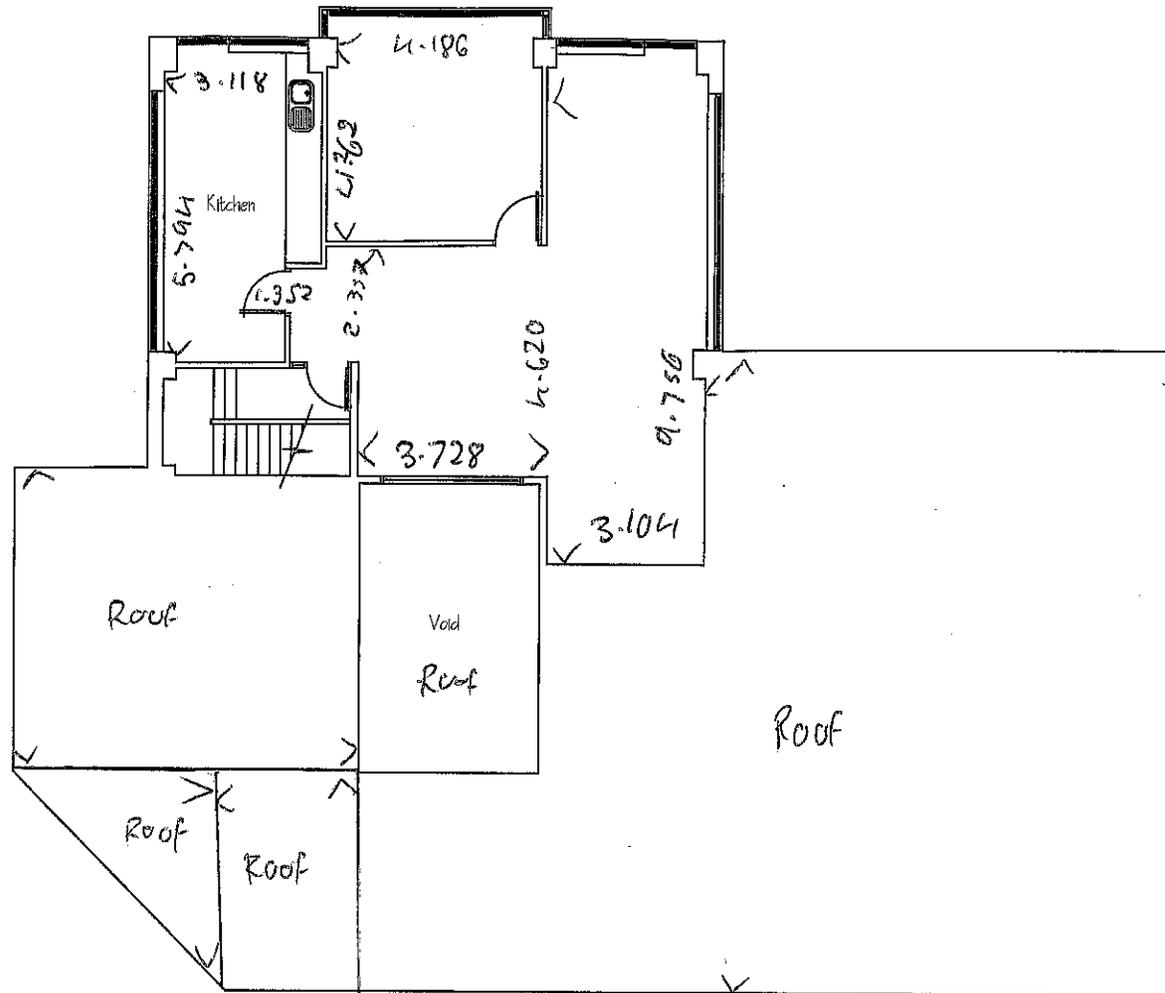

Unit 8&9 - First Floor Level Plan



ORIEL DESIGN LIMITED

Ty Cefn, Rectory Road, Cardiff, CF5 1QL
tel: 085 2038 0663 fax: 085 2038 6660


ALTERATION & FIT OUT WORKS
UNIT 8&9, LLYS Y FEDWEN,
PARC MENAI, BANGOR

EXISTING FFL PLAN


Drw No. 0700/41 | Rev: | Scale: 1:100@A3 | Date: Feb 2016

DO NOT SCALE THIS DRAWING IS COPYRIGHT


4,089 sq.ft

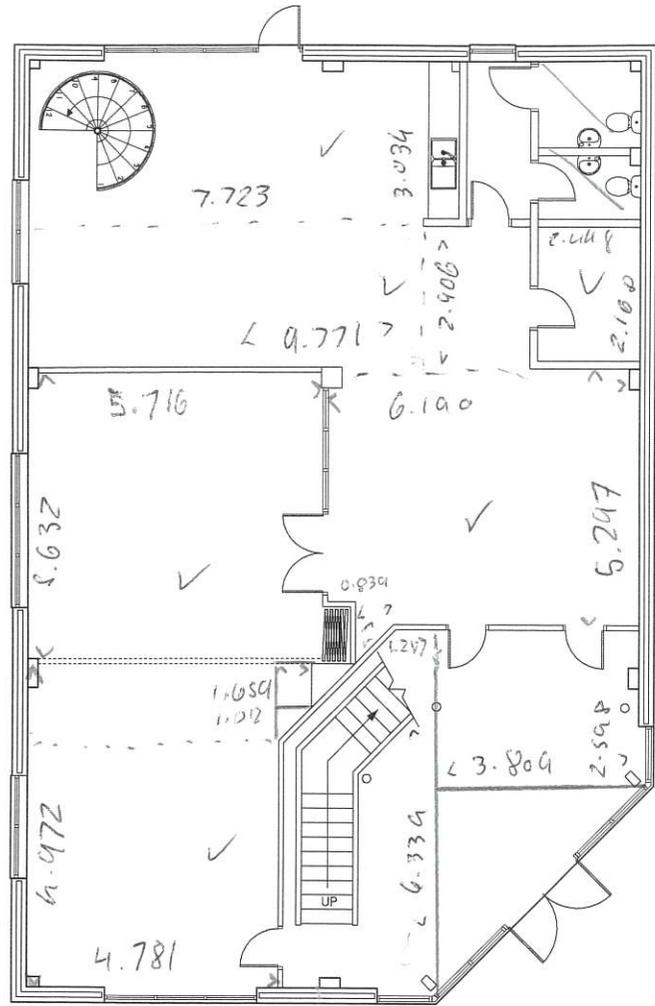

GROUND FLOOR

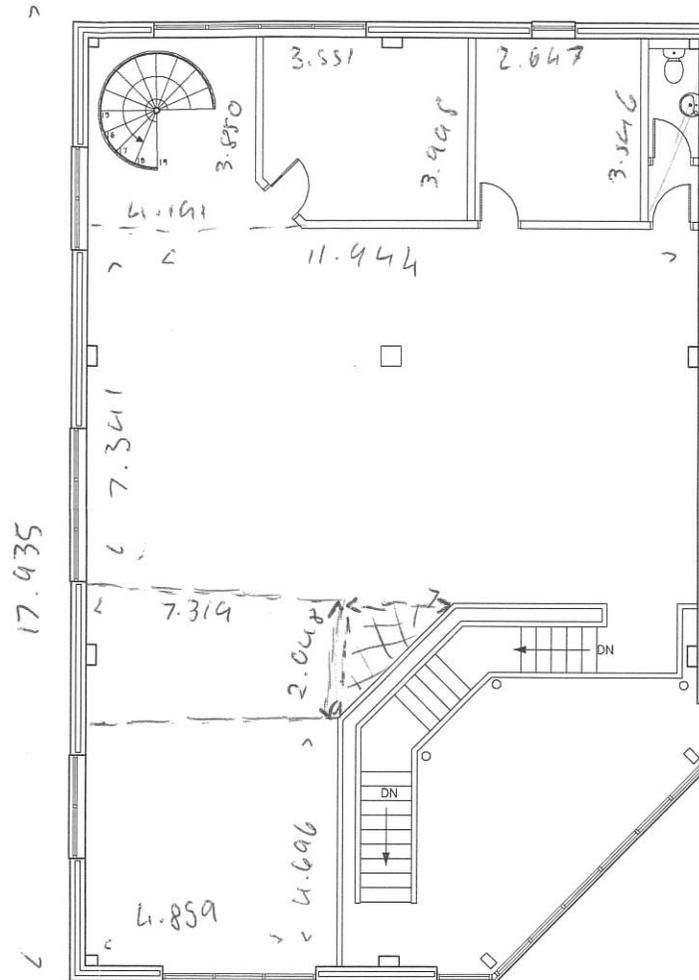

FIRST FLOOR

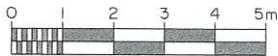

Project:
FLOOR PLAN

Location:
UNIT 16, LLYS Y FEDWEN,
PARC MENAI, BANGOR

Prepared for:
WELSH GOVERNMENT

Notes:
1. Do not scale from this drawing.

| Rev: | Date: | Comments: |
|------|-------|-----------|
| | | |

Cooke & Arkwright
 Cooke and Arkwright
 7&8 Windsor Place, Cardiff, CF10 3SX
 Tel: 0300346921 Website: www.coak.com

Title:
FLOOR PLAN

Purpose of Issue:
FOR INFORMATION

| Date of Issue: | Drawn by: | Approved by: |
|----------------|-------------|--------------|
| 28.09.18 | GW | JD |
| Scale: | Drawing No: | Revision: |
| 1:50@A1 | 01/101285 | A |