


AREA KEY

1QTY	WELCOME AREA
1QTY	12-16 PERSON BOARDROOM
1QTY	8 PERSON MEETING ROOM
2QTY	3 PERSON MEETING ROOM
3QTY	4 PERSON HIGHBACK SOFAS
2QTY	PHONE BOOTH
41QTY	1400W WORKSTATIONS
06QTY	AGILE AREA
1QTY	TEAPOINT AREA SEATING 30 PEOPLE
1QTY	COMMS ROOM
1QTY	DDA WC
1QTY	MALE - 31-45 OCCUPANCY
1QTY	FEMALE - 26-50 OCCUPANCY
1QTY	CLEANER'S CUPBOARD IN SHARED LOBBY

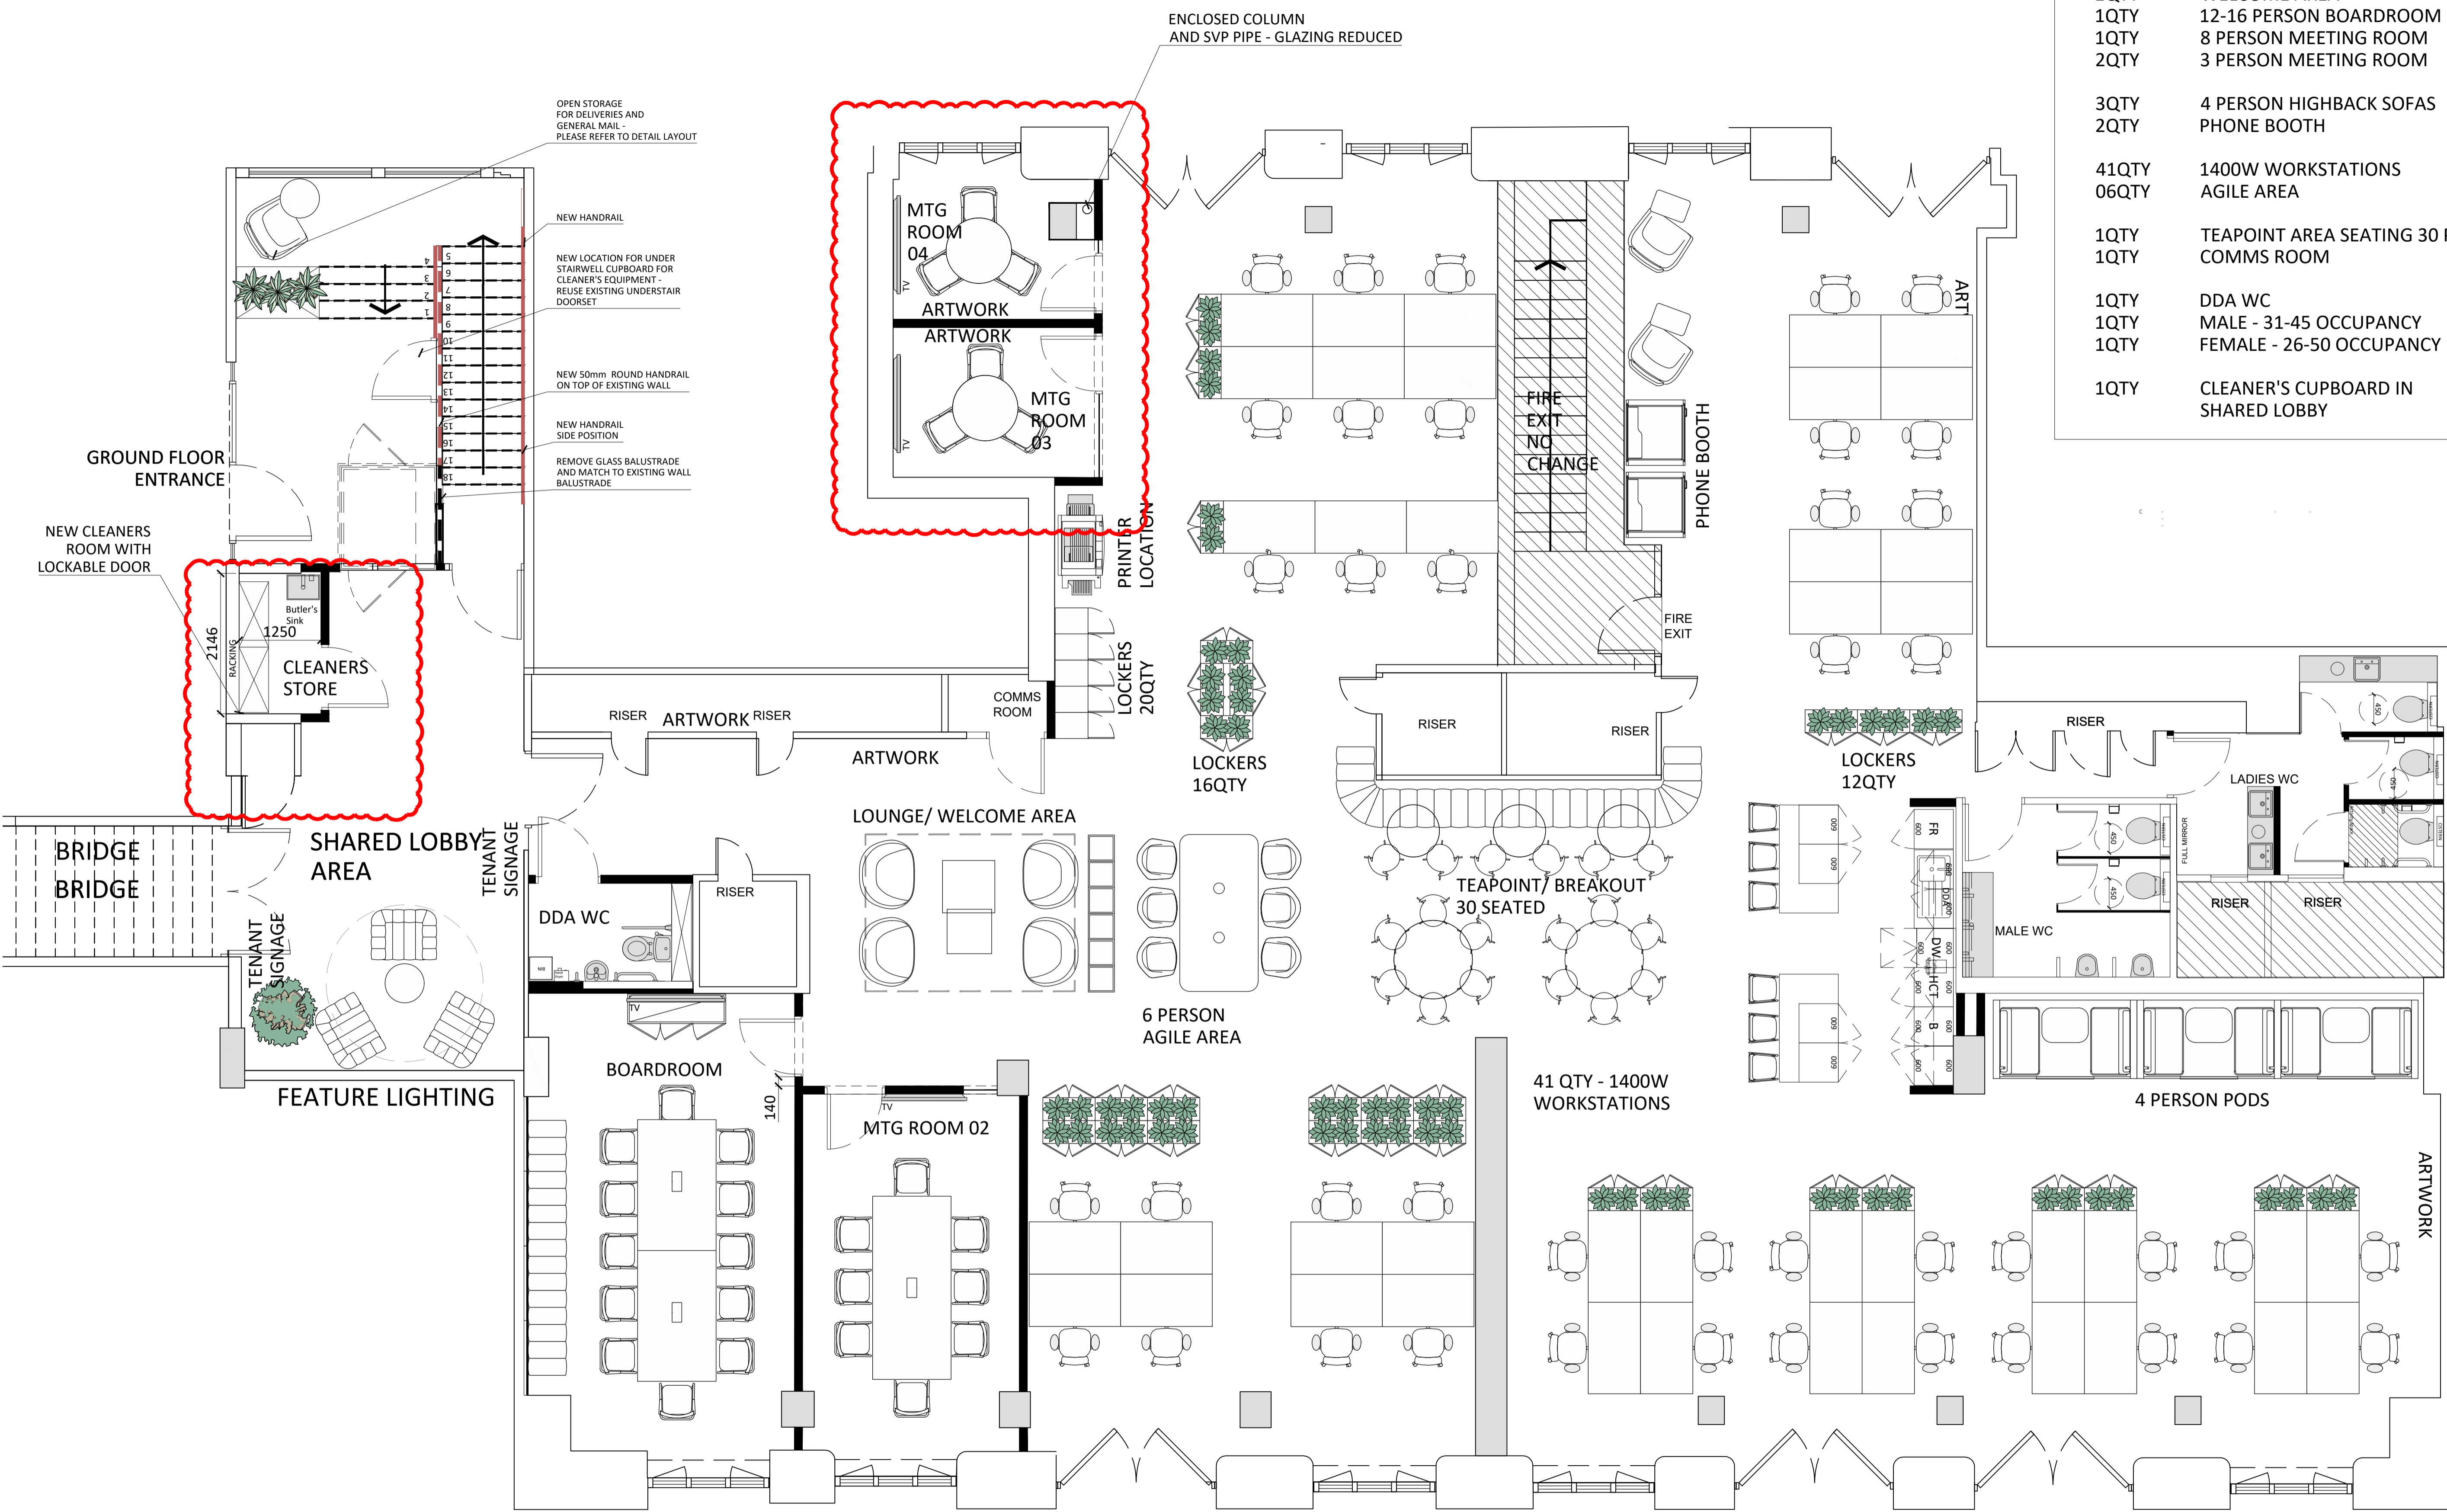

RIVER THAMES

01 GENERAL ARRANGEMENT LAYOUT
UNIT 1B & 2

A: WC Block adapted and new comms riser location and new DDA 05.04.26 MM

Notes/ Revisions/ Keys

Client Details
Langbourn Properties
36 Butlers Wharf
London
SE1 2YE

Project Details
UNIT 1B & 2
Ground & 1st Floor

Drawing Details

GENERAL ARRANGEMENT LAYOUT

Checked
Date 05.04.26 Scale 1:50@A1
Designer MM Revision A
DWG No. 000-GA-UNIT1B&2-01

Company Details

ADDRESS
RED Workspace
124 City Road
London, England
EC1V 2NX

TELEPHONE
0207 867 3719

EMAIL
info@redworkspace.co.uk

Quality Assurance Procedures

1. This drawing may not be copied, shown or given to a third party without express permission from RED Workspace Ltd.
2. Do not scale from this drawing.
3. RED Workspace cannot accept responsibility for the accuracy of scaled plans supplied to us by a third party in hard copy or on disc.
4. All design drawings must be signed by the designer as meeting the criteria of the project brief prior to being shown to the client or any external representative of the client.
5. All design drawings must be signed by the client prior to placing any related orders for new furniture on their behalf, where space planning work has been undertaken by the company.
6. A site survey must always be completed by a RED Workspace representative prior to the placing of any orders for new furniture, where space planning work has been undertaken by the company.