


NOTES:

ALL INFORMATION CONTAINED IN THIS DRAWING (INCLUDING DIGITAL DATA) SHOULD BE CHECKED & VERIFIED PRIOR TO ANY FABRICATION OR CONSTRUCTION.


## NORTH ARROW

 

## SITE CONTROL

STATION	EASTING	NORTHING	LEVEL	REMARK
P1	524855.530	178506.364	4.778	SURVEY NAL
P2	524853.180	178543.745	5.301	SURVEY NAL
P3	524807.759	178532.850	5.302	SURVEY NAL
P4	524852.840	178522.189	5.338	SURVEY NAL
P5	524798.402	178500.612	5.112	SURVEY NAL
P6	524777.255	178490.169	4.128	SURVEY NAL
P7	524777.915	178485.429	4.179	SURVEY NAL
P8	524823.910	178497.065	2.981	SURVEY NAL
P9	524823.576	178506.565	5.400	SURVEY NAL

## LEGEND

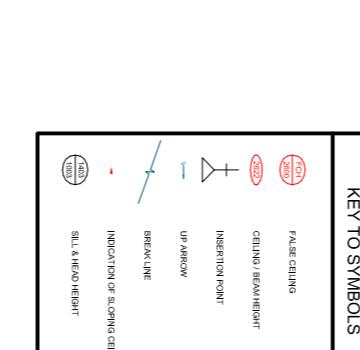

## 1ST FLOOR PLAN



Dayton Griffiths & Sury  
111-308, 1st Floor, Wilton Walk,  
London SW18 4GO  
Tel: +44 (0)207 498 9940  
E-mail: [psg@dayton-sury.com](mailto:psg@dayton-sury.com)  
Website: [www.dayton-sury.com](http://www.dayton-sury.com)

Drawing:

## FLOOR PLAN

COGENT BC

COGENT BC

Project:

Pembroke Building  
Avonmore Rd  
Hammersmith, London  
W14 8ET

Title:

FIRST FLOOR PLAN

EXISTING SURVEY

.

DWG REF: Pembroke Building - Existing Survey

DRAWING NO.: 003

REVISION NO.: .

SCALE: 1:100 @ A1

DATE CHECKED: MAR 2021

DRAWN BY: D G &amp; S

CHECKED BY: D G &amp; S