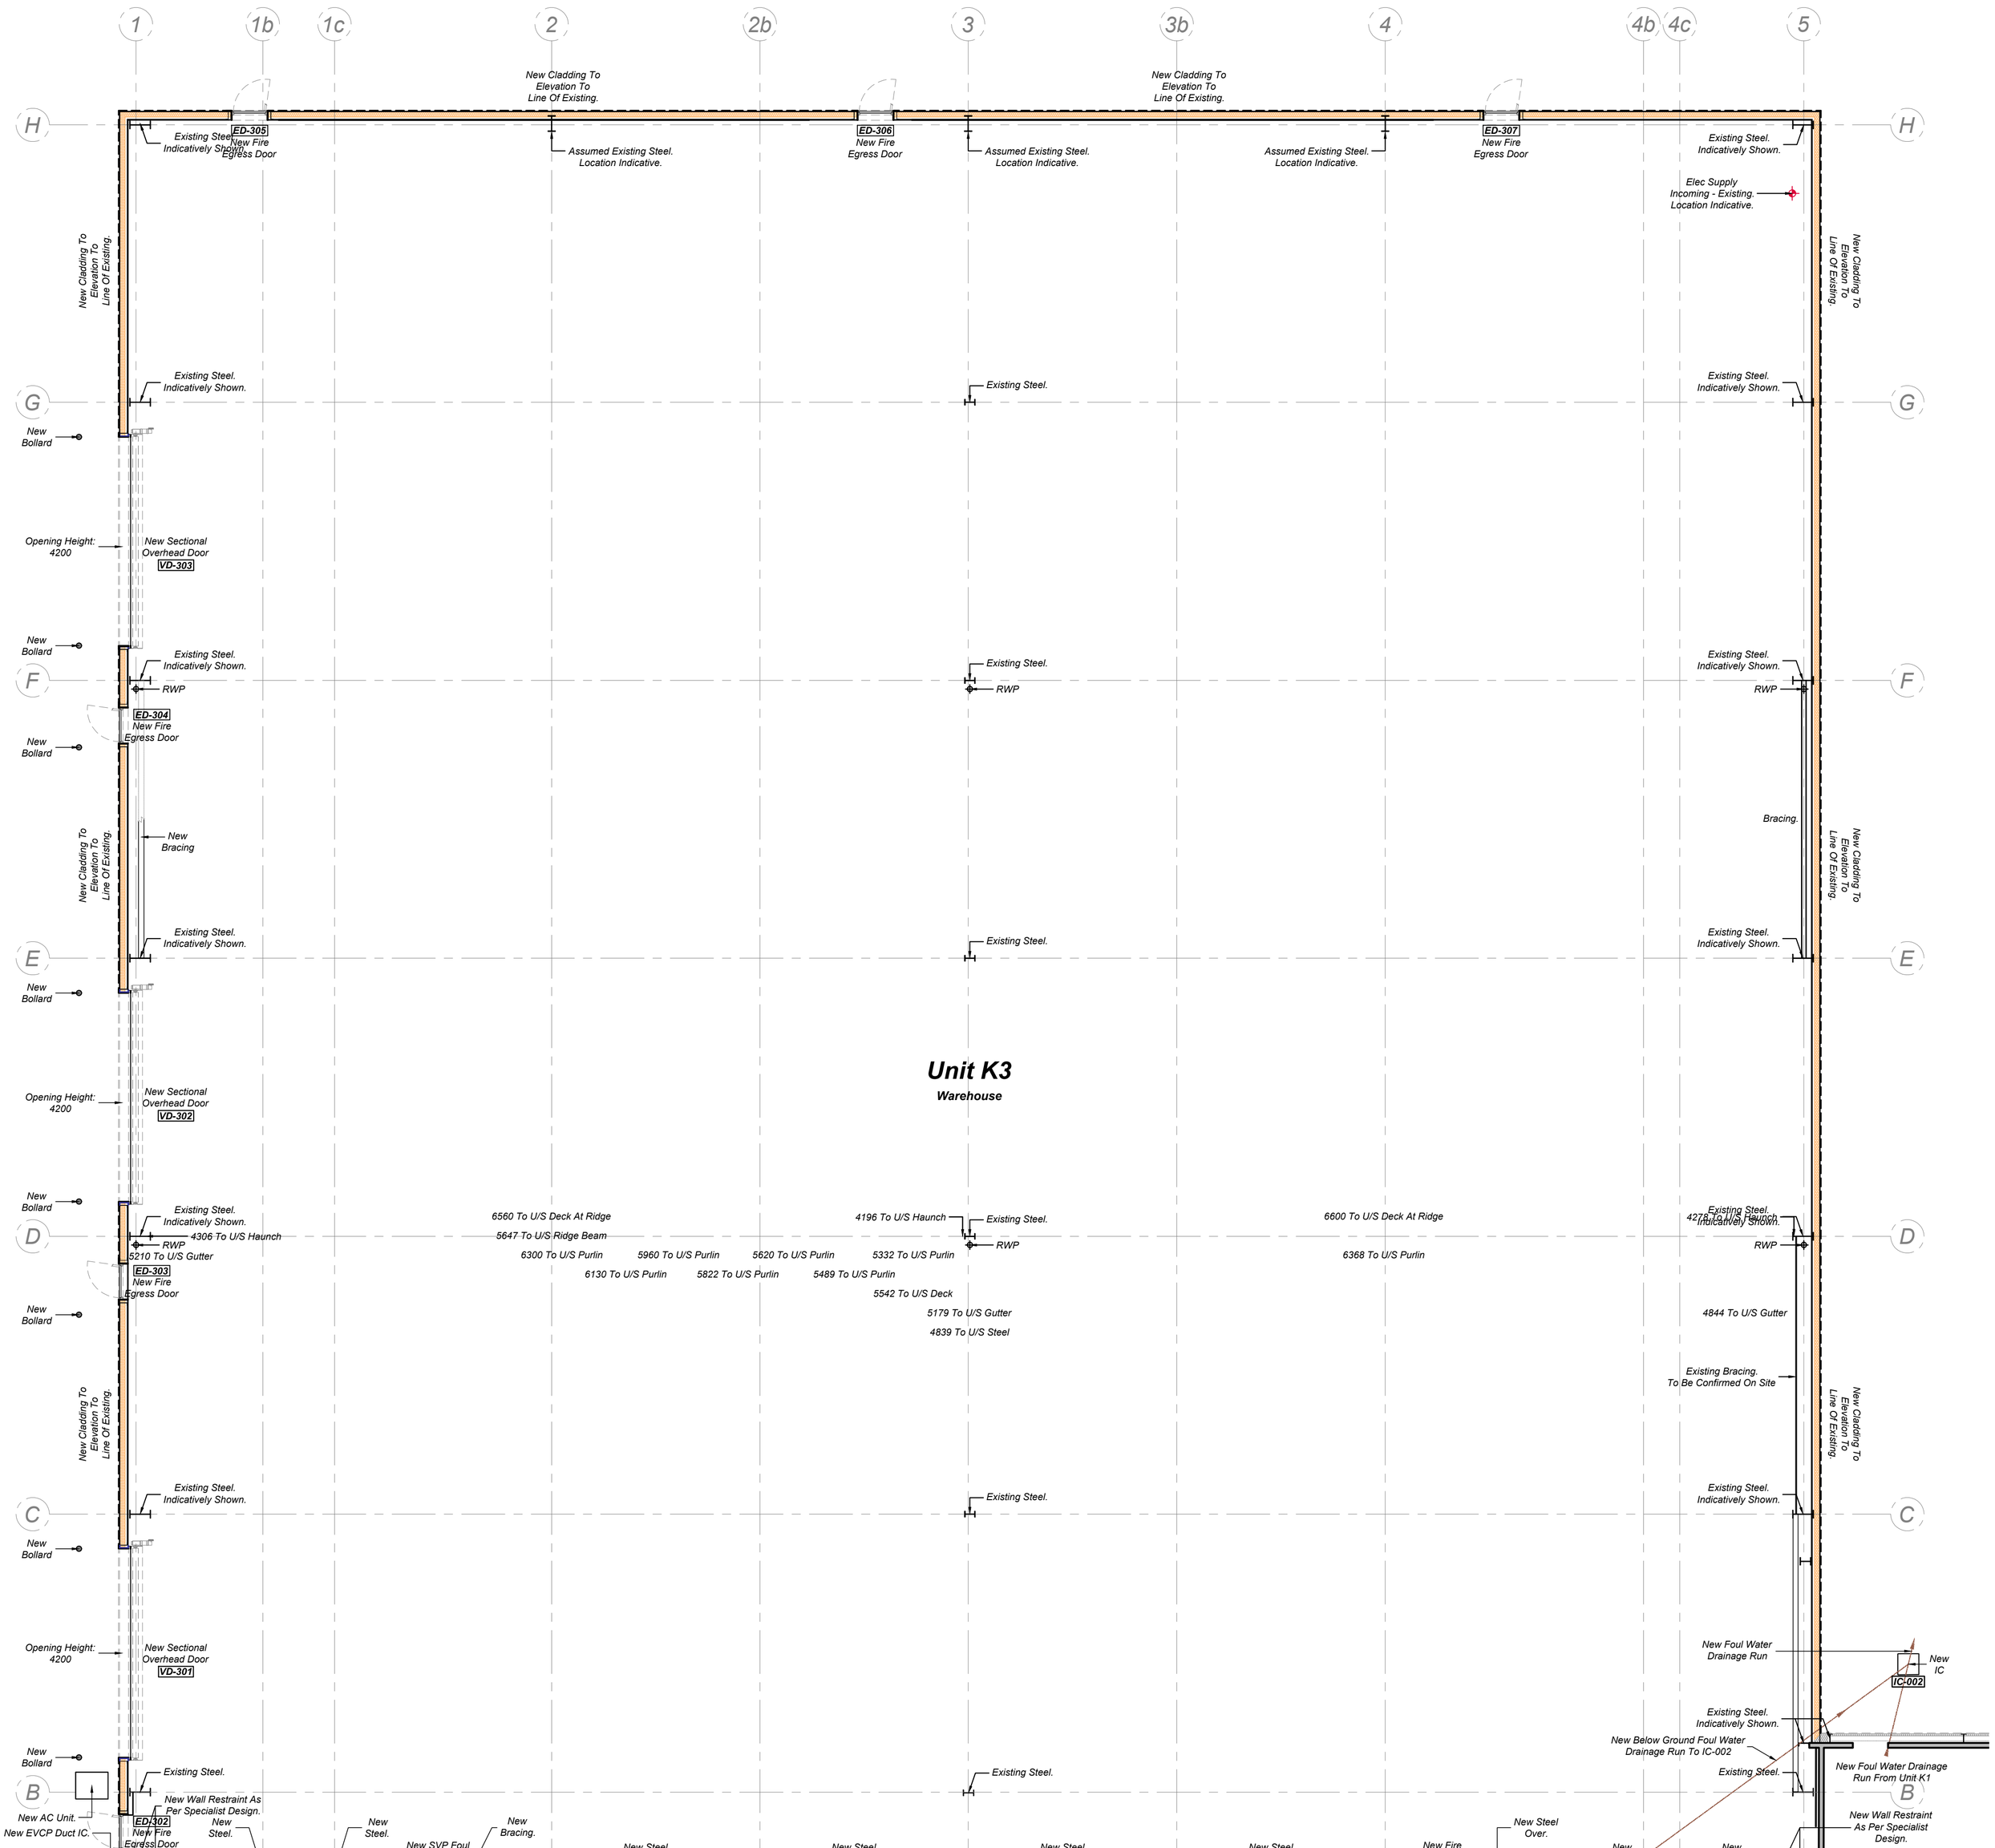

issue status: **As Built**

The copyright of this drawing and design is vested in the Company and must not be copied or reproduced without written consent. This drawing to be read in conjunction with the specification and other drawings. Do not scale to ascertain dimensions. All dimensions to be checked and verified on site by the responsible contractor prior to commencement of work.

rev	description	initials	date
A	Floor Plan Updated Following Site Visit.	DDP.	12/11/2021.

- Existing / Survey
- Sketch / Design
- Tender / Contract
- Planning Approval
- Building Control
- Construction
- Health & Safety
- As Built

drawing title: Unit K3 As Built Floor Plans

client: Mileway

project no.: 181101 | date: October 2021 | scale: 1:100 | size: A1 | drawn: DDP | checked: PH

project: Units K1, K2 & K3, Kiln Farm Ind. Est., Milton Keynes, MK11 3EW.

Unit K3

SOLACE PROPERTY CONSULTANCY
Solace Property Consultancy Ltd
4 Church Court, Cox Street, Birmingham B3 1RD
tel +44 (0) 121 233 2320
www.solacebc.co.uk

rev. A

no. 807