
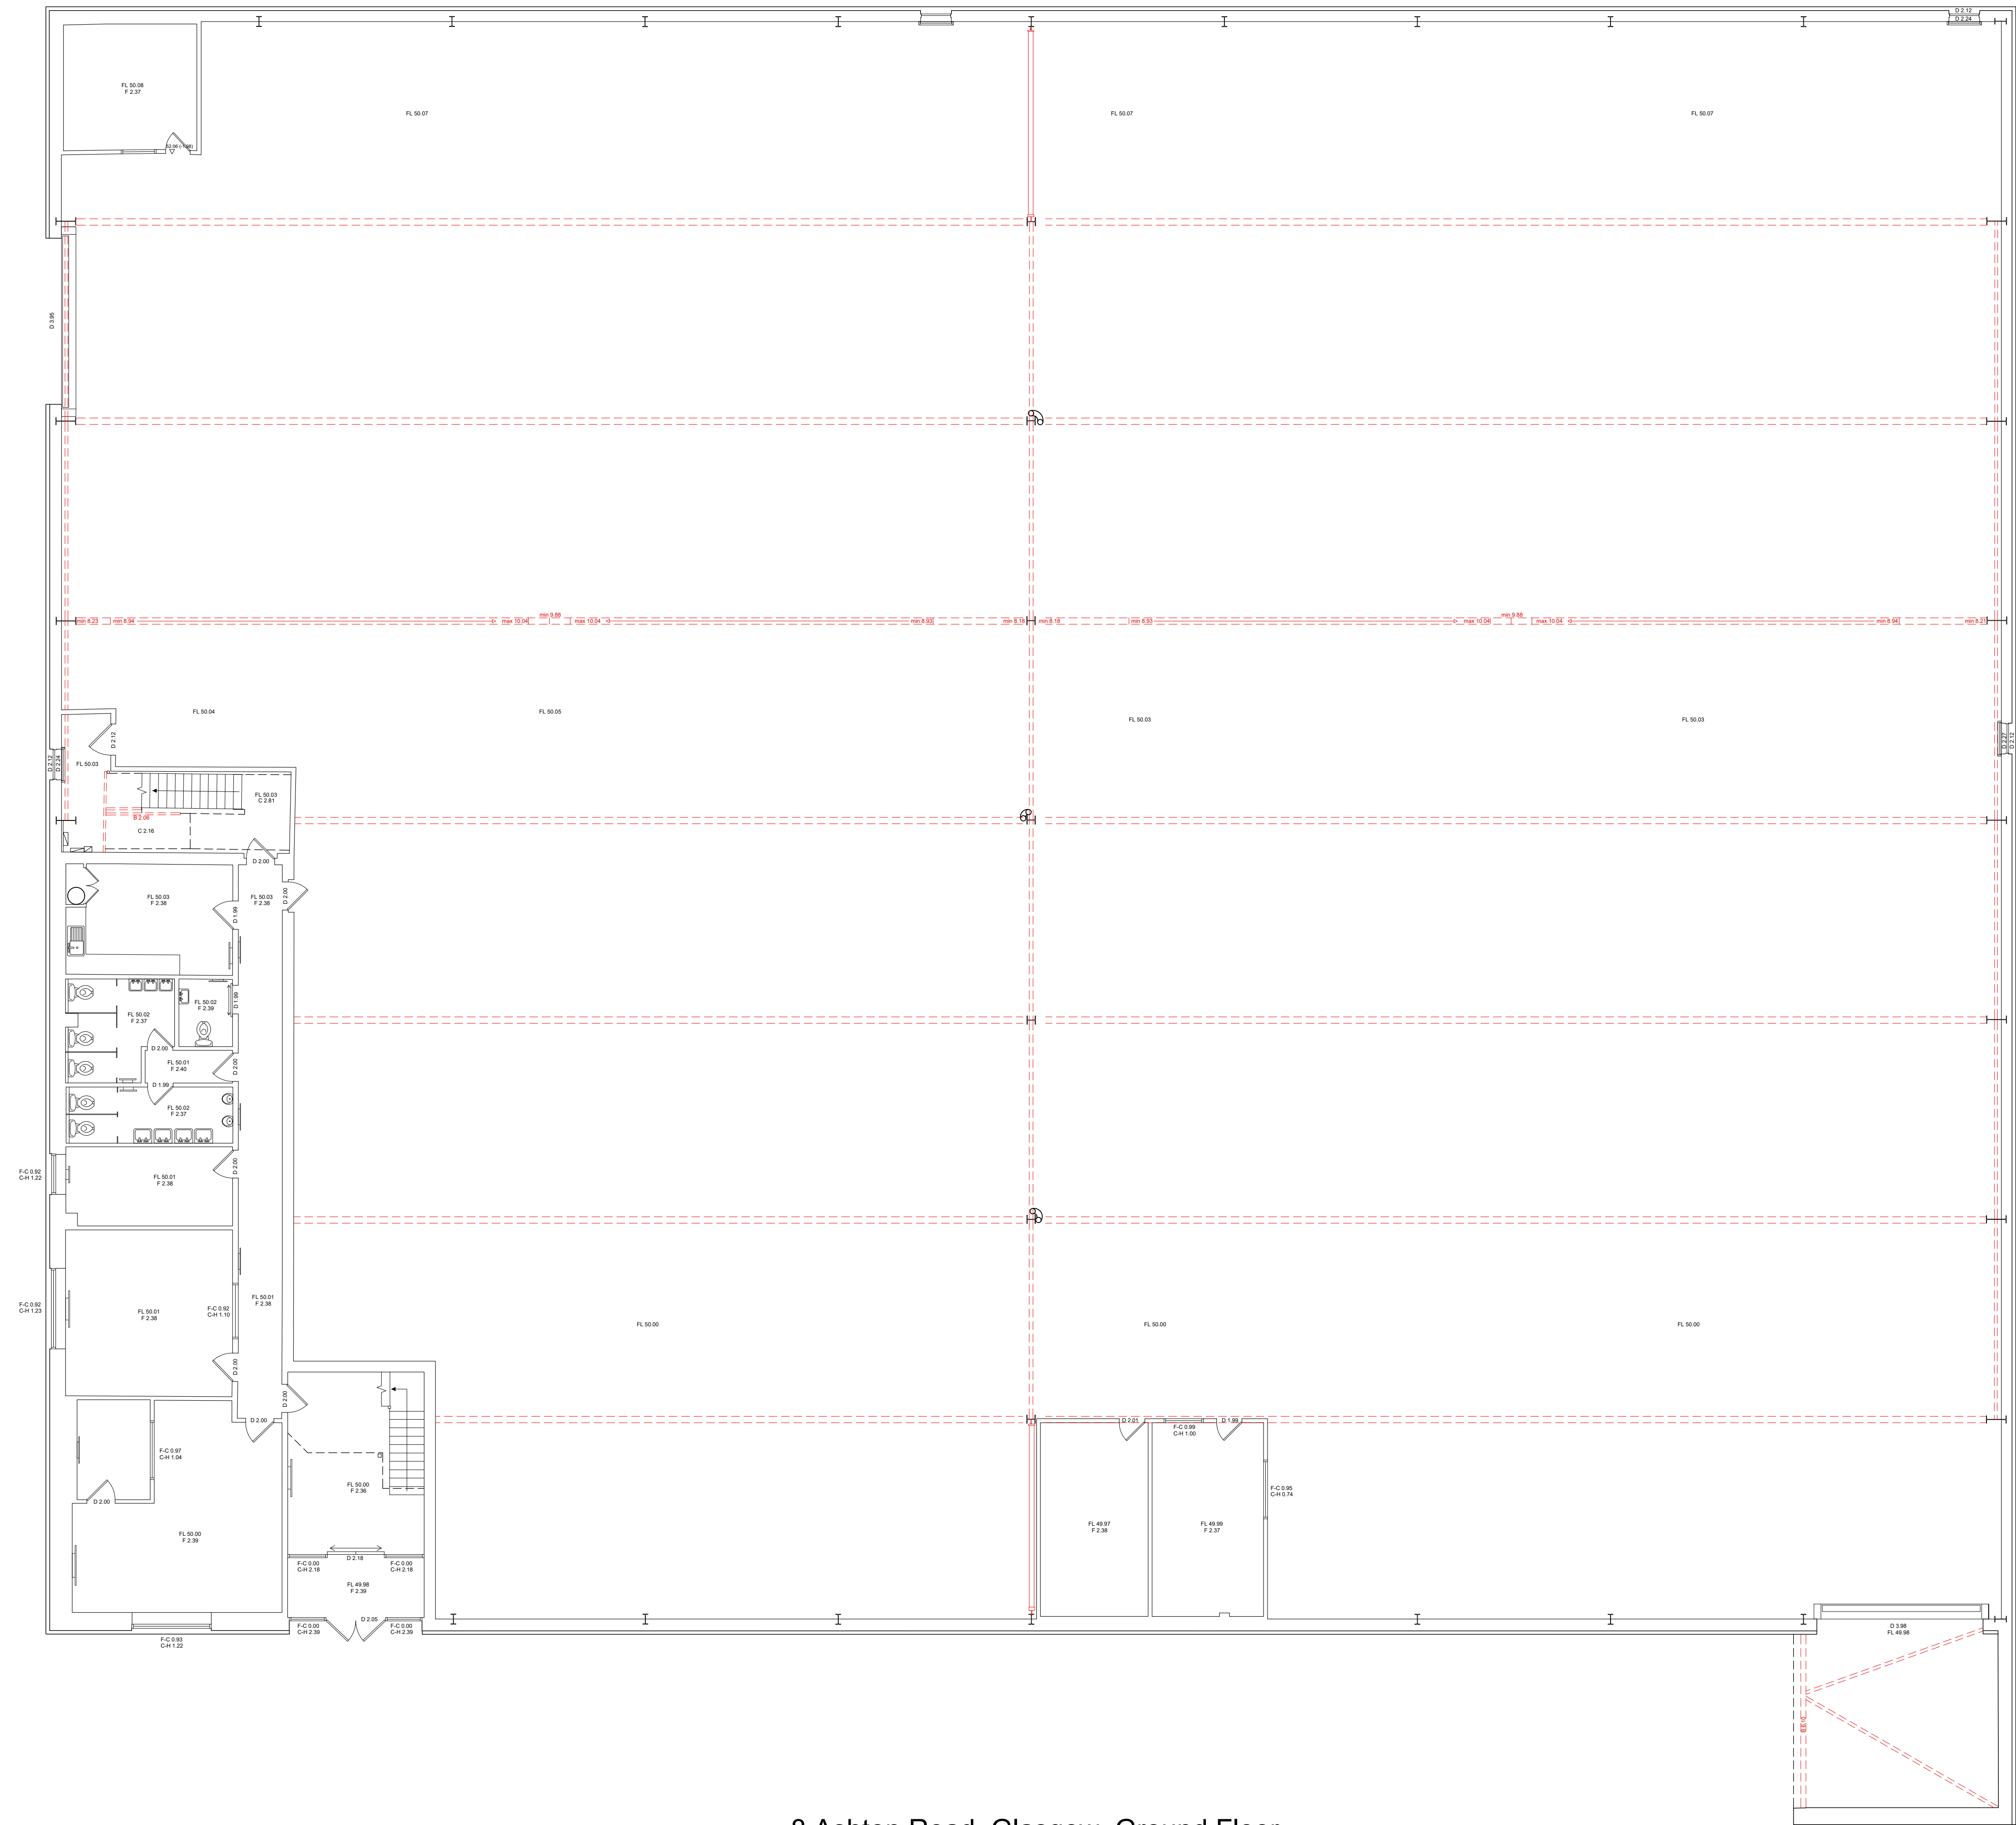
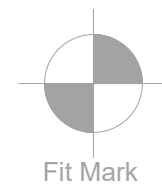


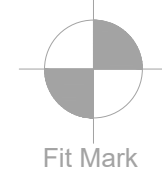


8 Ashton Road, Glasgow_Ground Floor

LEGEND

- ACCESS HATCH
- AIR CONDITIONING
- A/C CONTROL PANEL
- ALARM SENSOR
- ARCH HEAD HEIGHT
- ARCH SPRINGER HEIGHT
- BEAM HEIGHT
- BELL
- BLANKING PLATE
- BREAK GLASS
- CEILING
- CEILING LIGHT
- CILL TO HEAD
- CLOSE CIRCUIT CAMERA
- DISTRIBUTION BOARD
- DOOR HEAD HEIGHT
- DOOR RELEASE
- DOUBLE SOCKET
- DUCTING
- EMERGENCY DOOR RELEASE
- EMERGENCY EXIT LIGHTING
- EMERGENCY LIGHTING
- EXTRACTOR FAN
- FALSE / SUSPENDED CEILING
- FAN
- FIRE ALARM BELL
- FIRE EXTINGUISHER
- FLOOR TO CILL
- FLOURESCENT LIGHTING
- FLOOR LEVEL
- FUSED SPUR
- HAND DRYER
- HOSE REEL
- HOT WATER BOILER
- INSPECTION COVER
- INTEL HEIGHT
- LIGHT SWITCH / SINGLE
- LIGHT SWITCH / DOUBLE
- LIGHT SWITCH / TRIPLE
- LIGHT SWITCH / QUADRUPLE
- LOW VOLTAGE SUPPLY
- PHONE / DATA POINT
- PULL CORD SWITCH
- RADIATOR
- RAIN WATER PIPE
- SINGLE SOCKET
- SKYLIGHT
- SLOPED CEILING
- SMOKE DETECTOR
- SERVICE PIPE
- SPOTLIGHT
- SWITCH
- SWITCHED FUSED SPUR
- THERMOSTAT
- UNKNOWN SERVICE
- WALL LIGHT

Accuracy commensurate with scale of drawing.

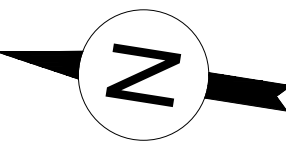

INDICATIVE ONLY



PAVILION 2
BUCHANAN BUSINESS PARK
GLASGOW
G3 6HZ
TEL: 0141 776 7971
WWW.SIGMA-SURVEYS.COM

10 LOCHSIDE PLACE
EDINBURGH PARK
EDINBURGH
EH12 9RB
TEL: 0131 303 7861
QUOTE@SIGMA-SURVEYS.COM

SURVEYED	R. RENNIE	SCALE
DRAWN	R. RENNIE	1:100 (A1 Sheet)
CHECKED	J. ROMAN	

C B R E

8 ASHTON RD, RUTHERGLEN, GLASGOW


MEASURED BUILDING SURVEY
GROUND FLOOR

Job No.	Drawing No.	Date	Revision
20/269	20/269/01A	May 2020	



REVISION	NOTES	DATE
----------	-------	------

Notes:
Grid is arbitrary.
All levels are to a local datum.



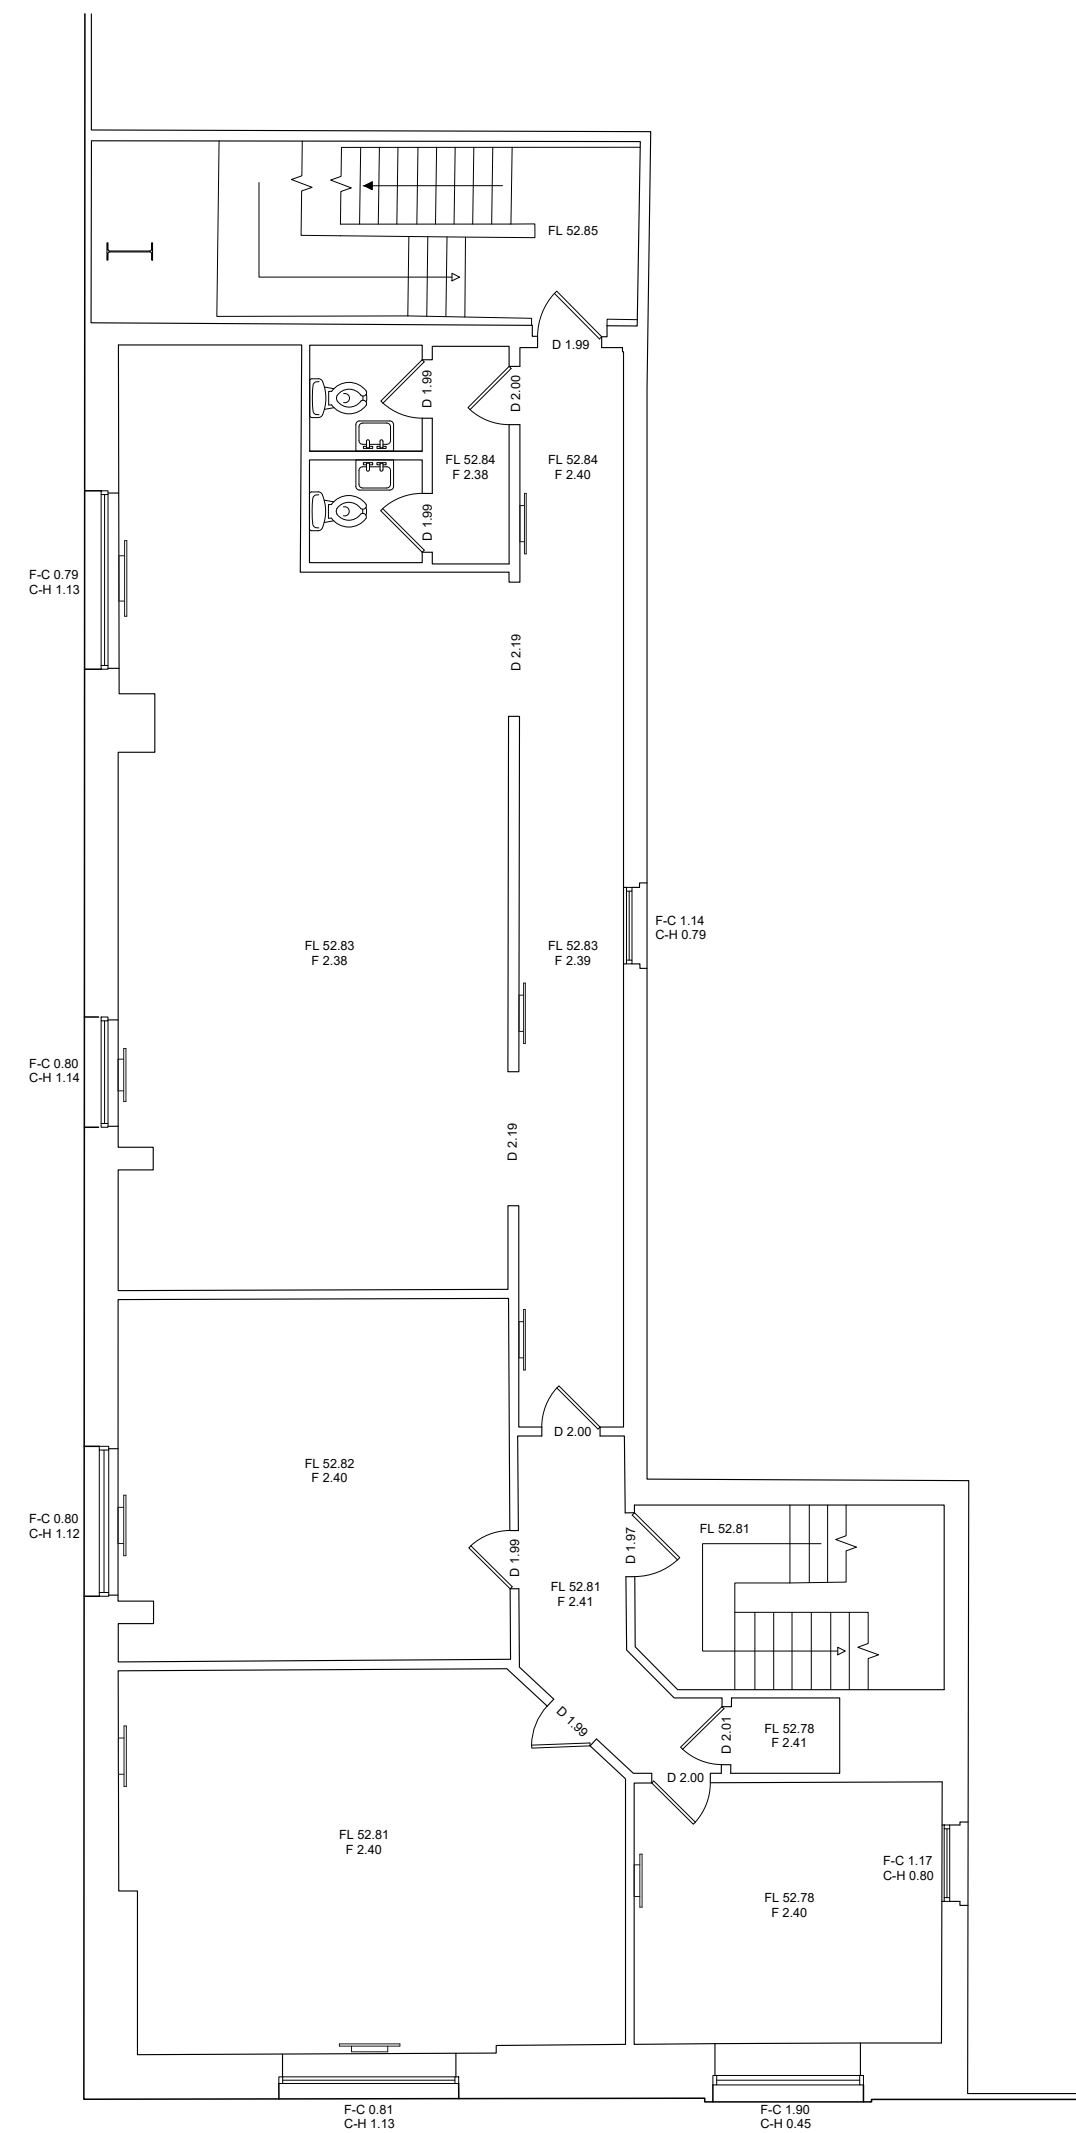

First Floor

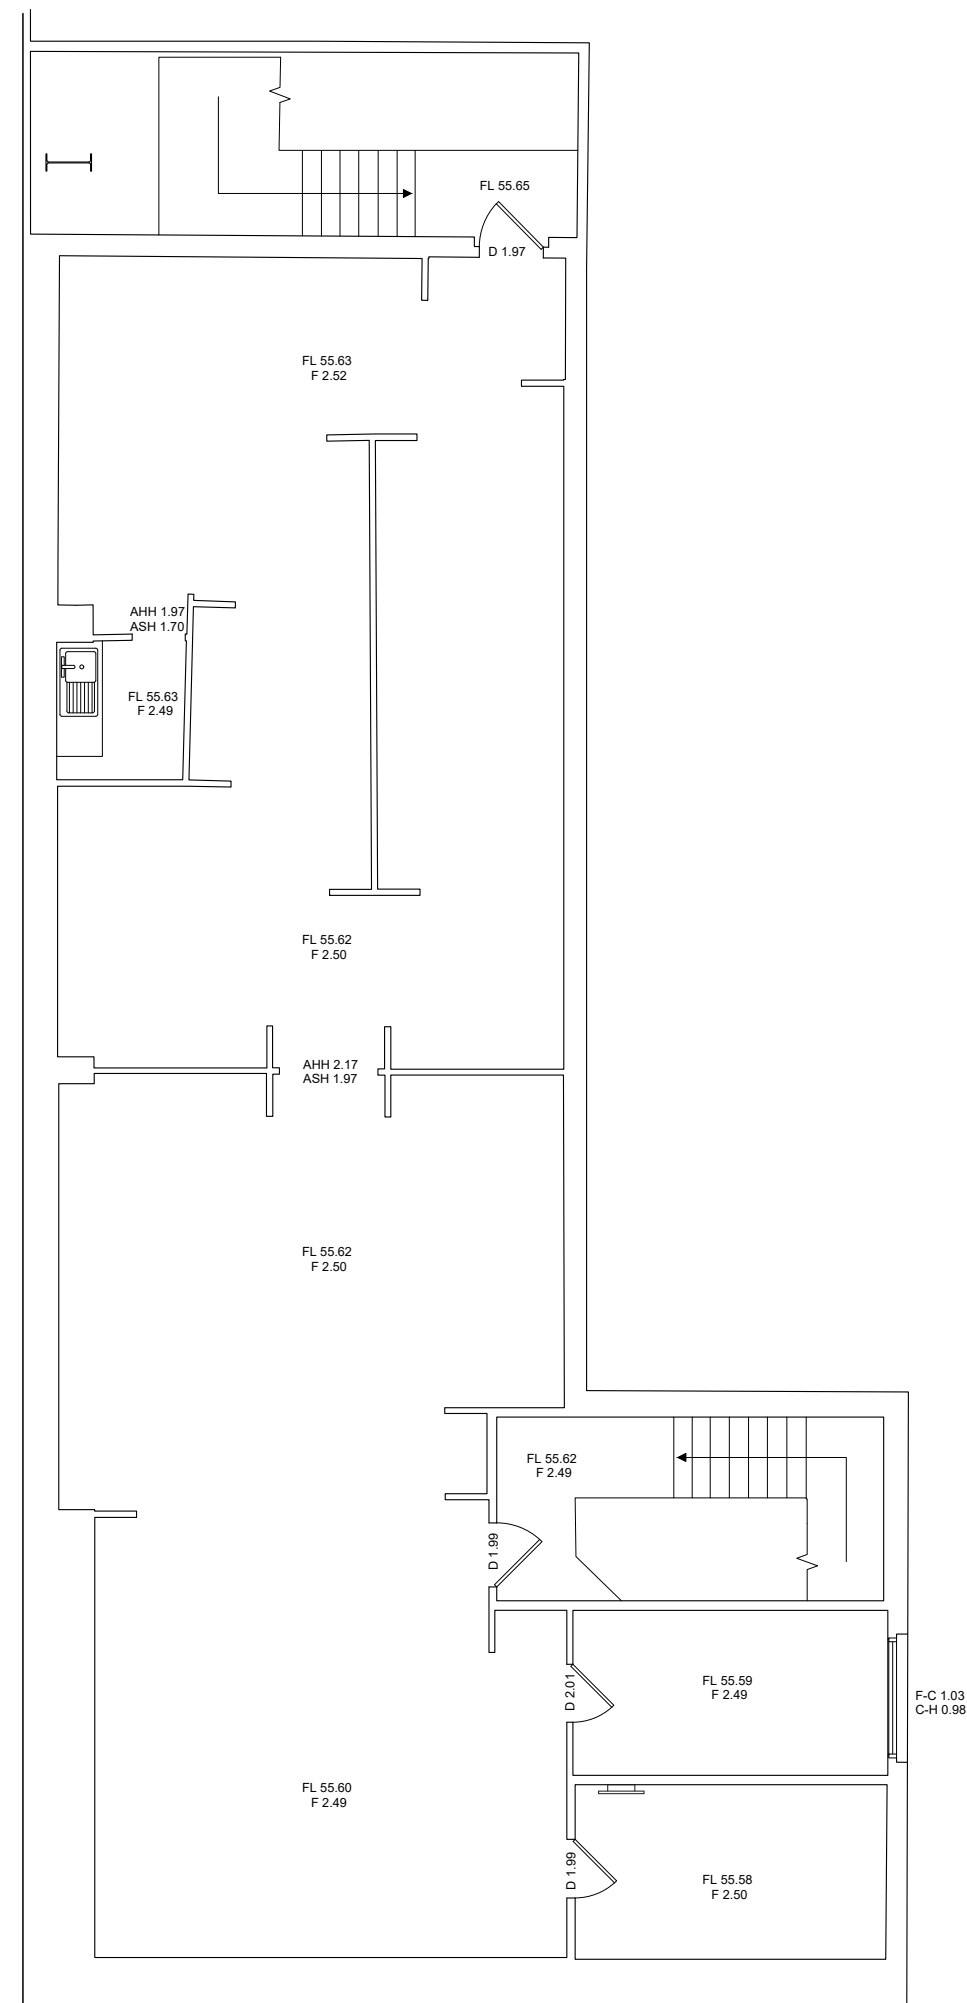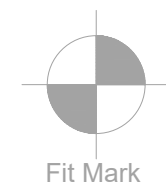

Second Floor

LEGEND

ACCESS HATCH 

AIR CONDITIONING 

A/C CONTROL PANEL 

ALARM SENSOR 

ARCH HEAD HEIGHT 

ARCH SPRINGER HEIGHT 

BEAM HEIGHT 

BELL 

BALKANING PLATE 

BREAK GLASS 

CEILING 

CEILING LIGHT 

CILL TO HEAD 

CLOSE CIRCUIT CAMERA 

DISTRIBUTION BOARD 

DOOR HEAD HEIGHT 

DOOR RELEASE 

DOUBLE SOCKET 

DUCTING 

EMERGENCY DOOR RELEASE 

EMERGENCY EXIT LIGHTING 

EMERGENCY LIGHTING 

EXTRACTOR FAN 

FAN / SUSPENDED CEILING FAN 

FIRE ALARM BELL 

FIRE EXTINGUISHER 

FLOOR TO CILL 

FLUORESCENT LIGHTING 

FLOOR LEVEL 

FUSED SPUR 

HAND DRYER 

HOSE REEL 

HOT WATER BOILER 

INSPECTION COVER 

LINTEL HEIGHT 

LIGHT SWITCH / SINGLE 

LIGHT SWITCH / DOUBLE 

LIGHT SWITCH / TRIPLE 

LIGHT SWITCH / QUADRUPLER 

LOW VOLTAGE SUPPLY 

PHONE / DATA POINT 

PULL CORD SWITCH 

RADIATOR 

RAIN WATER PIPE 

SINGLE SOCKET 

SKYLIGHT 

SLOPED CEILING 

SMOKE DETECTOR 

SERVICE PIPE 

SPLITLIGHT 

SWITCH 


SWITCHED FUSED SPUR 

THERMOSTAT 

UNKNOWN SERVICE 

WALL LIGHT 

Accuracy commensurate with scale of drawing.

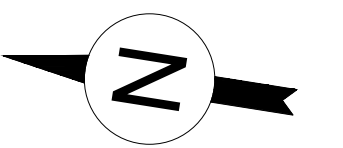

INDICATIVE ONLY



**PAVILION 2
BUCHANAN BUSINESS PARK
GLASGOW
G3 6HZ
TEL: 0141 779 7971
WWW.SIGMA-SURVEYS.COM**

10 LOCKSIDE PLACE
EDINBURGH PARK
EDINBURGH
EH12 9RG
TEL: 0131 202 7861
QUOTES@SIGMA-SURVEYS.COM

SURVEYED	R. RENNIE	SCALE 1:100 (A1 Sheet)
DRAWN	R. RENNIE	
CHECKED	J. ROMAN	

CBRE

8 ASHTON RD, RUTHERGLEN, GLASGOW

MEASURED BUILDING SURVEY
FIRST & SECOND FLOORS

Job No.	Drawing No.	Date	Revision
20/269	20/269/01B	May 2020	

REVISION	NOTES	DATE
----------	-------	------

Notes:

- Grid is arbitrary.
- All levels are to a local datum.



DroneSafe