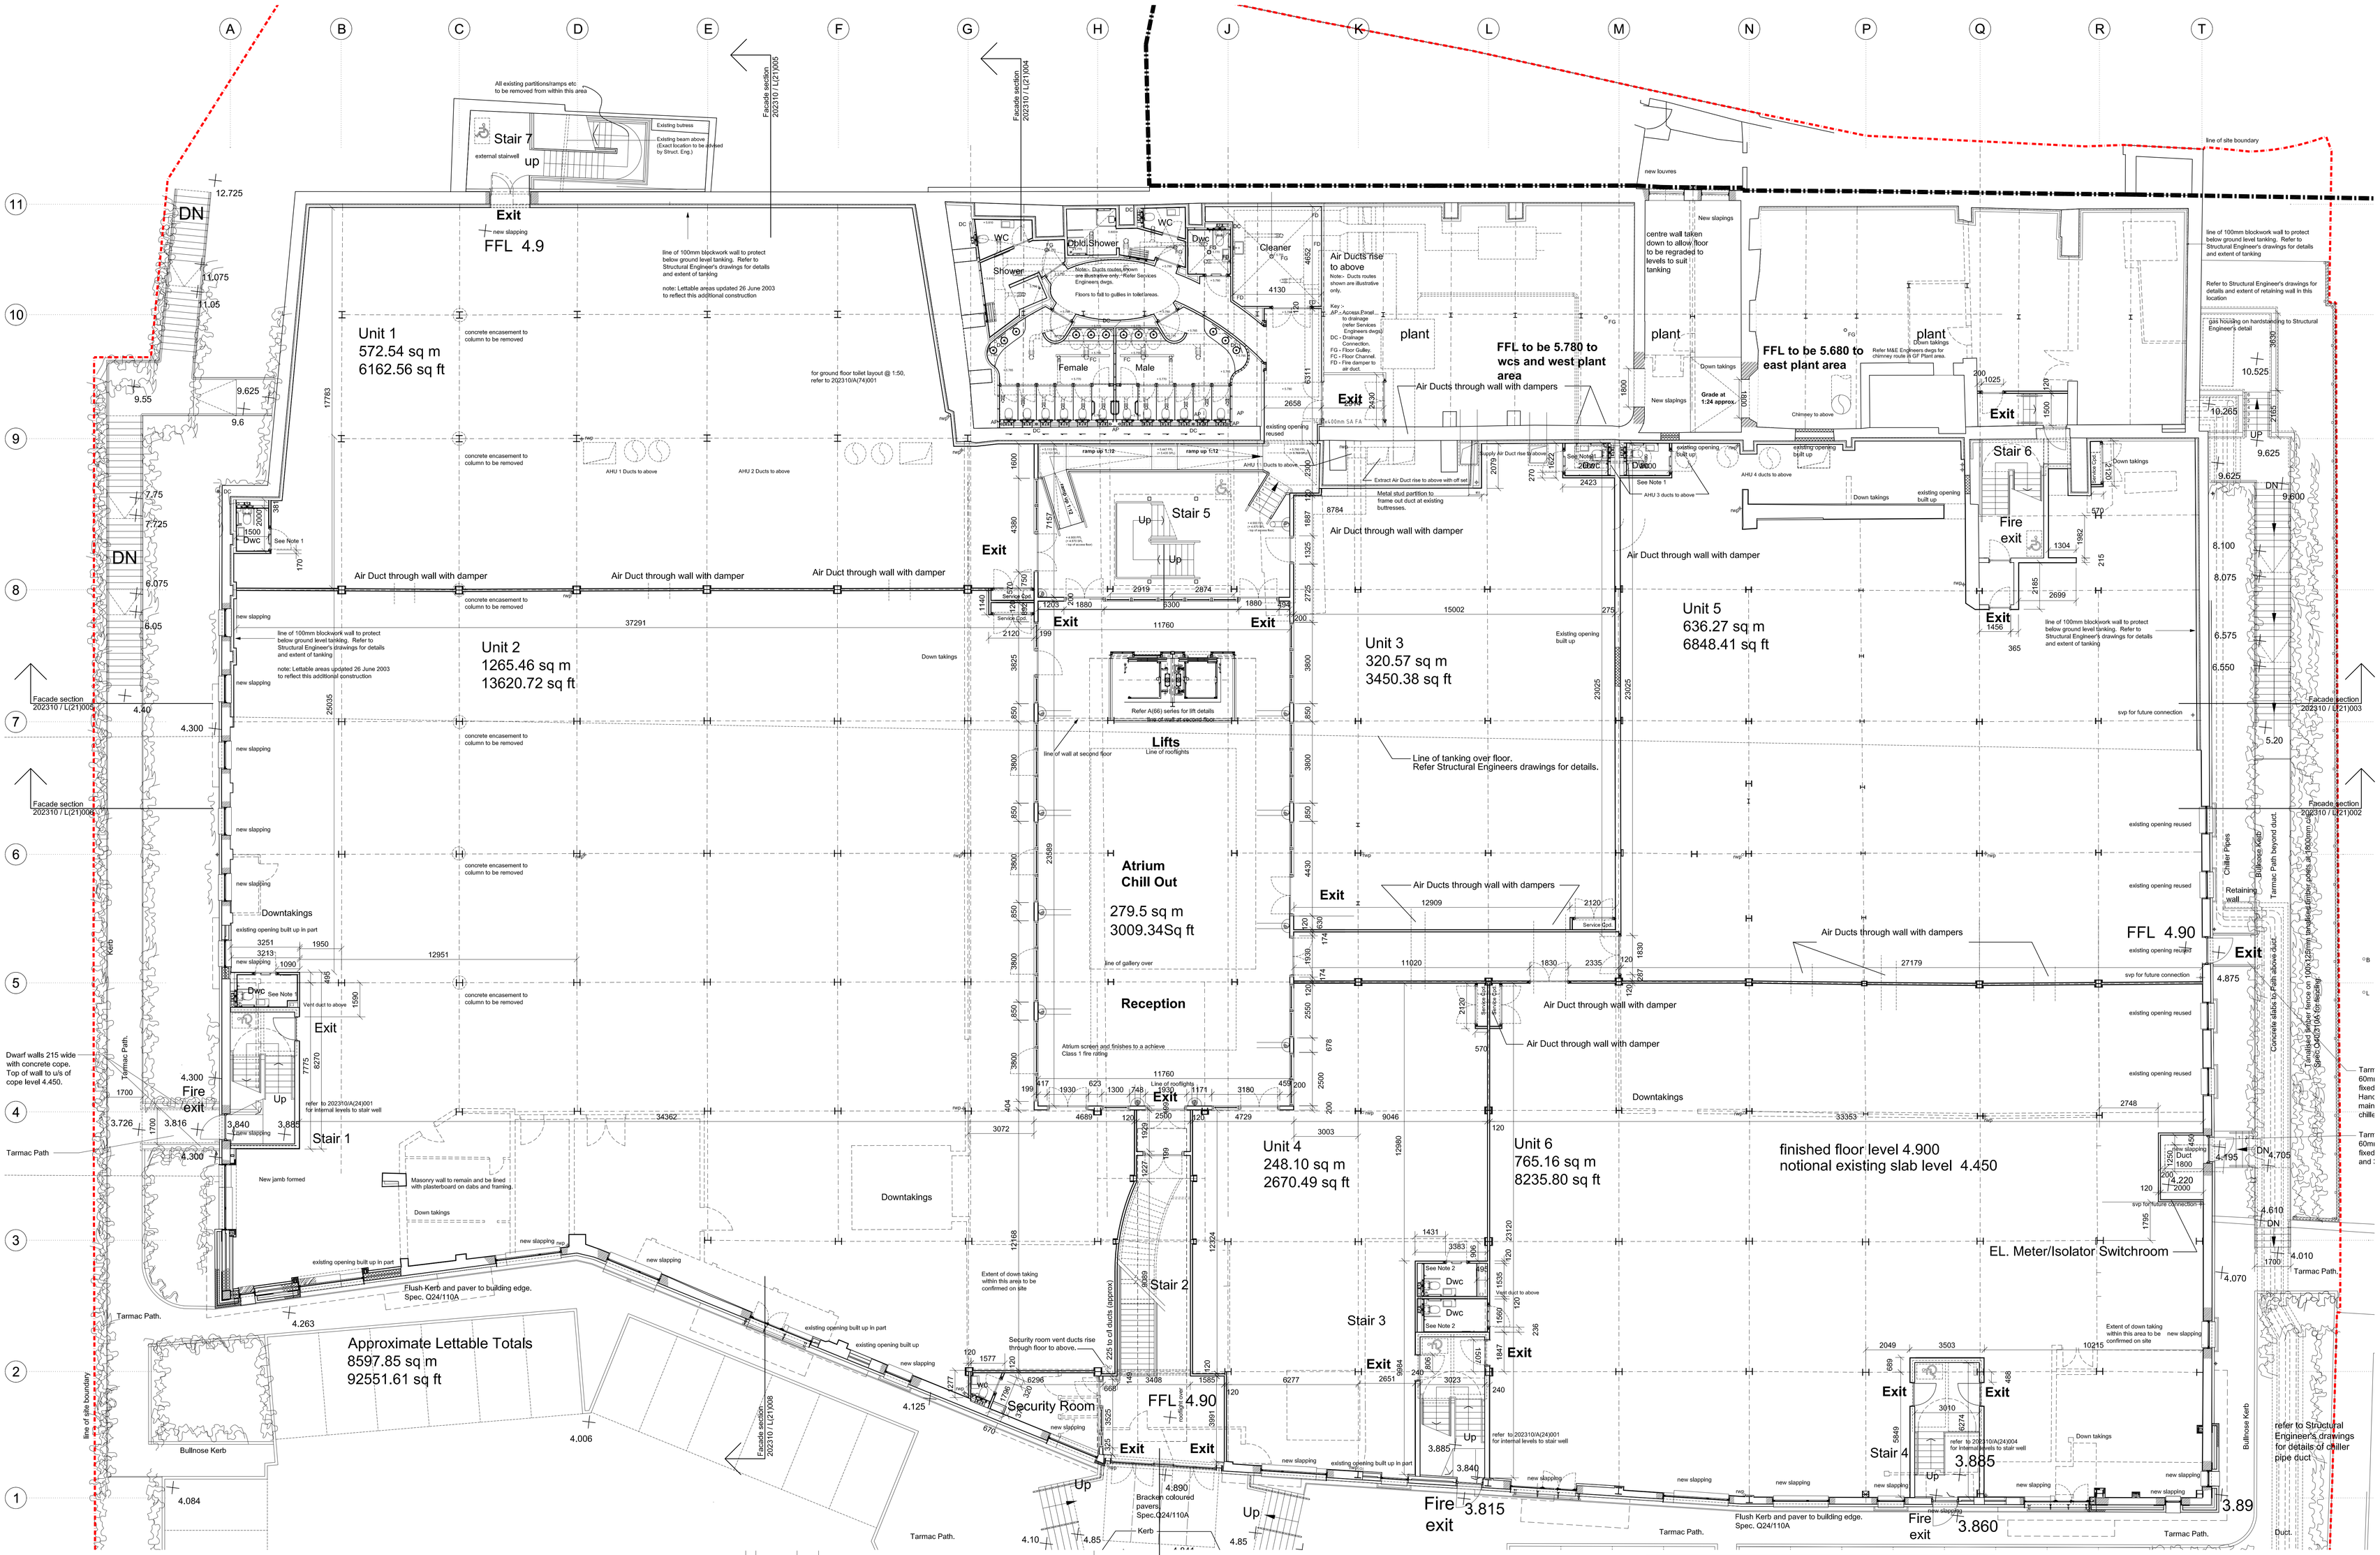

Disabled WC Notes:-

1 - Refer A(74)011 for typical setting out details. Geberit frame fixed back to block per typical detail on A(74)005.

2 - Refer A(74)011 for typical setting out details. Geberit frame fixed within wall framing per typical detail on A(74)005.

All drawings to be read in conjunction with General notes drawing L(100)001 and the specifications.

refer to 202310/L(20)006 for extent of downtakings & repairs to existing building.

Supply a plywood access panel screw fixed with stainless steel cups and screws. Sized to suit where access to service hand access etc required. Allow for facings around frame to suit.

Q	08/03/05	amcl	FINAL CONSTRUCTION ISSUE FOR HEALTH & SAFETY FILE
~	Date	ID	Description

Revisions

P	27/10/04	amcl	Approx. total areas revised, vent duct route to security room confirmed. South atrium wall moved 50mm north to allow flush face across columns. Unit 6 service cupboard relocated at the request of Curzon.
N	30/09/04	amcl	Service cupboards & areas revised, double wall at toilets to allow flush face for tiles
M	09/08/04	amcl	ISSUED FOR CONSTRUCTION Chimney location revised. South steps revisions per RFI 145 (14-07-04) & stair 1 revision due to ground beam per fax 17-06-04. Centrel GF plant area updated per site tanking details.
L	02/06/04	amcl	ISSUED FOR CONSTRUCTION Disabled wc rails, IPS and sanitoryware updated to suit interior design and setting out. Same to security room wc. Correct wh added to shower wc's. Lift front plasterboard revised and wall line and duct route at unit 3. East stair btm level and no of risers corrected. Duct rises revised to suit IPS.
K	22/04/04	amcl	ISSUED FOR CONSTRUCTION Chiller duct & pipe route revised. Gas housing area revised. Electrical meter and isolator room relocated and window omitted where door re-located to. Toilet layouts revised. Ramp and steps to toilets revised. Pier in unit 2 retained.
~	Date	ID	Description

Revisions

Refer to 202310 / L(90)001 for site layout

J	11/03/04	amcl	RE-ISSUED FOR CONSTRUCTION WC relocated to suit drainage, lift and el. meter room revised.
H	19/02/04	amcl	RE-ISSUED FOR CONSTRUCTION Additional setting out dimensions added. External fibre optic lights omitted. Eastern boundary fence revised.
G	08/12/03	amcl	RE-ISSUED FOR CONSTRUCTION Atrium screen layout revised and ventilation diffusers added. Lift note added. Toilet entrance feature added. Stair 5 moved east by 50mm.
F	18/08/03	amcl	ISSUED FOR CONSTRUCTION Levels to north plant area shown, ductwork & reg locations revised, south windows locations matched and revised as required to match elevations, Stairs updated to match detailed stair layouts. Unit areas updated. Guilles added to Plant room. Moveable wall omitted. Meter room added.
E	26/06/03	MD	ISSUED FOR TENDER ADDENDUM Indicative M&E services shown. Dimensions added. Location of gas housing shown. Lettable areas updated. Atrium screen note added. Wall to plant area retained in part. Security room added
~	Date	ID	Description

Revisions

D	10/06/03	scj	ISSUED FOR TENDER Stair 2 & 4 updated. Swing of openable screens to atrium altered Down takings & notes added. Carpark levels altered in accordance with Structural Engineer's drawing, note added. Balcony over main entrance and support structure omitted. Entrance canopy outline shown. Stair 7 updated north door widened. Toilet layouts updated to west and east paths DRAWING ENLARGED TO 1:100 @ A0
C	19/03/03	mcl	Toilets up-dated, stair 2,5,6 & ramp & lift location revised. Area total up-dated
B	03/03/03	scj	Column layout to Structural Engineer's detail. Stair layouts updated generally Exit door to stair 6 repositioned. Lift general arrangement added Glazed screen between stair 5 and atrium repositioned Fire exit door widened at stair 7. Fire exit door shown in east facade wall from unit 5. Sanitary accommodation note added. Grid refs added West pedestrian path amended. Generator housing added Note re smoke ventilation removed. Built up openings to external wall shown
A	11/02/03	MD	Fire exit added, lobby to fire escapes added, disabled refuged added. Lift arrangement and floor opening to atrium revised, indicative drainage gog-ups added. Existing columns to atrium shown. Tanking protection and note added levels adjusted to stairwells 1, 3 & 4
~	Date	ID	Description

Revisions

STATUS OF DRAWING	Init.	Rev.	DATE	
PRELIMINARY DRAWING				
PLANNING ISSUE				
BUILDING WARRANT ISSUE				
FOR BILLING PURPOSES				
FOR TENDER PURPOSES				
FOR CONSTRUCTION				
FOR HEALTH & SAFETY FILE	amcl	Q	08/03/05	✓

keppie
architecture
interior design
planning

ISSUING OFFICE
76, Tay Street
Perth, PH2 8NN
TELEPHONE / FAX
Tel: 01738 631 551
Fax: 01738 626 618
EMAIL / INTERNET
perth@keppiedesign.co.uk
www.keppiedesign.co.uk

JOB TITLE
Seabraes Mill
Dundee
CLIENT
P4 Property Holdings Ltd
DRAWING TITLE
Ground Floor Plan

SCALE 1:100 @ A0
ORIGINAL A0
DATE 22/01/03
DRAWN AMcL
JOB NUMBER 202310
CHECKED AM
DRAWING NUMBER L(20)001
REVISION Q