

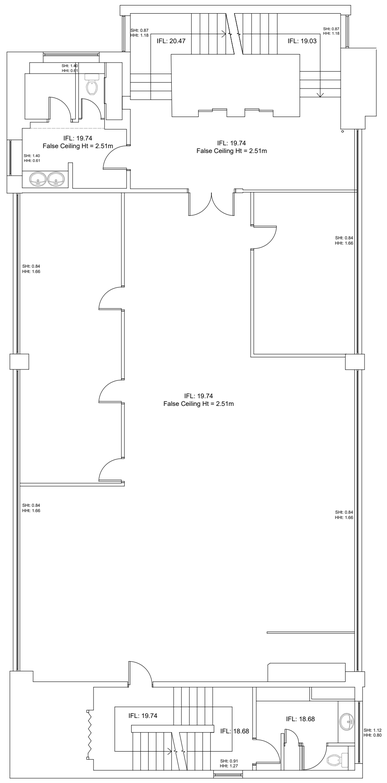



EXISTING THIRD FLOOR

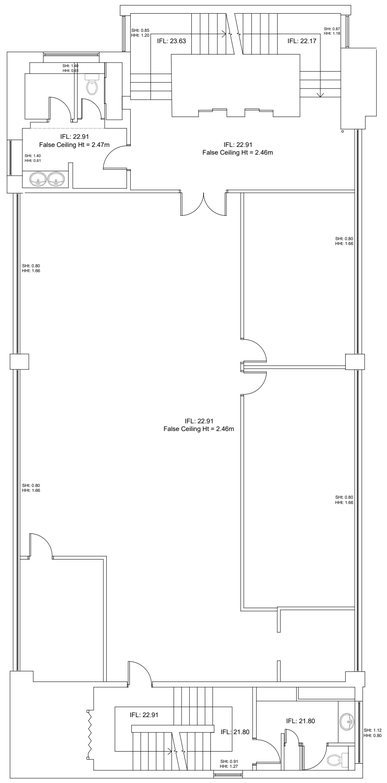


EXISTING FOURTH FLOOR

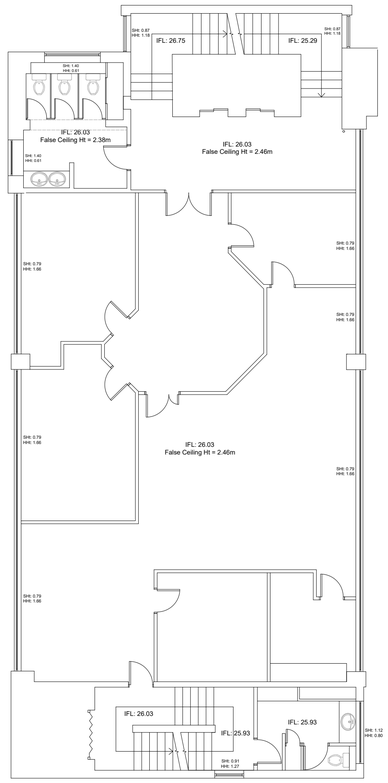

EXISTING FIFTH FLOOR

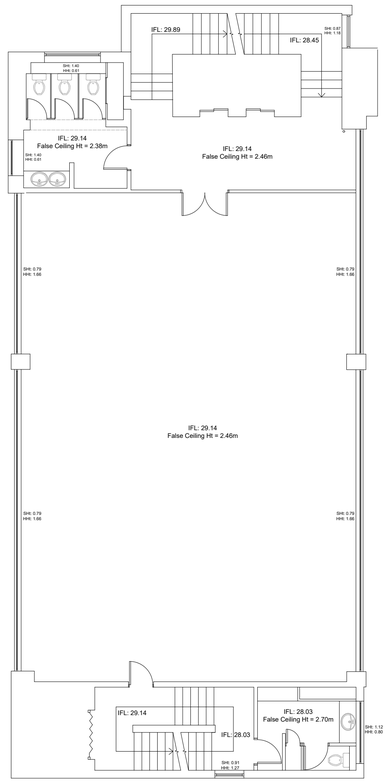

EXISTING SIXTH FLOOR

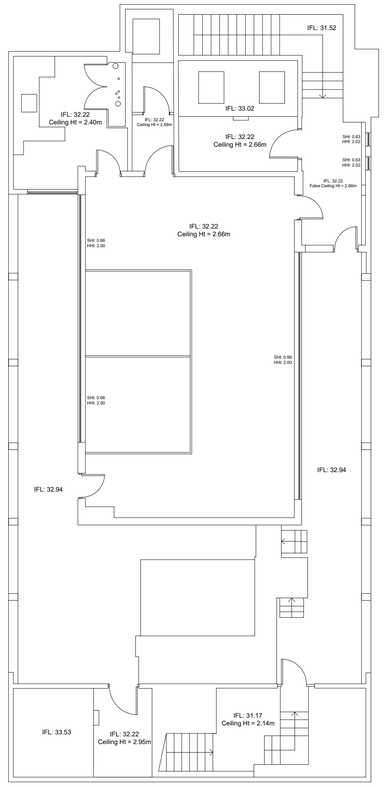

EXISTING SEVENTH FLOOR

- L E G E N D -

DHt - Door Height
DWt - Door Width
IFL - Internal Floor Level
SHt - Floor to Sill Height
HHt - Sill to Head Height

ACAD DESIGN & SURVEYS

ARCHITECTURAL DRAWING SERVICES / 3D SCANNING SURVEYS / FULL MEASURED BUILDING SURVEYS
TOPOGRAPHICAL SURVEYS / UAV DRONE SURVEYS / ALL GENERAL CAD DESIGN
SETTING OUT SERVICES / LRC LEASE PLANS / EPC ENERGY SURVEYS

TEL - 0161 710 2861 - Email - info@acad-design.com - w ww.acad-design.com

DRAWING TITLE
EXISTING MEASURED BUILDING SURVEY

ADDRESS
HILTON HOUSE, LORD STREET, STOCKPORT, SK1 3NA

CLIENT
NADIR KHAN / NK ARCHITECTS

PROJECT
HILTON HOUSE

DRAWN BY	SCALE	DATE	DRAWING NUMBER
JW	1/100@A1	01/07/2024	AC20679/04
CHECKED BY	REV.	DRAWING FILE	
PST	.	AC20679	

REV. NO.	DESCRIPTION TO REVISION	REV. BY	DATE