


- bt British Telecom
- cb Control Box
- cl Cover Level
- ctv Cable Television
- dk Drop Kerb
- el Electric
- ep Electricity Pole
- Fh Fire Hydrant
- gu Gully
- gsv Gas Stop Valve
- ht Height
- ic Inspection Cover
- il Invert Level
- lp Lamp Post
- mkr Marker
- o/h Overhead
- pb Post Box
- pxg Pram Crossing
- np Name Plate
- rs Road Sign
- sv Stop Valve
- tb Telephone Box
- tl Traffic Light
- tt Top of Tree
- th Threshold
- tw Top of Wall
- uti Unable to Lift
- vp Vent pipe
- wn Water Meter
- wsv Water Stop Valve

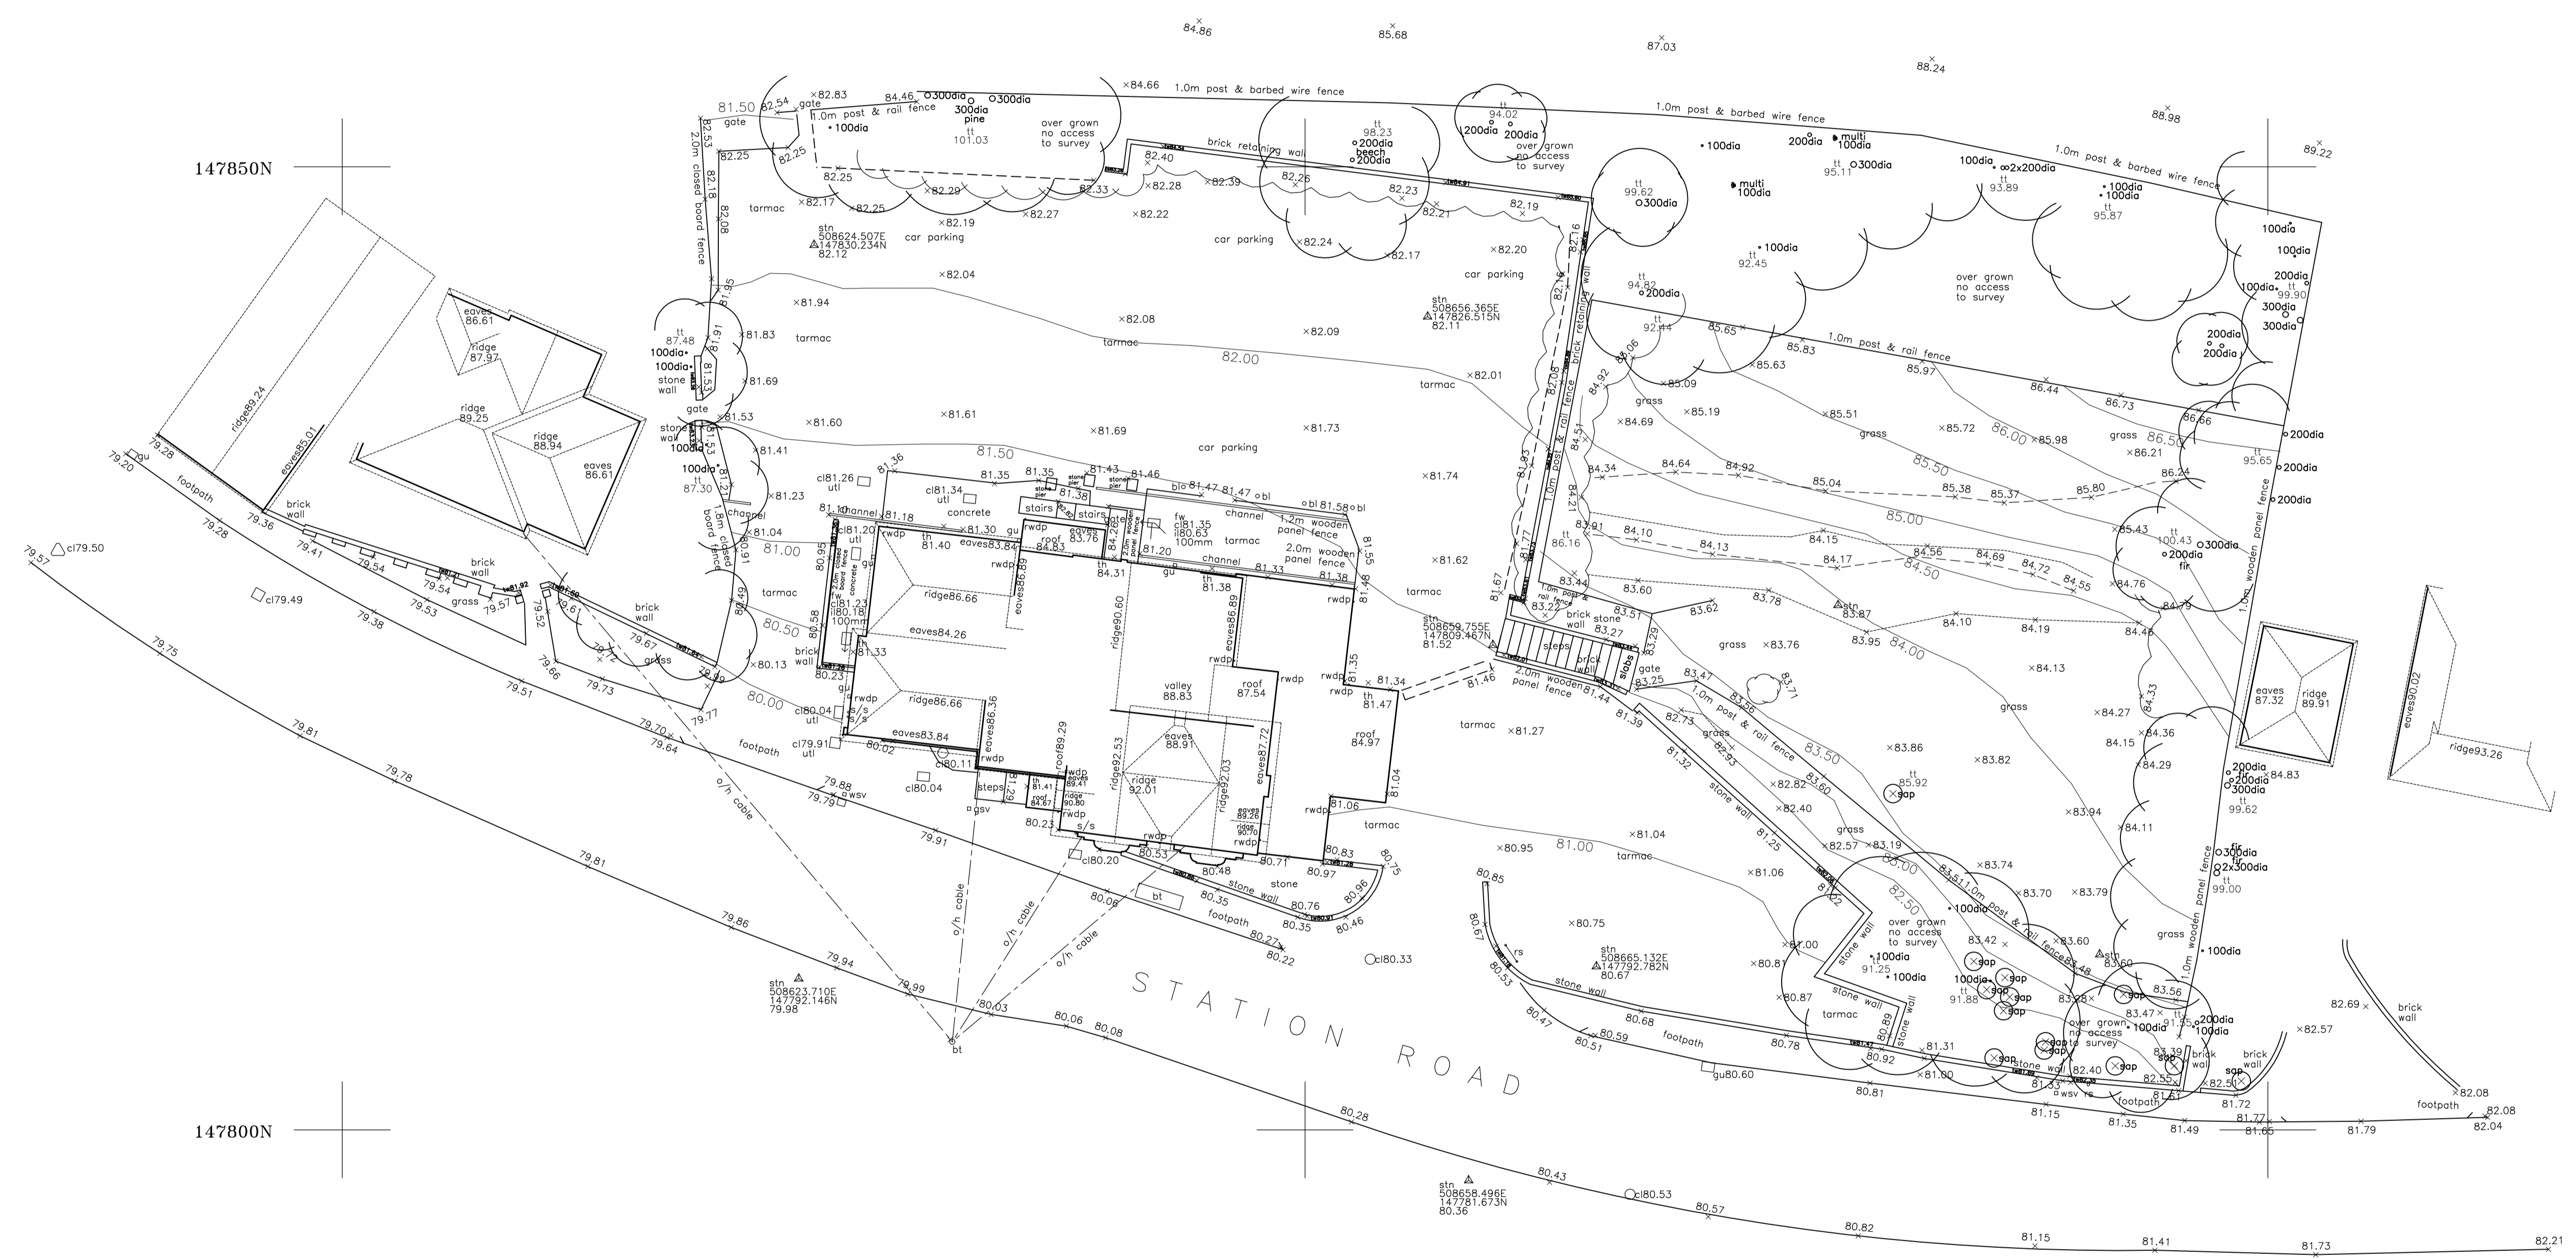

147850N

147800N




NOTES:
 LEVELS RELATE TO O.S. DATUM
 TREE SPECIES SHOULD BE VERIFIED WHERE OF CRITICAL IMPORTANCE
 THE ARCHITECT SHOULD SATISFY HIMSELF THAT ALL TREES LIKELY TO AFFECT HIS DESIGN HAVE BEEN SHOWN
 INTER CONNECTION OF MANHOLES SHOULD BE VERIFIED WHERE OF CRITICAL IMPORTANCE USING CCTV
 PIPE SIZES & INVERTS DETERMINED WITHOUT ENTRY INTO MANHOLE
 ALL DIMENSIONS & LEVELS SHOWN IN METRES
 ON SITE DIMENSION ACCURACY IS TAKEN RELATIVE TO THE PRINTED SCALE AND SHOULD BE CHECKED ON SITE WHERE OF CRITICAL IMPORTANCE

**P STUBBINGTON
 LAND SURVEYS LTD**

THE MEAD
 DURLEY BROOK ROAD
 DURLEY
 SOUTHAMPTON
 HAMPSHIRE
 SO32 2AR
 TEL : 023 8060 1876
 MOBILE : 07973 248165
 EMAIL : PAUL@PSLANDSURVEYS.COM

CLIENT: - RE-FORMAT
 CONTRACT: - STATION ROAD
 GOMSHALL
 GUS 9NP
 TITLE: - TOPOGRAPHIC SURVEY
 SCALE: - 1:200 @A1
 DRAWING NO. 7842/01
 DATE: - JUNE 2019
 SURVEYOR: - RD

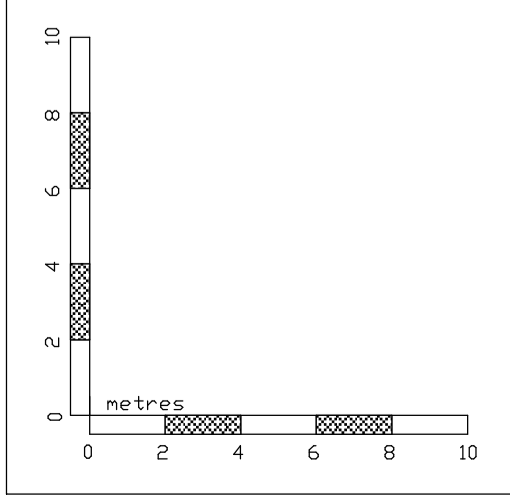

508600E

508650E

508700E