107 fort Road

Approximately 590 ft^2 total

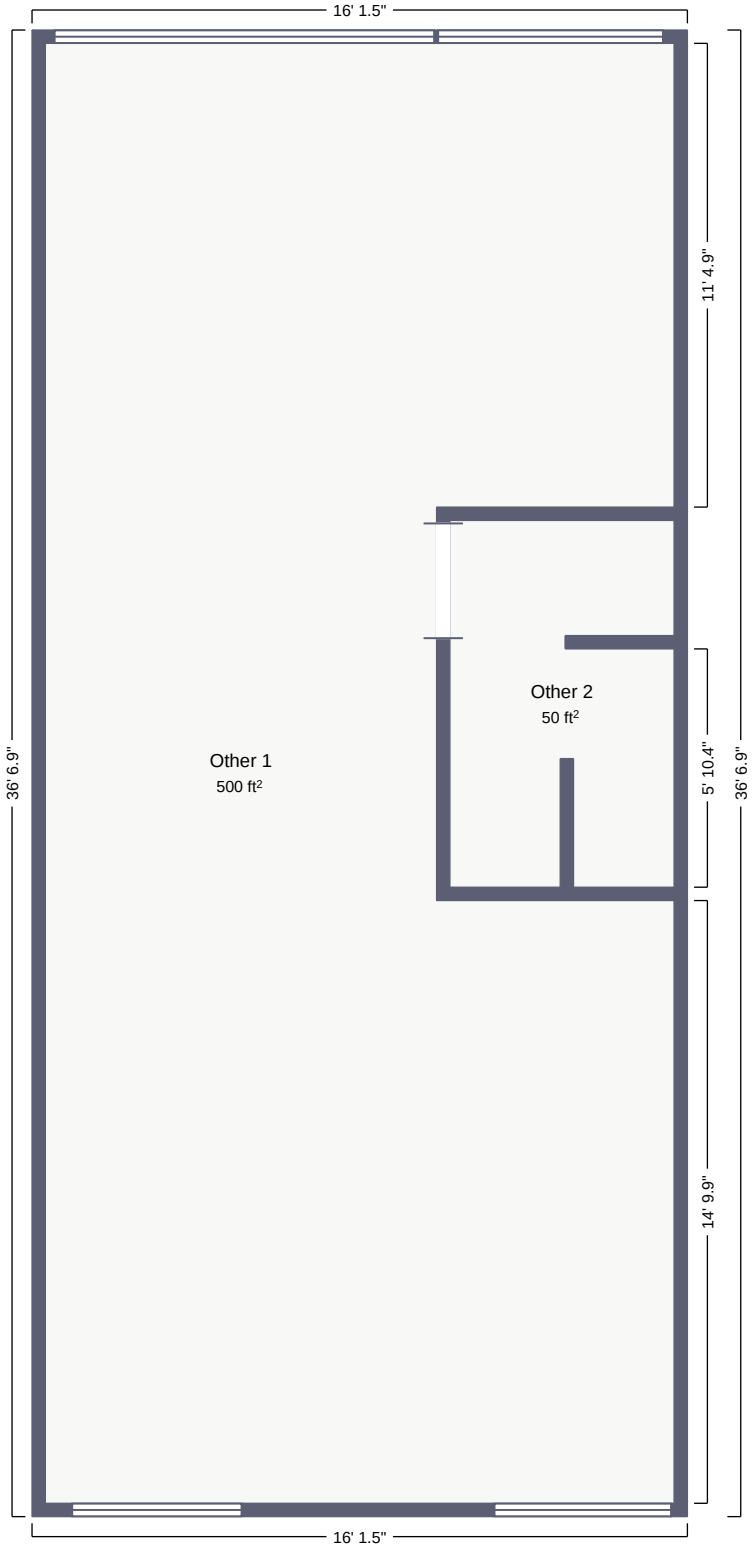

3 ft

Made with Polycam