

REVISIONS

REV	DATE	DESCRIPTION	BY	CHK
P1	08-04-21	Revised layout, following client comments on effect, new wall to be built & effect fits, reduced size of location, altered furniture layout to suit new size.	SC	AR
P2	08-02-21	REFER TO REV/P2 FOR REVISION NOTES.	SC	AR
P3	08-02-21	REFER TO REV/P3 FOR REVISION NOTES.	SC	AR
P4	08-04-21	Revised layout, following client meeting held 24/04/21	SC	AR

REV	DATE	DESCRIPTION	BY	CHK
P4	08-04-21	Revised Layout. Following sheet meeting held 24-03-21: - Updated furniture with 11 items - removed all M&P items from room - Updated furniture office area layout - Updated kitchen area layout to M&P - Stairs - Changed Kitchen Woodwork Room to Content Edit - Relocated lockers from Breakout to Editors - Relocated lockers from Breakout to Editors - Open plan office area - Relocated 
P3	08-02-21	REFER TO REV/P3 FOR REVISION NOTES.	SC	AR
P2	08-02-21	REFER TO REV/P2 FOR REVISION NOTES.	SC	AR
P1	26-01-21	REFER TO REV/P1 FOR FULL REVISION NOTES	SC	-



PROJECT  
1ST FLOOR: GPS - 25 Great  
Putney St, Soho, London  
W1F 9LT


PROPOSED GENERAL  
ARRANGEMENT : OPTION 3

Workplace  
Thinkers  
& Makers™

**Peldon Rose Limited**  
Studio 200, 200 Groppe Road  
London SW18 4LQ  
Telephone 020 8971 7777  
web: peldonrose.com

DATE		SHEET	DRAWN BY
11.12.20		A1	SC
SCALE		FILE REF.	CHECKED BY
1:50 @ A1		/	-
DRAWING NUMBER			
PROJECT NUMBER	FLOOR TYPE	NUMBER	REVISION
EN2718	1	01	P5

This drawing is protected under copyright and all rights should this drawing be reproduced in whole or in part without the permission of Peldon Rose Limited. © COPYRIGHT

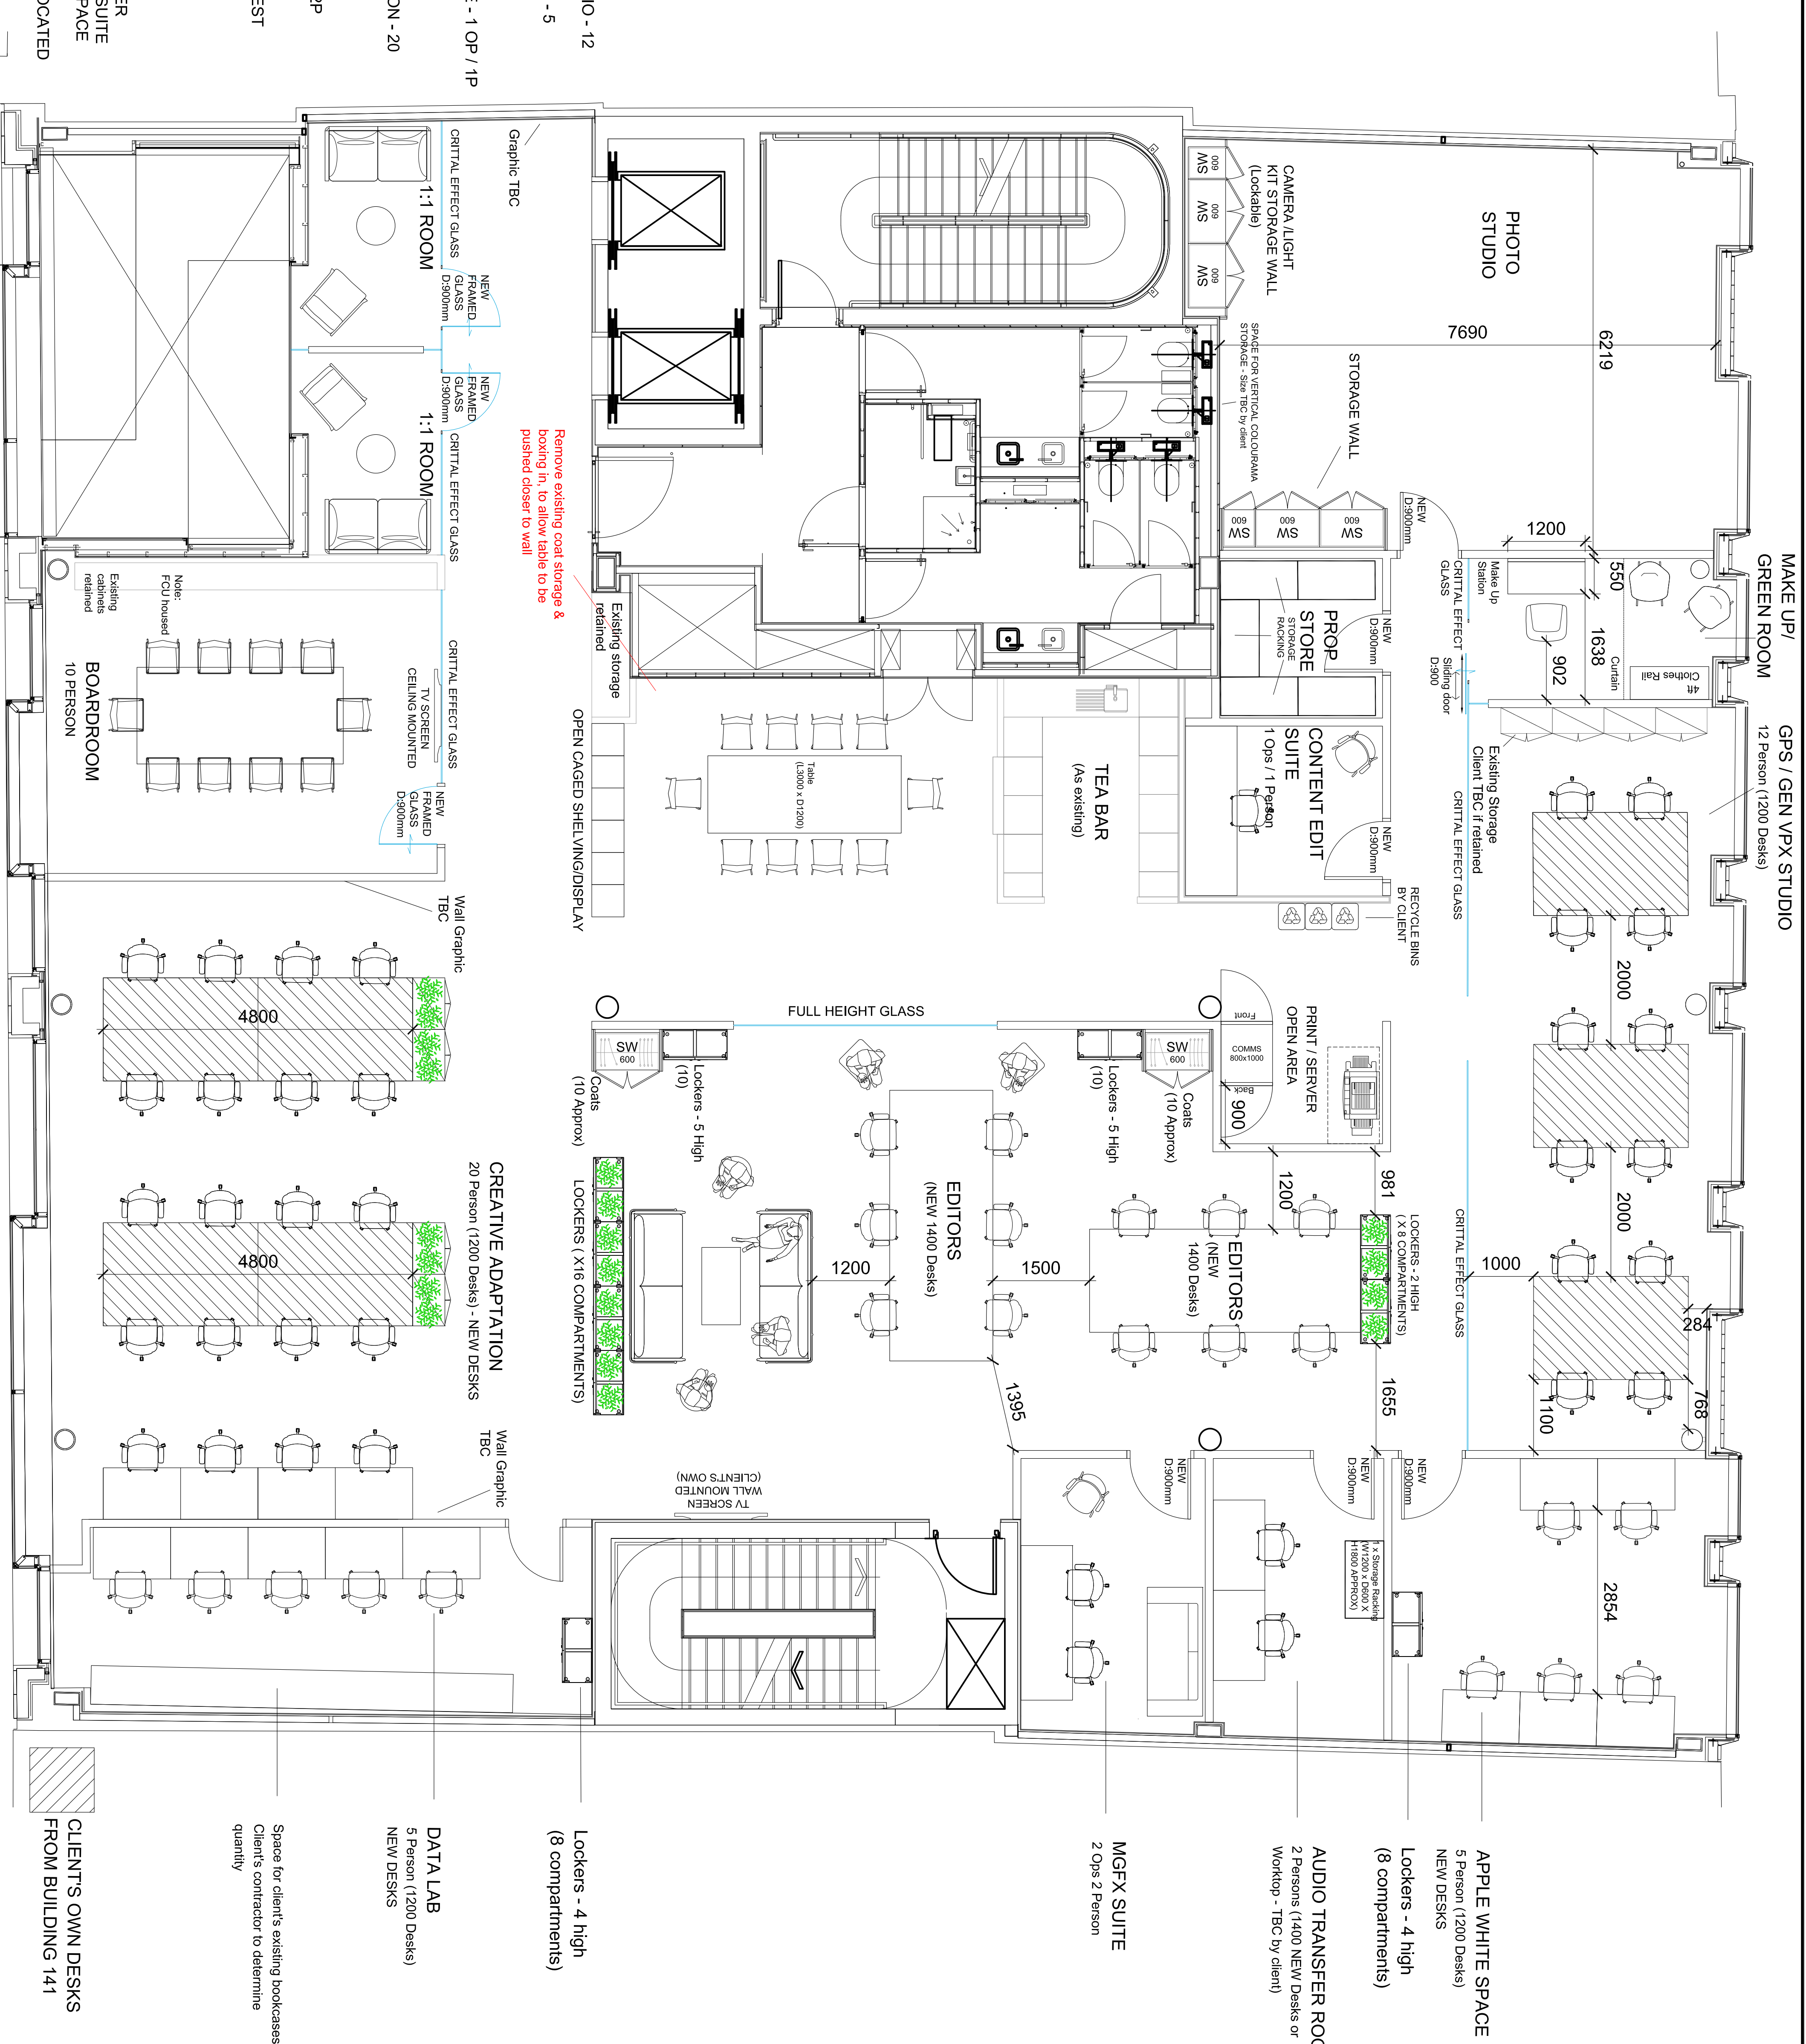

- GPS / GEN VPX STUDIO - 12
- APPLE WHITE SPACE - 5
- AUDIO TRANSFER - 2
- CONTENT EDIT SUITE - 1 OP / 1P
- EDITORS - 12
- CREATIVE ADAPTATION - 20
- DATA LAB - 5
- MGFX SUITE - 2 OP / 2P
- TOTAL - 59 (DOES NOT INCL. GUEST SEATING IN SUITES)
- LOCKERS TOTAL - 60
- 4ANO. OPEN PLAN
- 5NO. DATA LAB
- 2NO. AUDIO TRANSFER
- 1NO. CONTENT EDIT SUITE
- 5NO. APPLE WHITE SPACE
- 2NO. MGFX
- 1NO. EXTRA - UNALLOCATED