
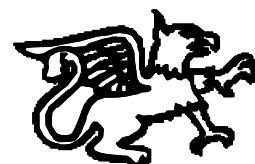


KEY

(n.nn) CEILING HEIGHT
(Fn.nn) FALSE CEILING HEIGHT
USB UNDERSIDE OF BEAM
FC FLOOR TO CILL HEIGHT
CH CILL TO HEAD HEIGHT
DH DOOR HEAD HEIGHT
x 9.99 FLOOR LEVEL
SPR SPRINGER HEIGHT
CRO CROWN HEIGHT

THE ORIGIN AND ORIENTATION OF THE SURVEY
IS ARBITRARY.

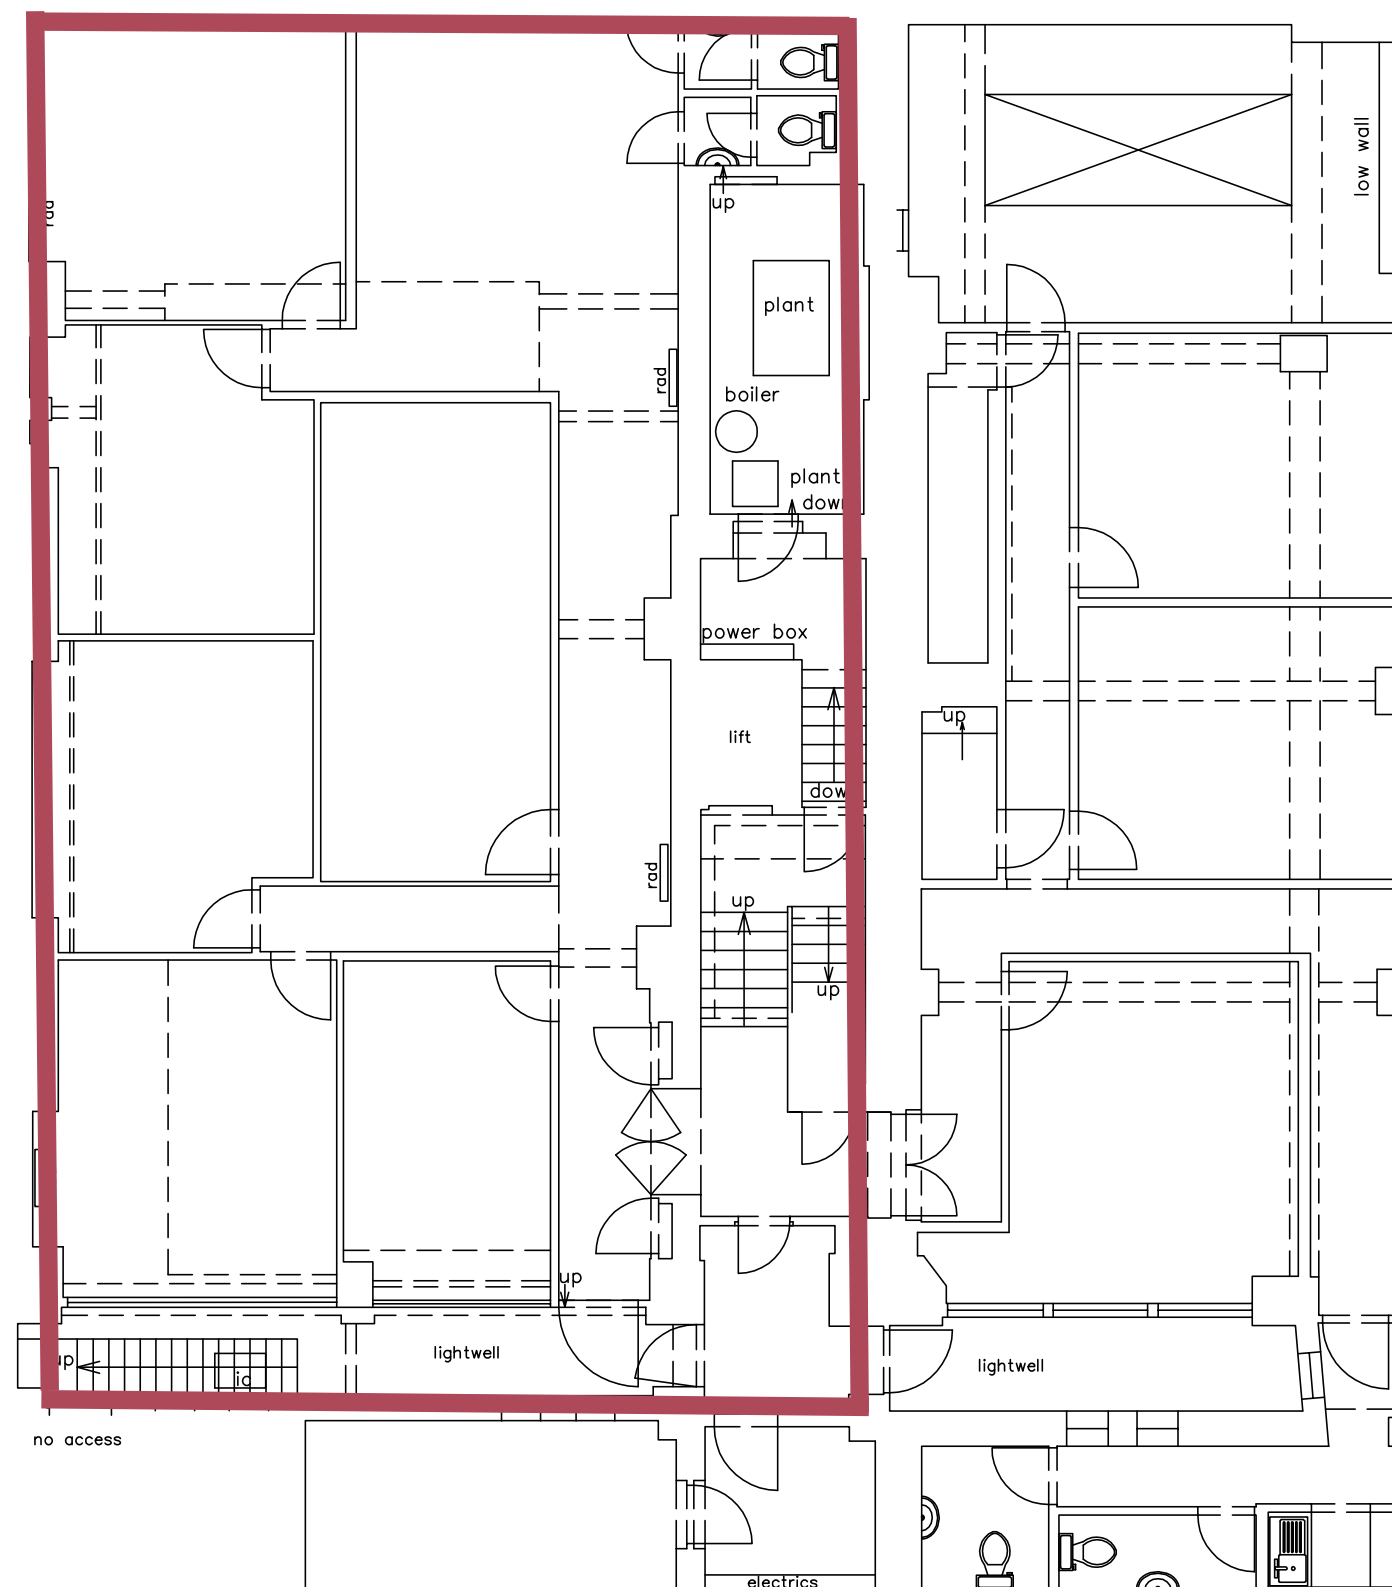

GRYPHON SURVEYS

Hanover House
78-82 High Street
Brentwood, Essex CM14 4AP
Telephone: 01277-212794
Fax: 01277-214928

e-mail: admin@gryphonsurveys.co.uk
www.gryphonsurveys.co.uk

Project:

KENILWORTH HOUSE
79-80 MARGARET STREET
LONDON, W1

Title:

BASEMENT

Drawn

LR

Checked

Scale

1/100@a3

Date

09/10

Ref:

79/80MS