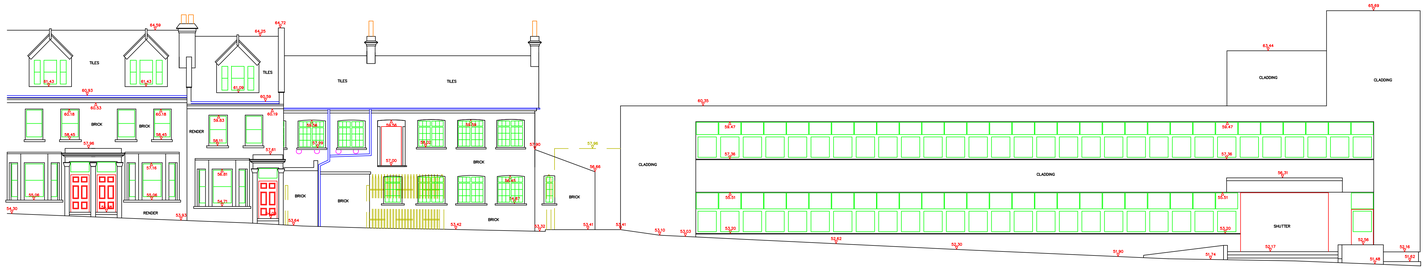

ELEVATION A

DATUM LINE 48.00m

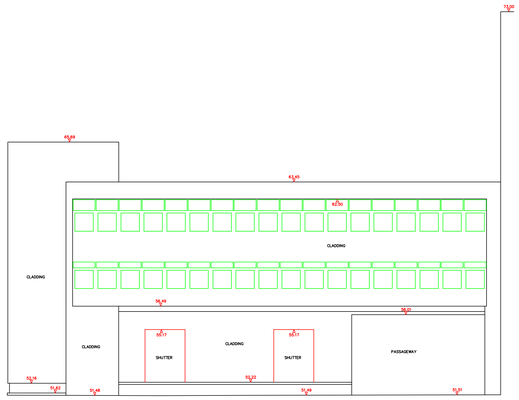

ELEVATION B

DATUM LINE 48.00m

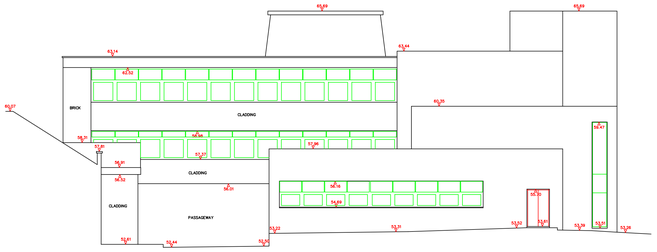

ELEVATION C

DATUM LINE 48.00m

SURVEYED BY:

ENGINEERING LAND & BUILDING SURVEYS
98 MIDDLE STREET
BROCKHAM
SURREY
RH3 7JF

TEL: 01737 844981
FAX: 01737 841540

Job No
B7979

LEGEND

SURVEY STATION

BANKING

HEDGE
FENCE

PROPOSED CELL BOUNDARY

ABBREVIATIONS (WHERE APPLICABLE)

A/C	AIR CONDITIONER		
AH	ARCH HEIGHT	KO	KERB OUTLET
A/V	AIR VALVE	L	LIGHT
B	BOLLARD	LP	LAMP POST
BH	BEAM HEIGHT	MP	MANHOLE
BHI	BEAM SOFFIT HEIGHT	MKR	MARKER
BL	BEAM SOFFIT LEVEL	NB	NOTICE BOARD
BW	BRICK WALL	NFI	NO FURTHER INFORMATION
CH	WINDOW CILL HEIGHT	O/H	OVERHEAD
CE	CLEARING EYE	P	POST
1.90 OF	CEILING HEIGHT OVER FLOOR	PL	PAVEMENT LIGHT
CL	COVER LEVEL	PM	PARKING METER
CM	CABLE MARKER	R	ROOF
CONC	CONCRETE	(R)	FROM RECORDS
CP	CATCH PIT	RG	ROAD GULLY
CPS	CONC PAVING SLABS	RS	ROAD SIGN
D	DEPTH	RSJ	ROLLED STEEL JOIST
DH	DOOR HEIGHT	RW	RETAINING WALL
DP	DOWN PIPE	RWP	RAIN WATER PIPE
E	EARTHING POINT	S	STEPS
ECP	ELEC CABLE JNT	SC	STOP COCK
EJB	ELEC JUNCTION BOX	SKL	SKYLIGHT
EP	ELECTRICITY POLE	SL	SUMP LEVEL
F	FENCE	SP	SPRING POINT
FB	FLOWER BED	SPH	SPRING POINT HEIGHT
FH	FIRE HYDRANT	TC	TELEPHONE IC
FIG	FIXED INTO GROUND	T JB	TEL JUNCTION BOX
FL	FLOOR LEVEL	TL	THRESHOLD LEVEL
G	GRID / GULLY / EARTH	TP	TELEPHONE POLE
GV	GAS VALVE	UNI	UNIVERSAL PIPE
H	WINDOW HEAD HEIGHT OVER FLOOR	U/TL	UNABLE TO LIFT
HB	HAND BASIN	U/TT	UNABLE TO TRACE
HD	HEATING DUCT	VP	VENT PIPE
IC	INSPECTION COVER	W	WALL
IL	INVERT LEVEL	WC	WATER CLOSET
		WM	WATER METER

FENCE TYPES AND DETAILS

B/W	BARBED WIRE
C/B	CLOSE BOARDED
C/I	CORRUGATED IRON
C/L	CHAIN LINK
C/P	CHESTNUT PALING
H/R	HAND RAIL
I/R	IRON RAILINGS
O/B	OPEN BOARDED
P/R	PALISADE
P/W	POST & WIRE
S/W	SHEEP WIRE
W/M	WIRE MESH

NOTES

DATUM USED:

SURVEY CONTROL ESTABLISHED USING GPS

THIS SURVEY DATA HAS BEEN PREPARED FOR THE CLIENT DETAILED BELOW TO AN AGREED SPECIFICATION. UNLESS OTHERWISE AGREED IN WRITING THE LIABILITY OF ENGINEERING LAND & BUILDING SURVEYS IS LIMITED TO THE CLIENT OR HIS APPOINTED AGENT AND DOES NOT EXTEND TO USE BEYOND THE LIMITATIONS OF THE SPECIFICATION.

REV. SUFFIX	DATE	INITIAL	REVISION DETAILS

HORDEN CHERRY LEE ARCHITECTS
36–38 BERKELEY SQUARE
LONDON
W1J 5AE

JOB TITLE
11 BLACKBURN ROAD
WEST HAMPSTEAD
LONDON NW6 1RZ

DRAWING TITLE
ELEVATIONS
SHEET 1

JOB No.		DRAWING No.	
SHEET SIZE A0		REVISION SUFFIX 0	
SCALE 1:100	DATE OCT 2014	DRAWN PRC	CHECKED PRC