




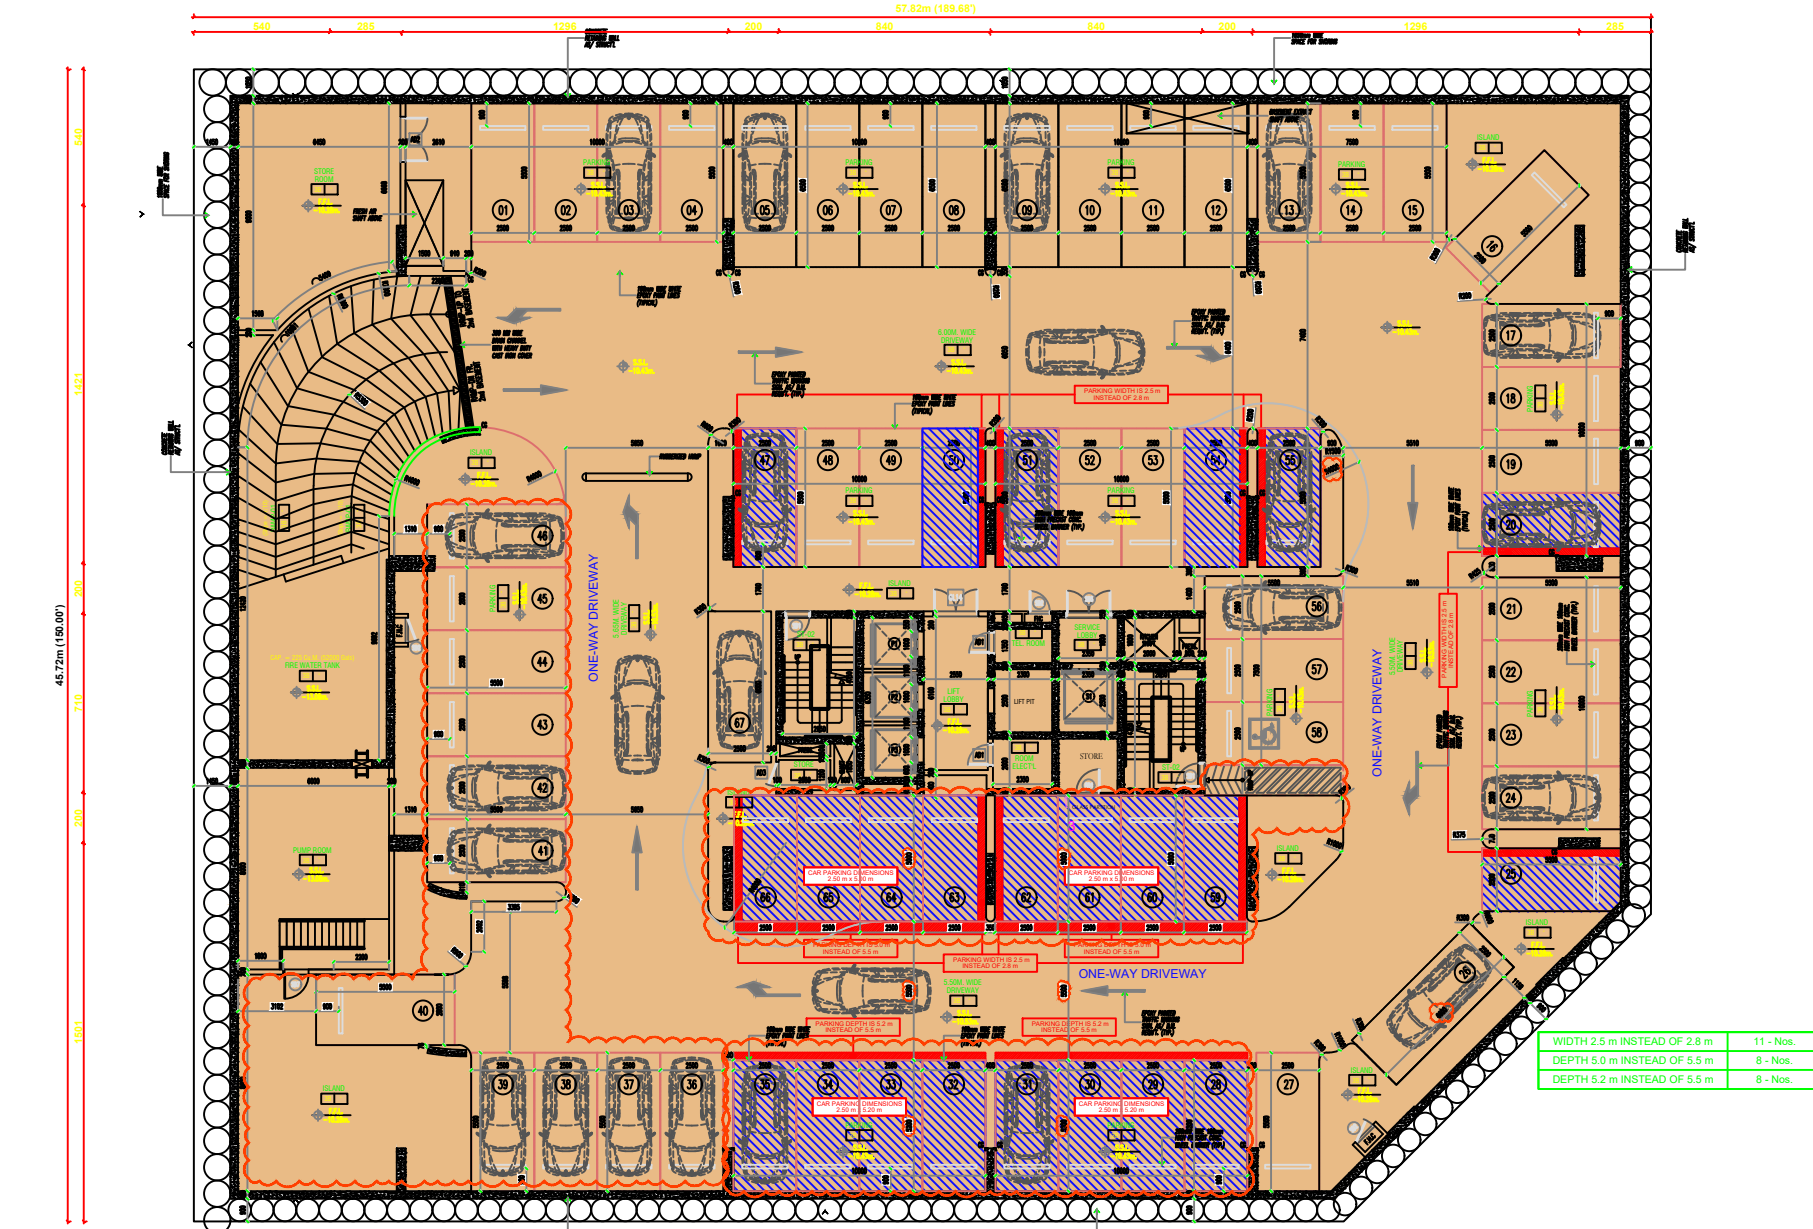


3RD BASEMENT FLOOR
(No. of PARKINGS = 67 Nos.)

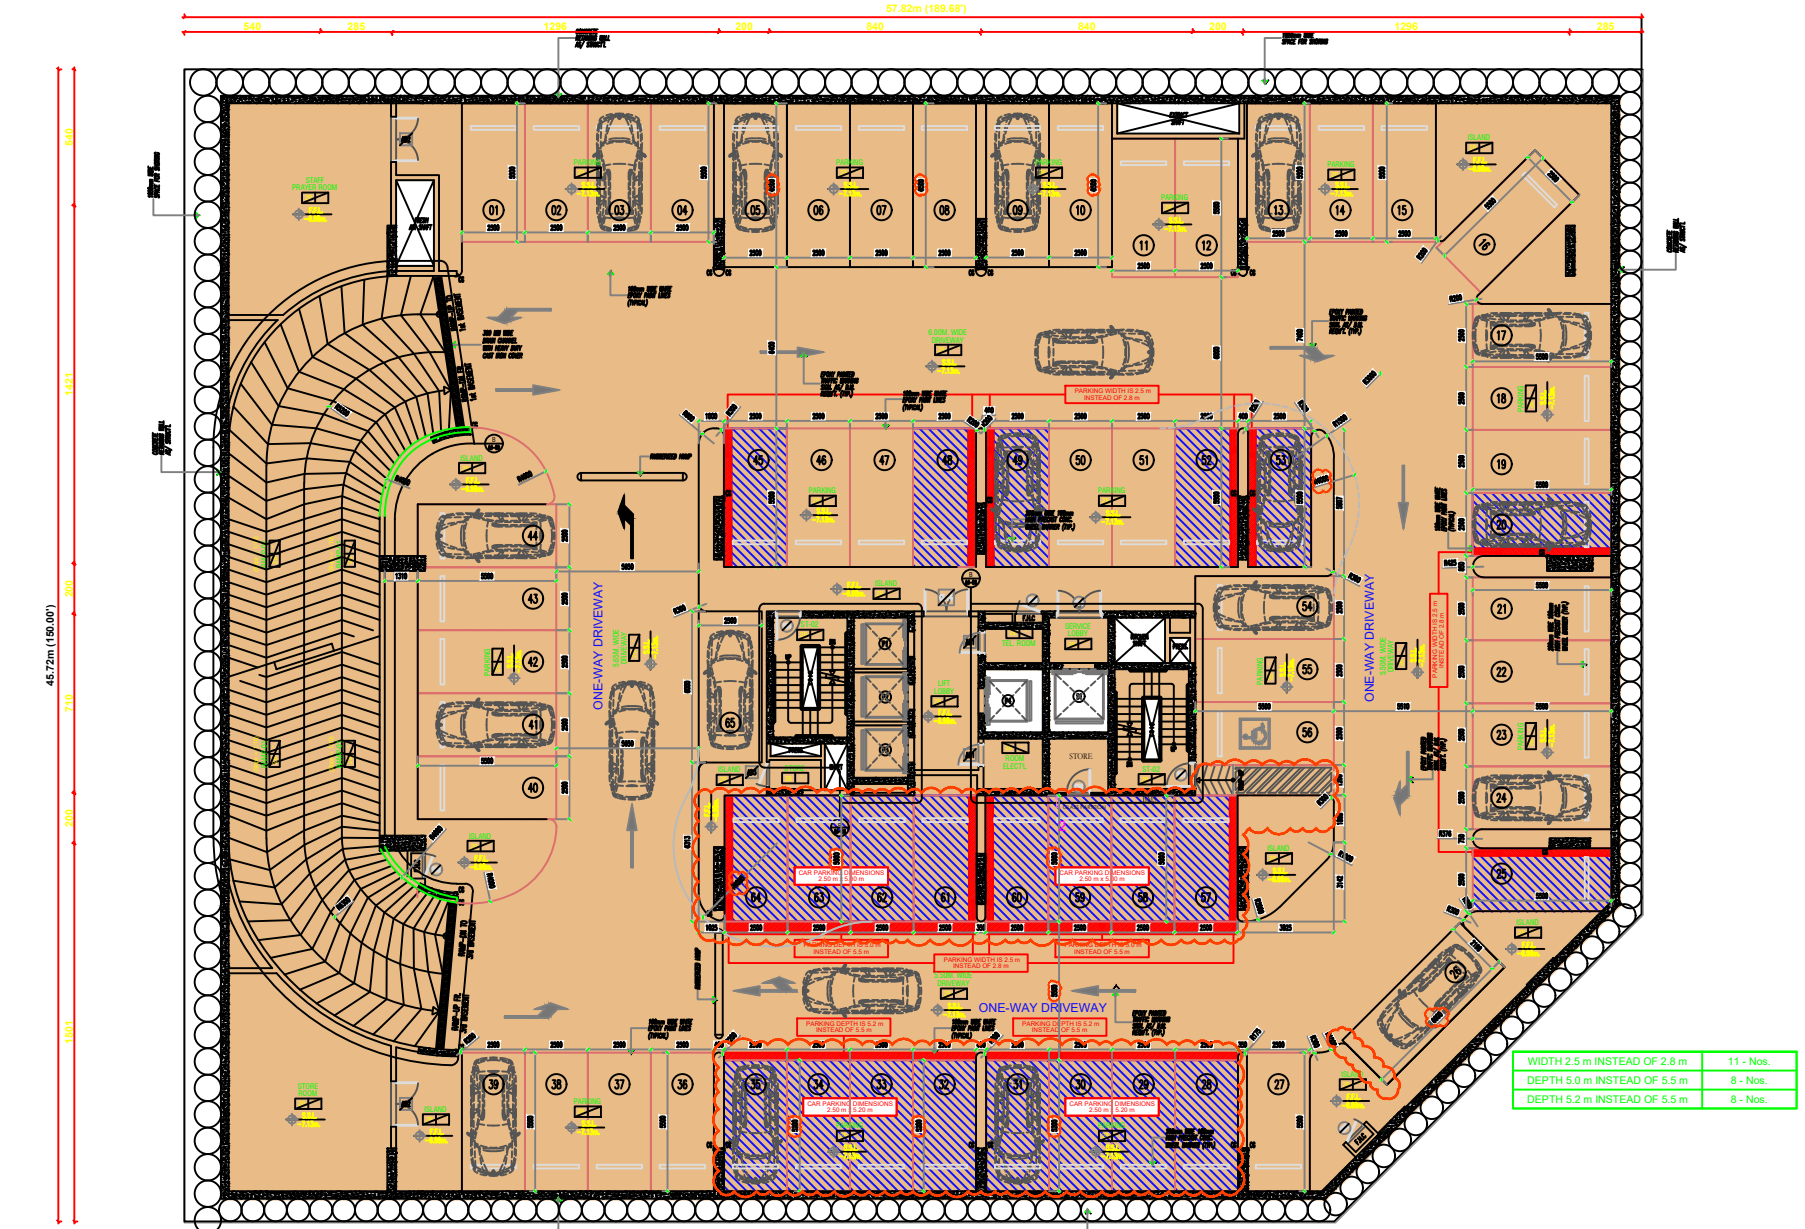


2ND BASEMENT FLOOR
(No. of PARKINGS = 65 Nos.)

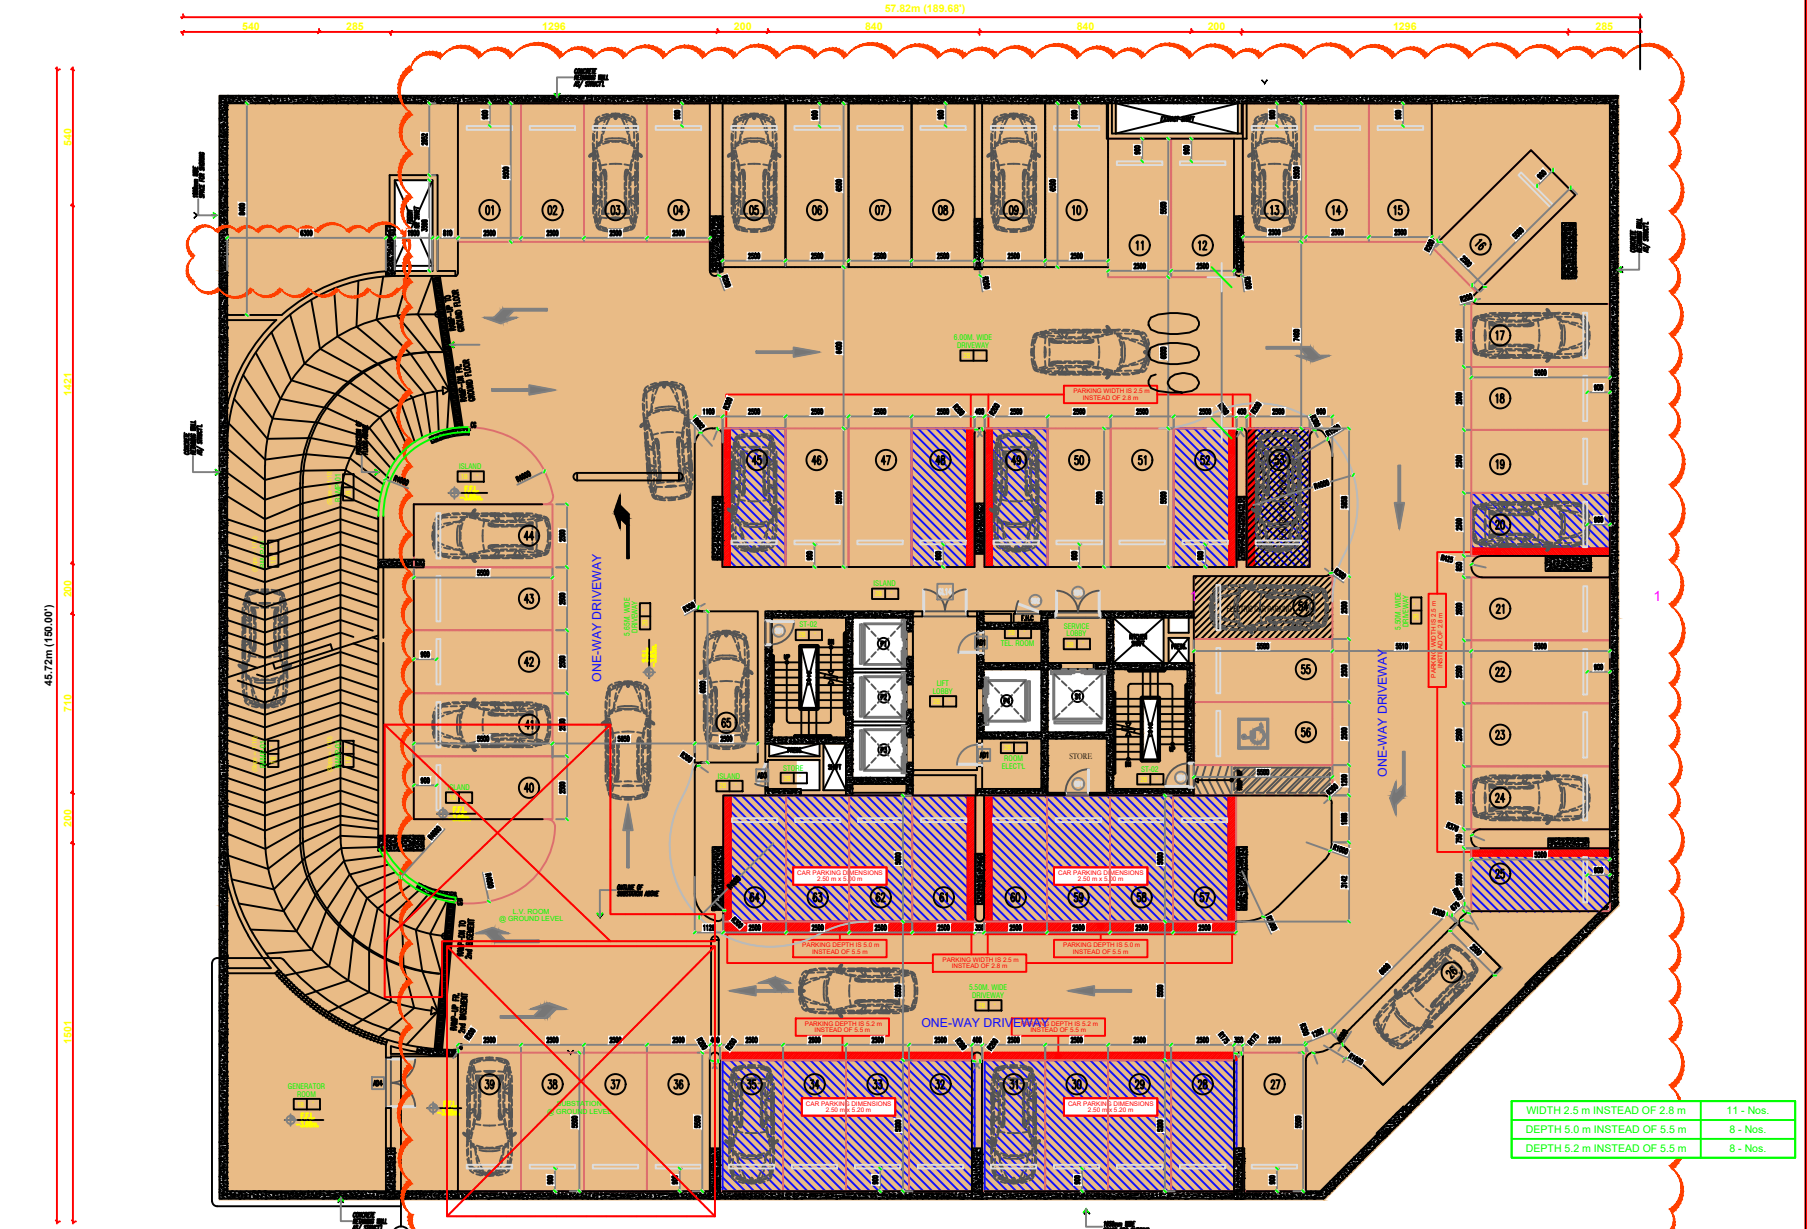


1ST BASEMENT FLOOR
(No. of PARKINGS = 65 Nos.)

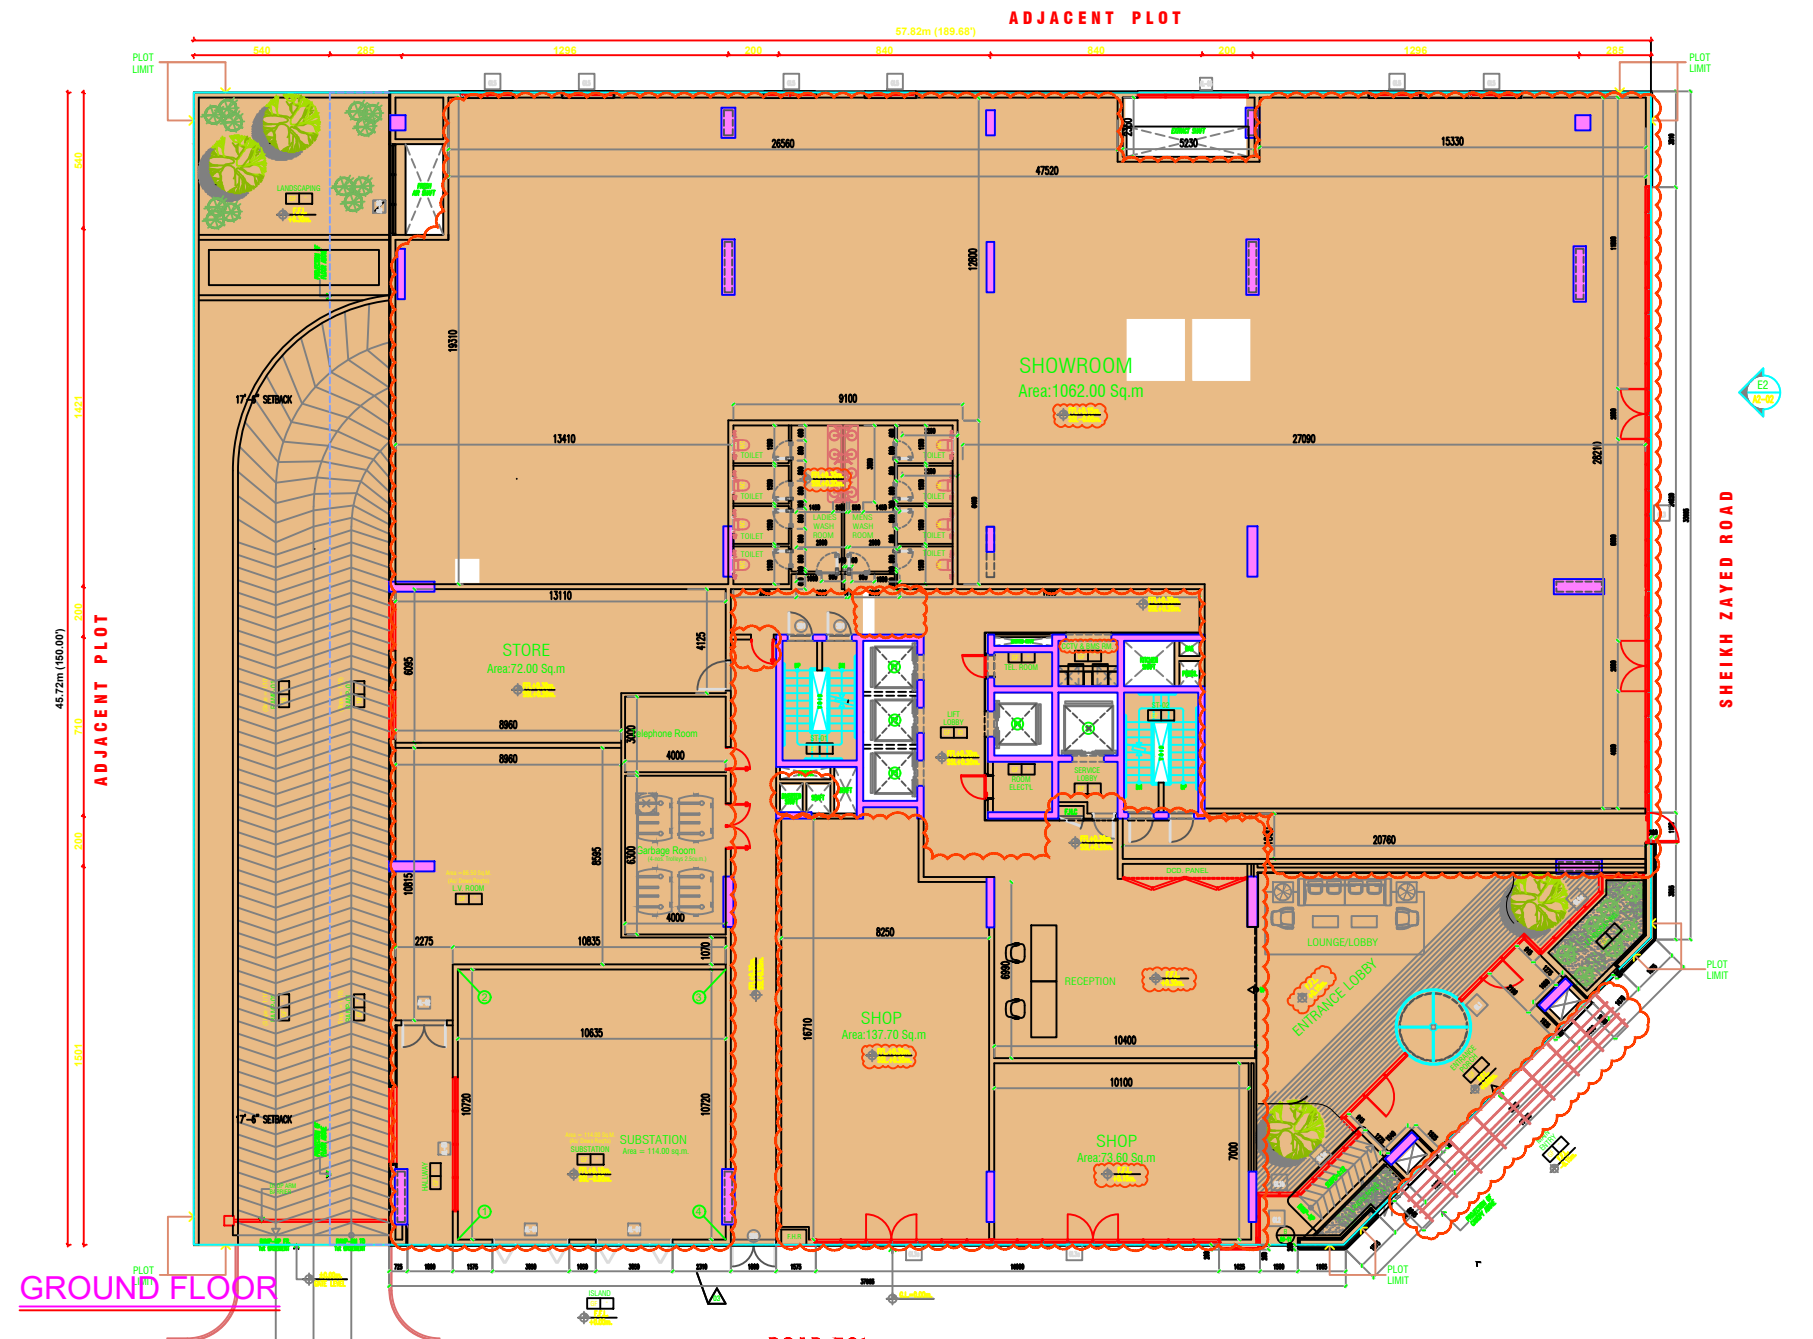

GROUND FLOOR

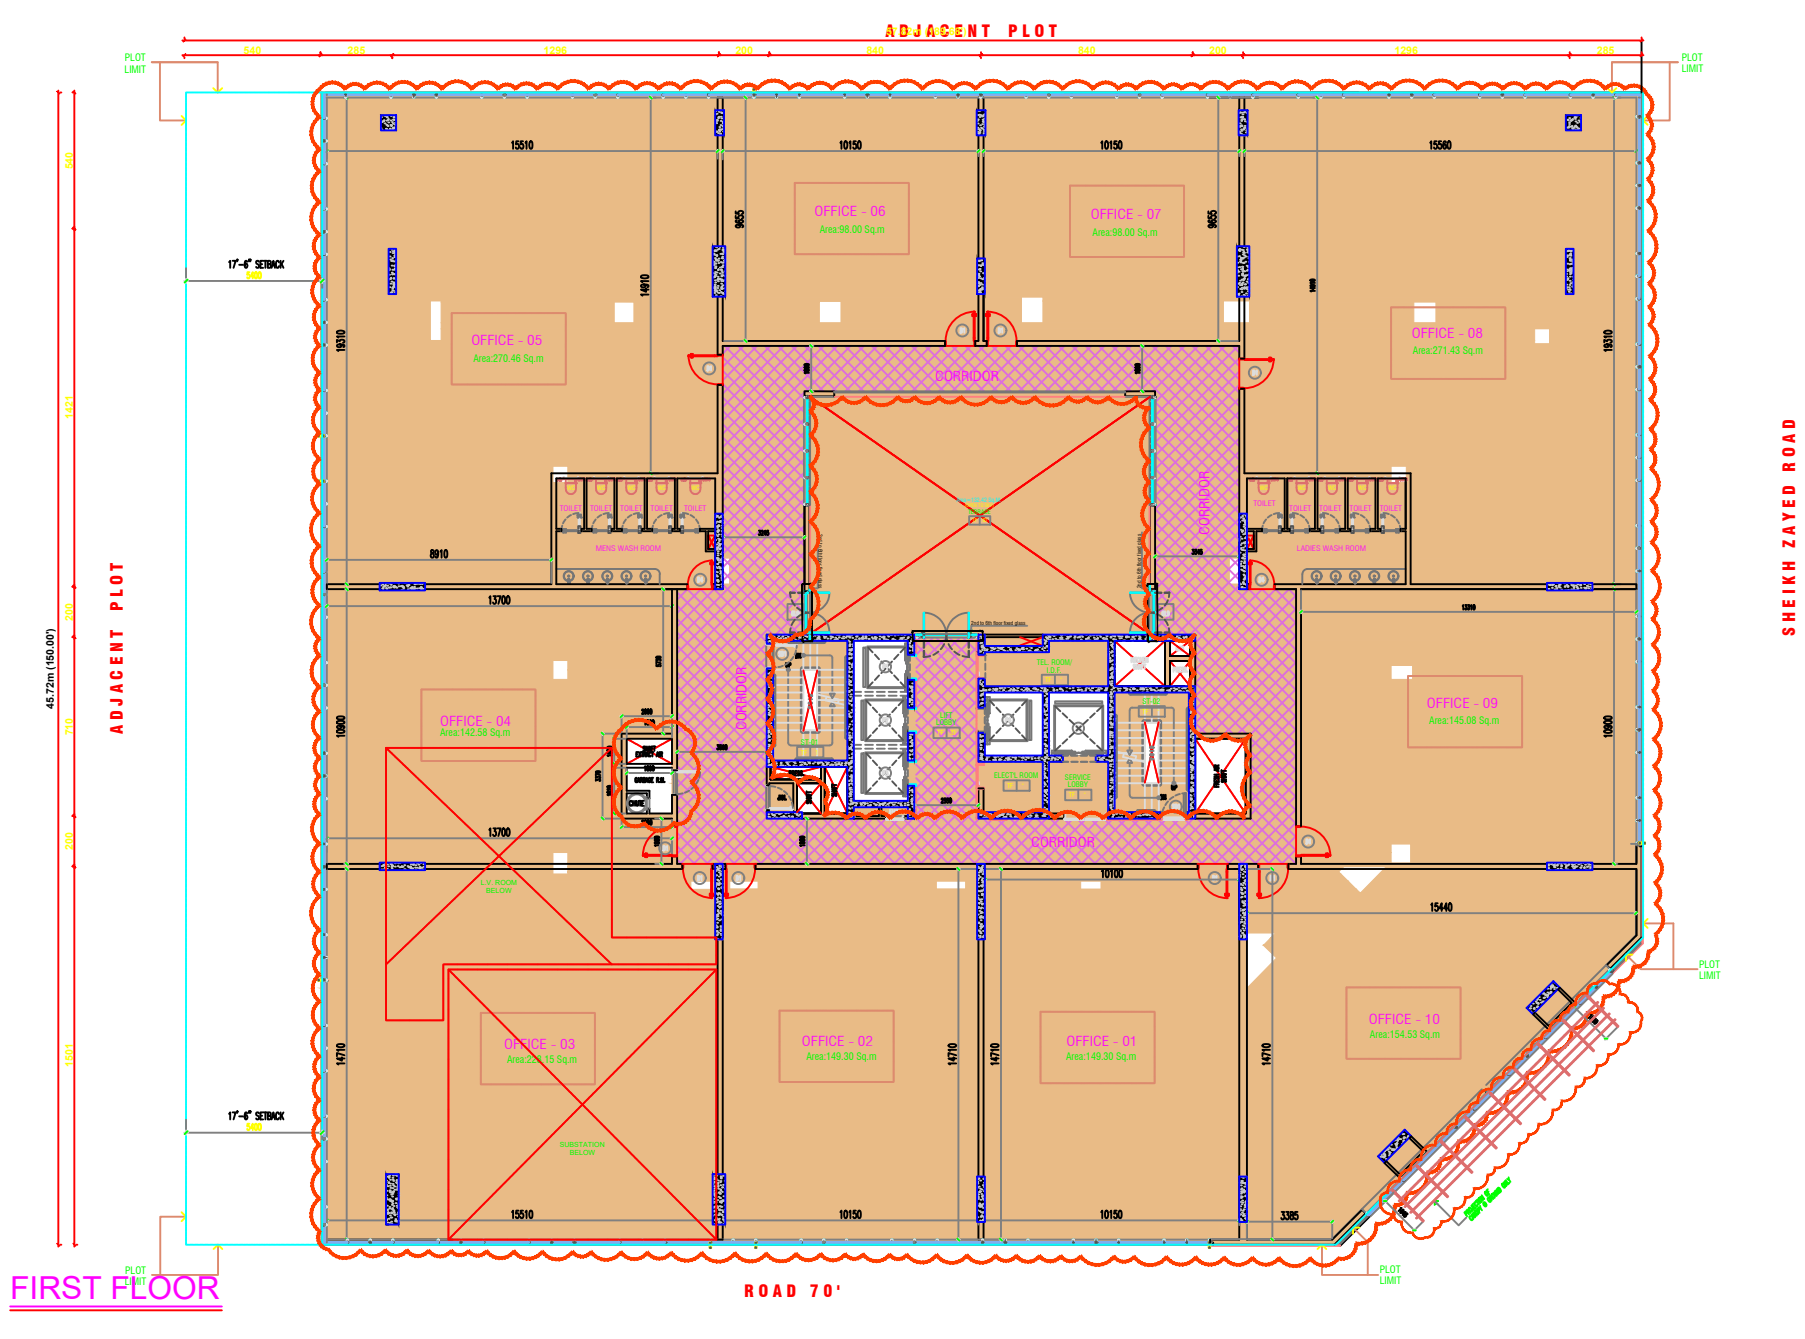


FIRST FLOOR

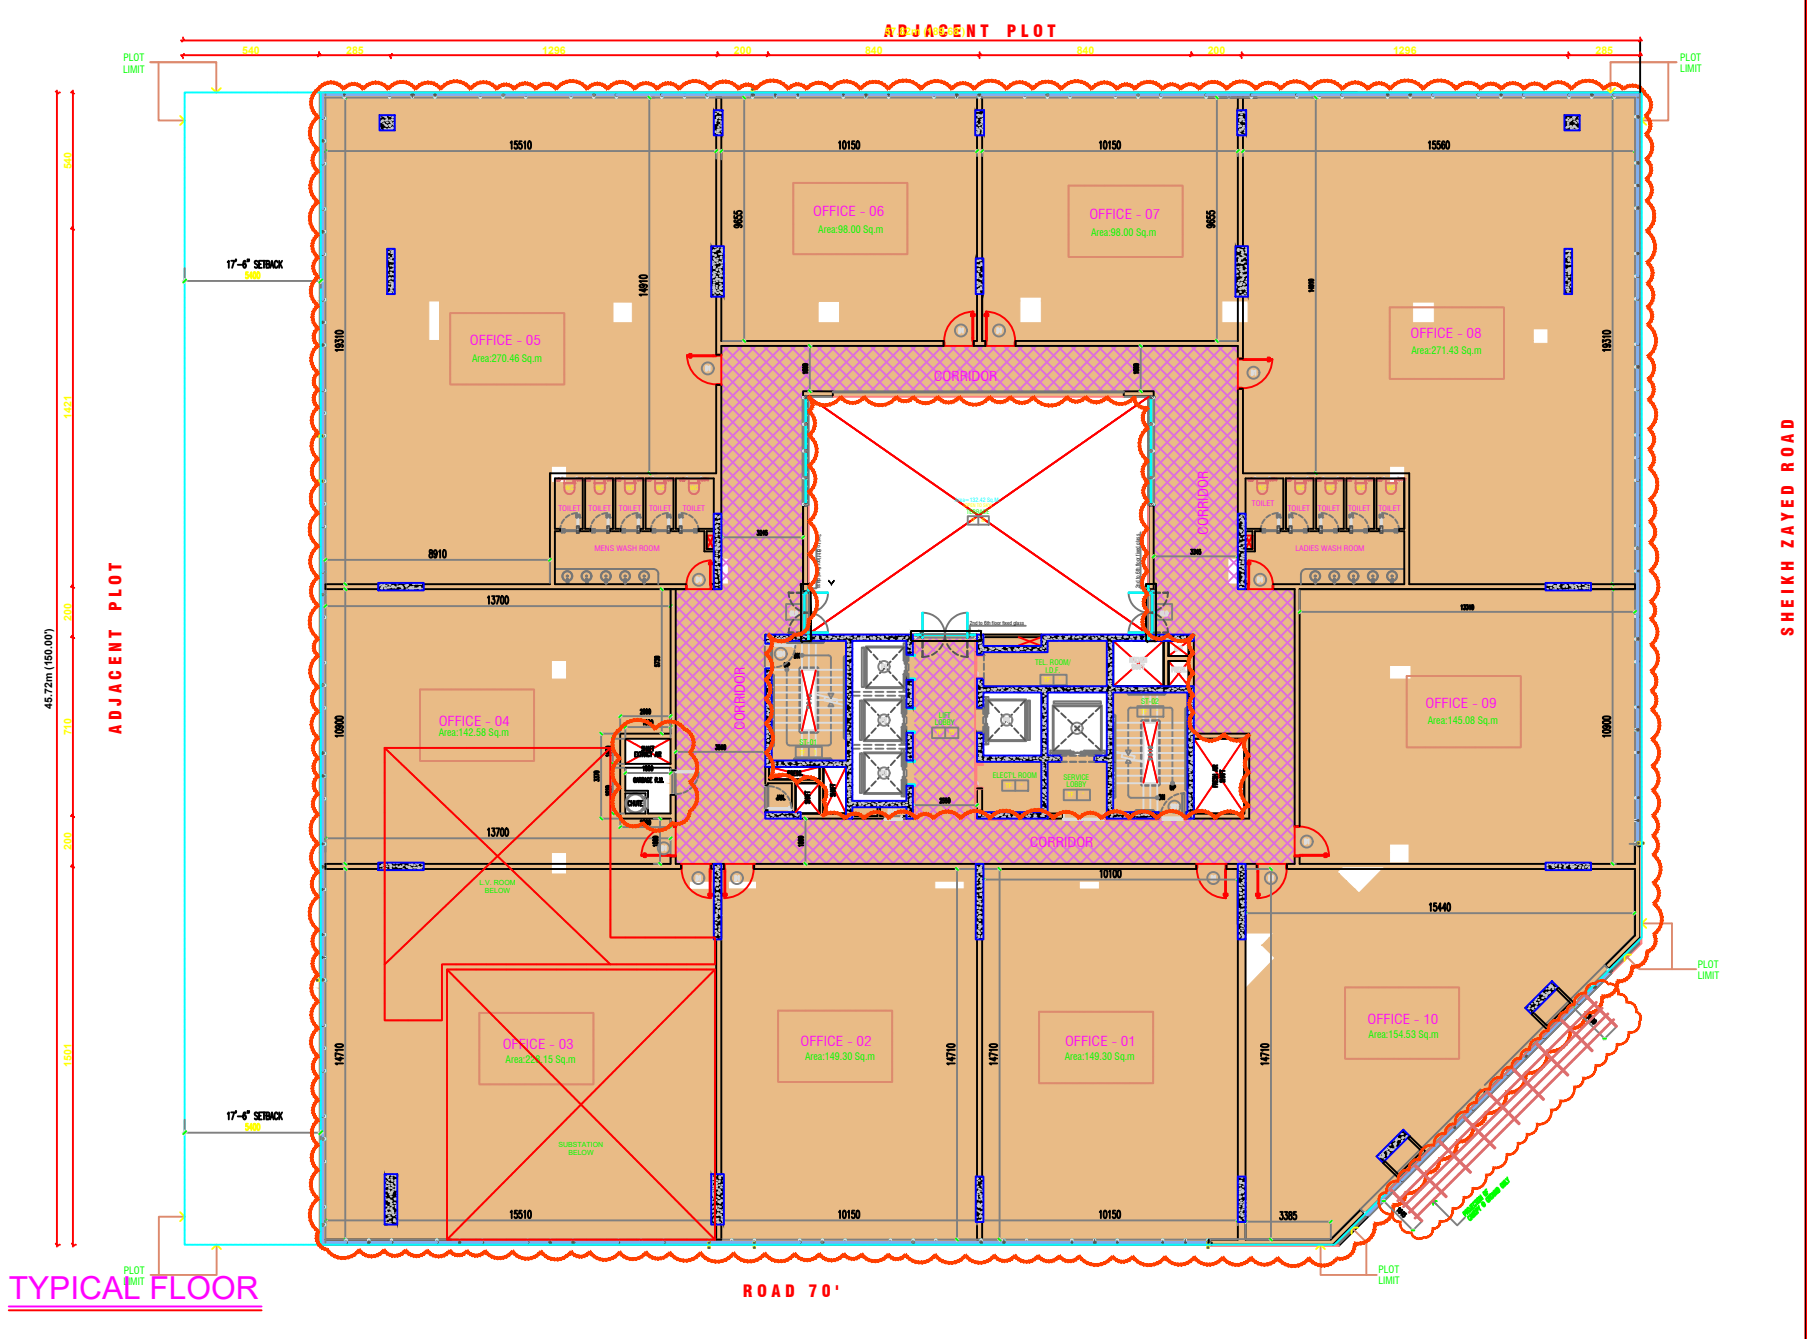

TYPICAL FLOOR



ROOF FLOOR

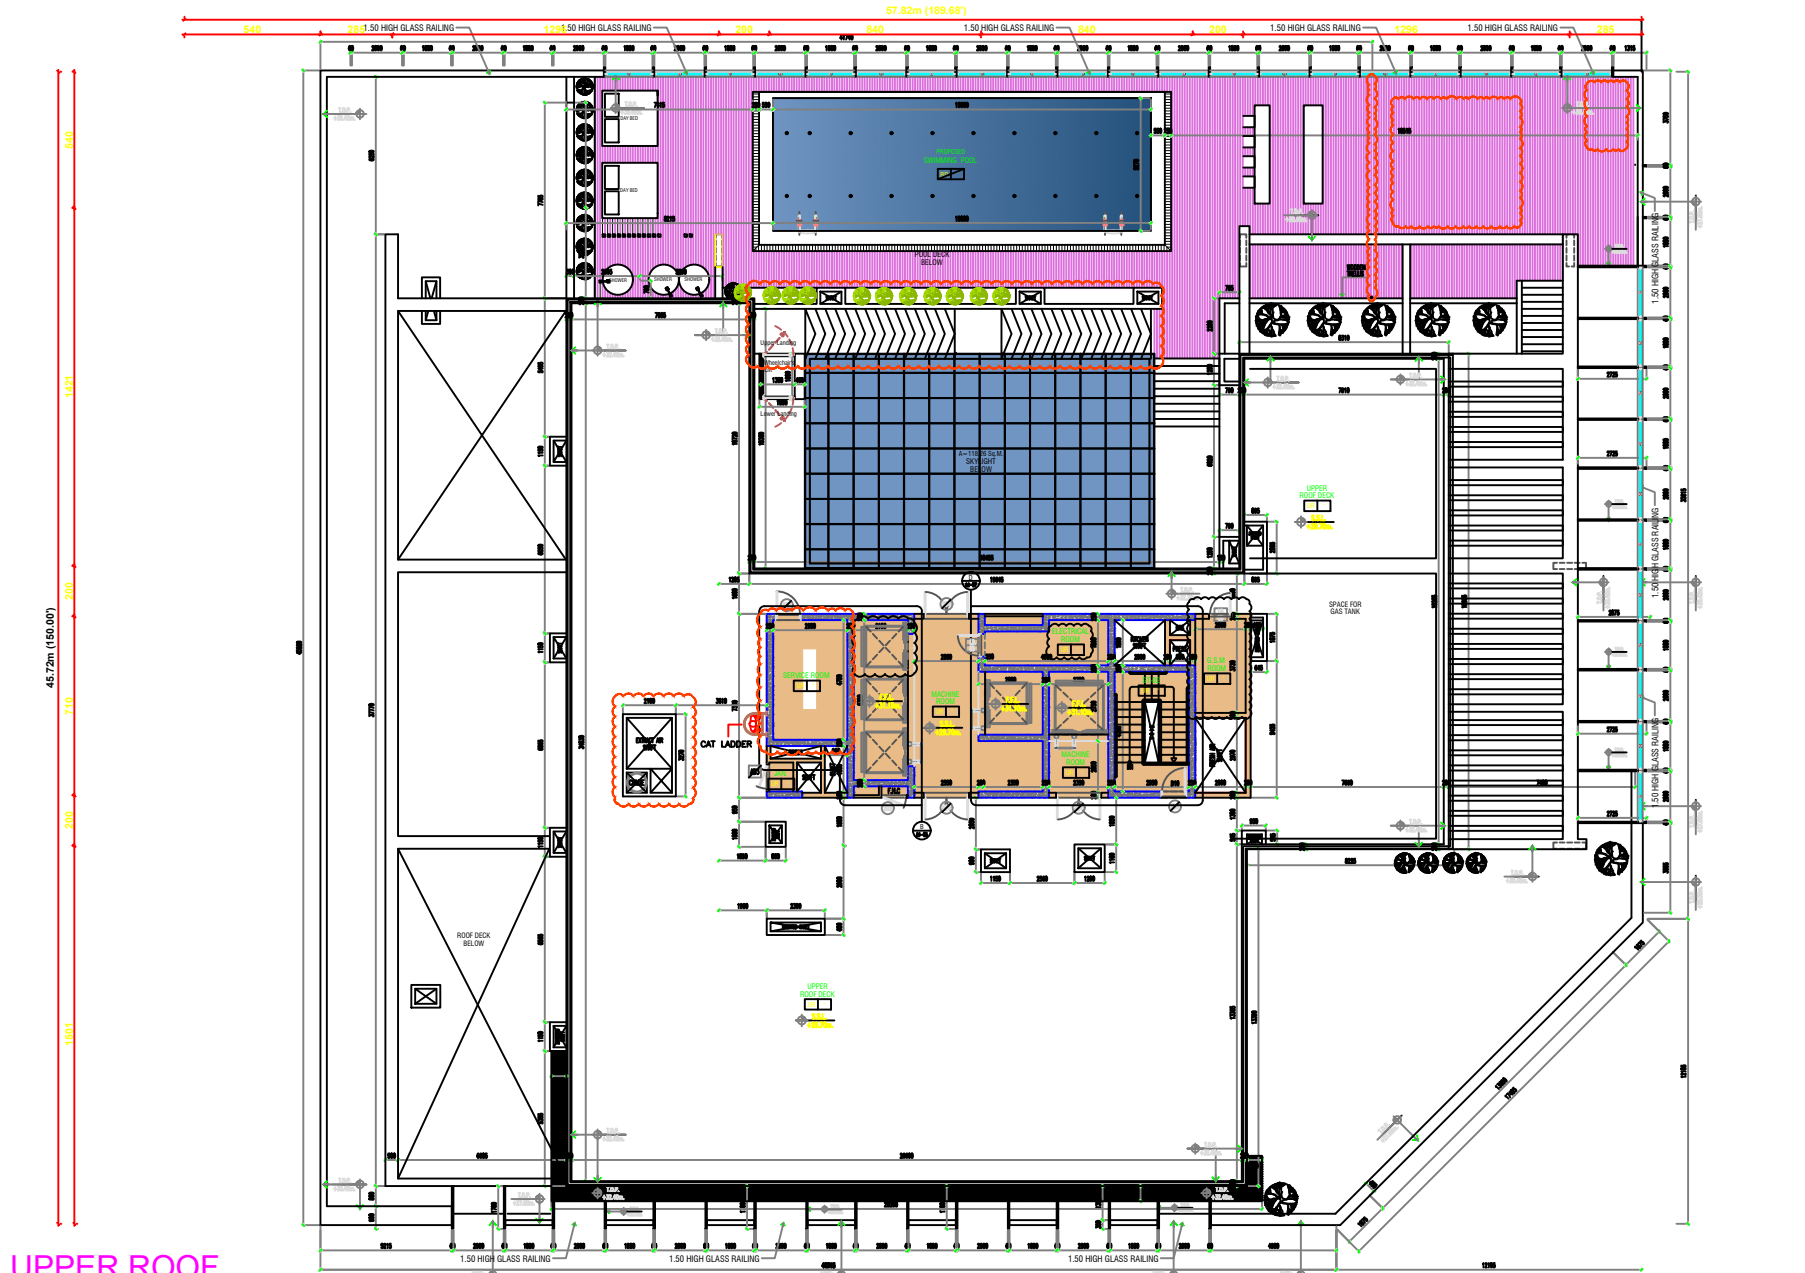

UPPER ROOF

AUTHORITY STAMP:

Important Notice:

This drawing is the intellectual property of Innovative Consultants. Any use of this drawing without the express written consent of Innovative Consultants is prohibited and will cause legal action to be taken against the user.

Notes:

- All dimensions are in centimeters, unless otherwise specified.
- Do not scale the drawing.
- All materials should be approved by the consultant.
- Do not cover any internal execution works before checked and approved by the consultant.
- Do not commence the work unless the building permit is issued from Dubai municipality or commencement order is issued from consultant.
- Contractor should submit the shop drawings for approval.
- Examine the drawings carefully before commencing the work. Any discrepancies found, report to the consultant and obtain clarification or additional instructions before proceeding.

ALL DIMENSIONS, CENTER LINES, COLUMNS SETTING OUT AND SETBACKS SHALL BE CHECKED AS PER ARCHITECTURAL DRAWINGS ONLY.

Legend:

REVISED

PROPOSED OFFICE BUILDING (3B+G+6+R)

Plot NO: 373-0412
Block: AL BARSHA FIRST
Date: JULY-2025
Job NO: IC-2025-08

BUILT-UP AREA CALCULATIONS

انوفيتيف للاستشارات
المهندسين في العمارة والهندسة
INNOVATIVE CONSULTANTS
CONSULTING ARCHITECTS & ENGINEERS
Tel: +9714-2500173 / E-mail: iccon@lecon.ae / P.O.BOX: 7856

Scale: NTS
Drawing No: G0-06a