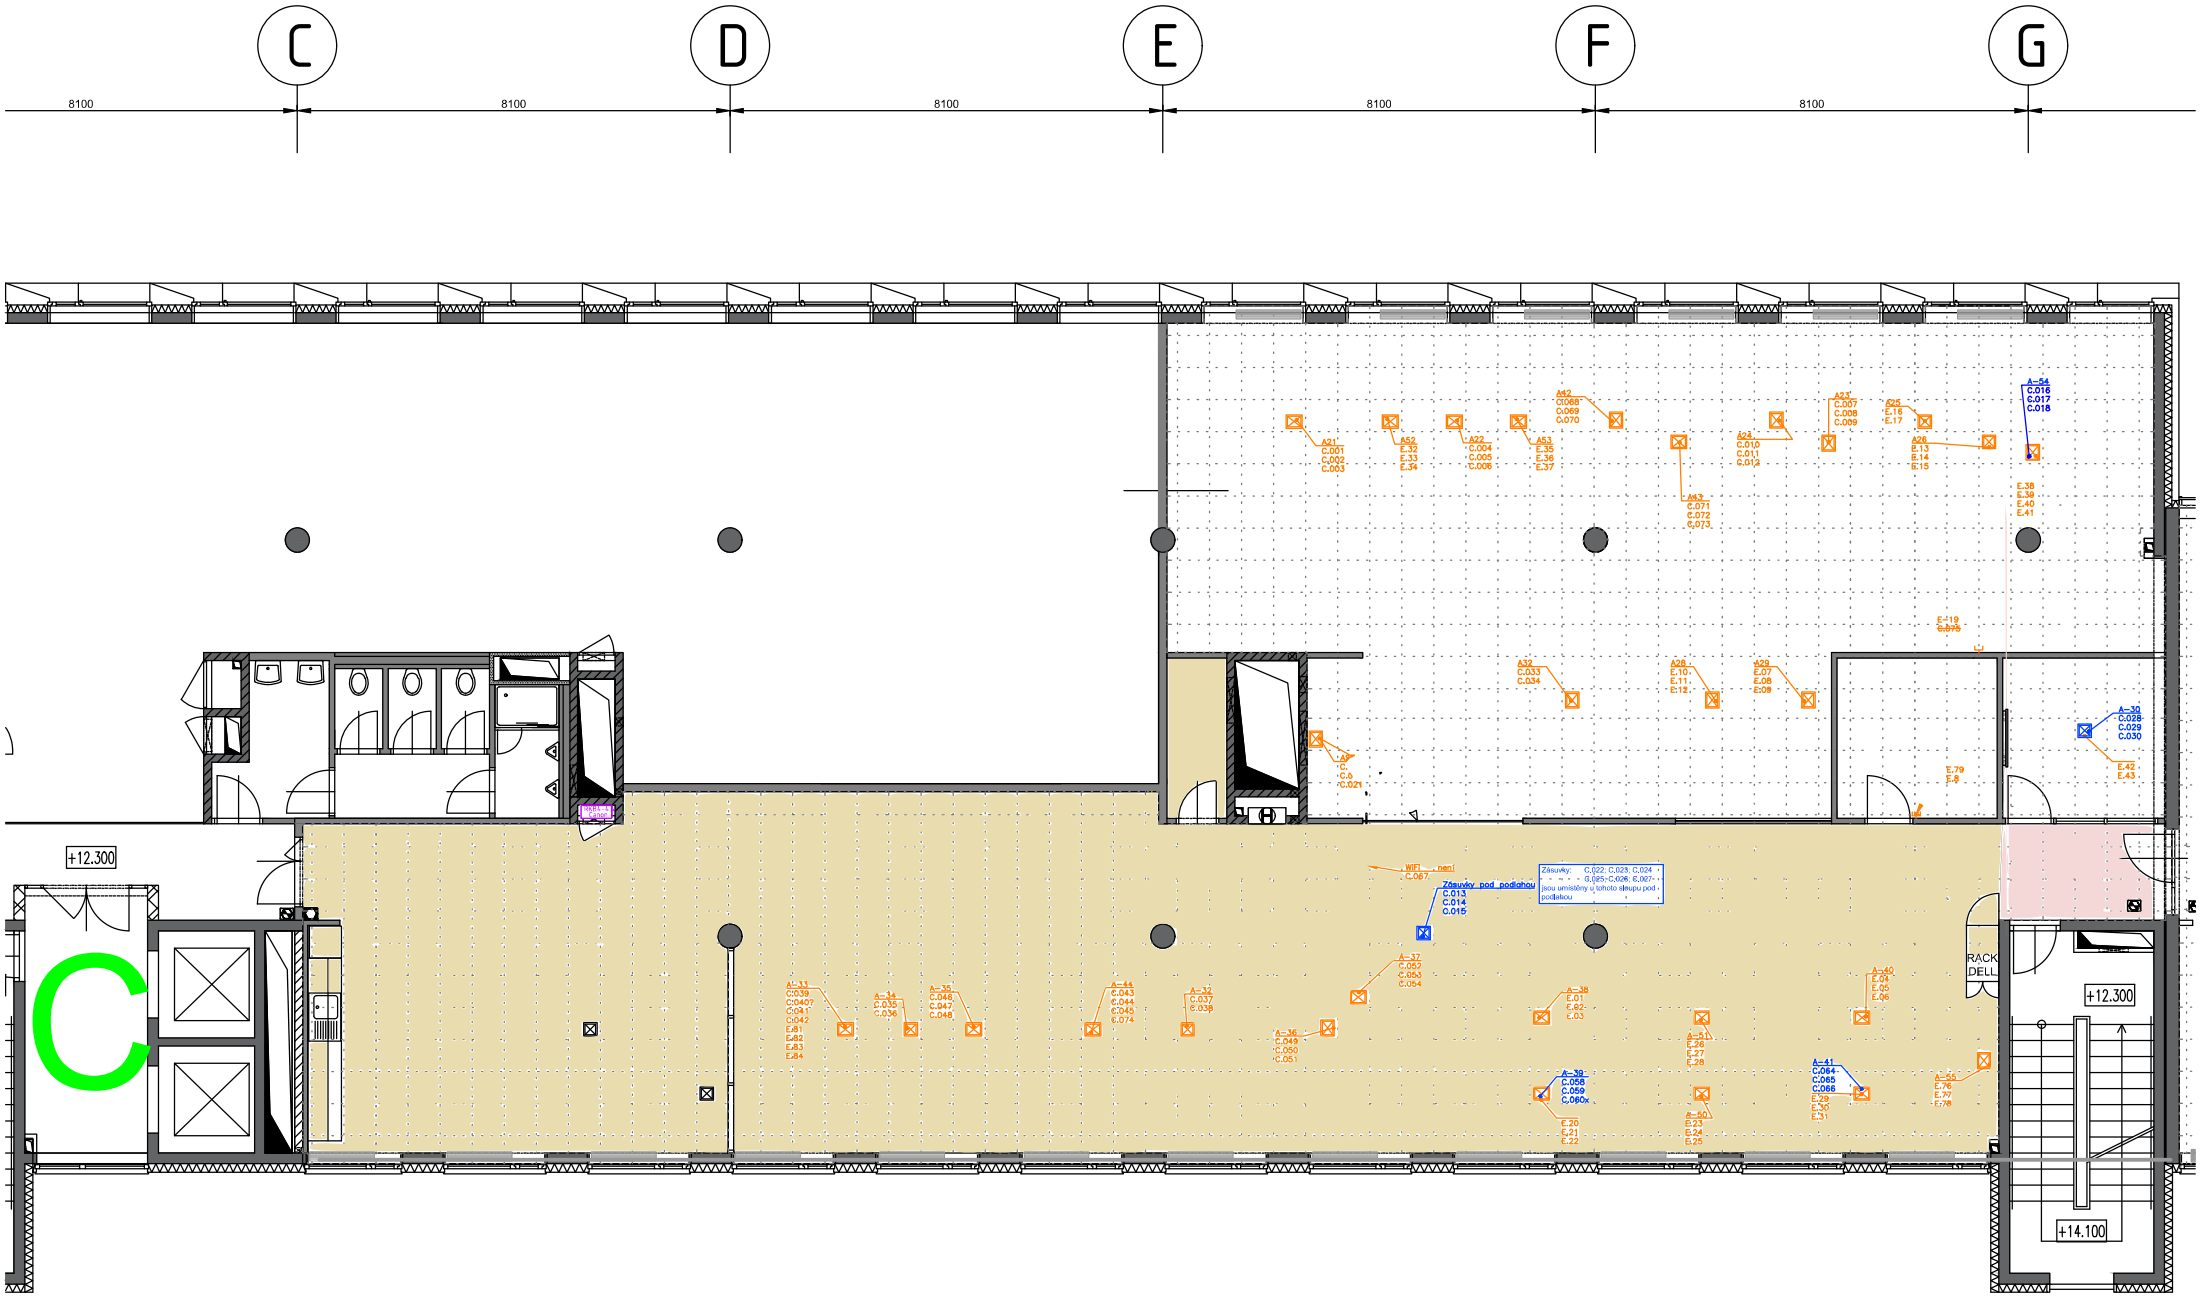

C
D
E
F
G
8100
8100
8100
8100
8100
+12.300
+12.300
+14.100
RACK
DELL
C