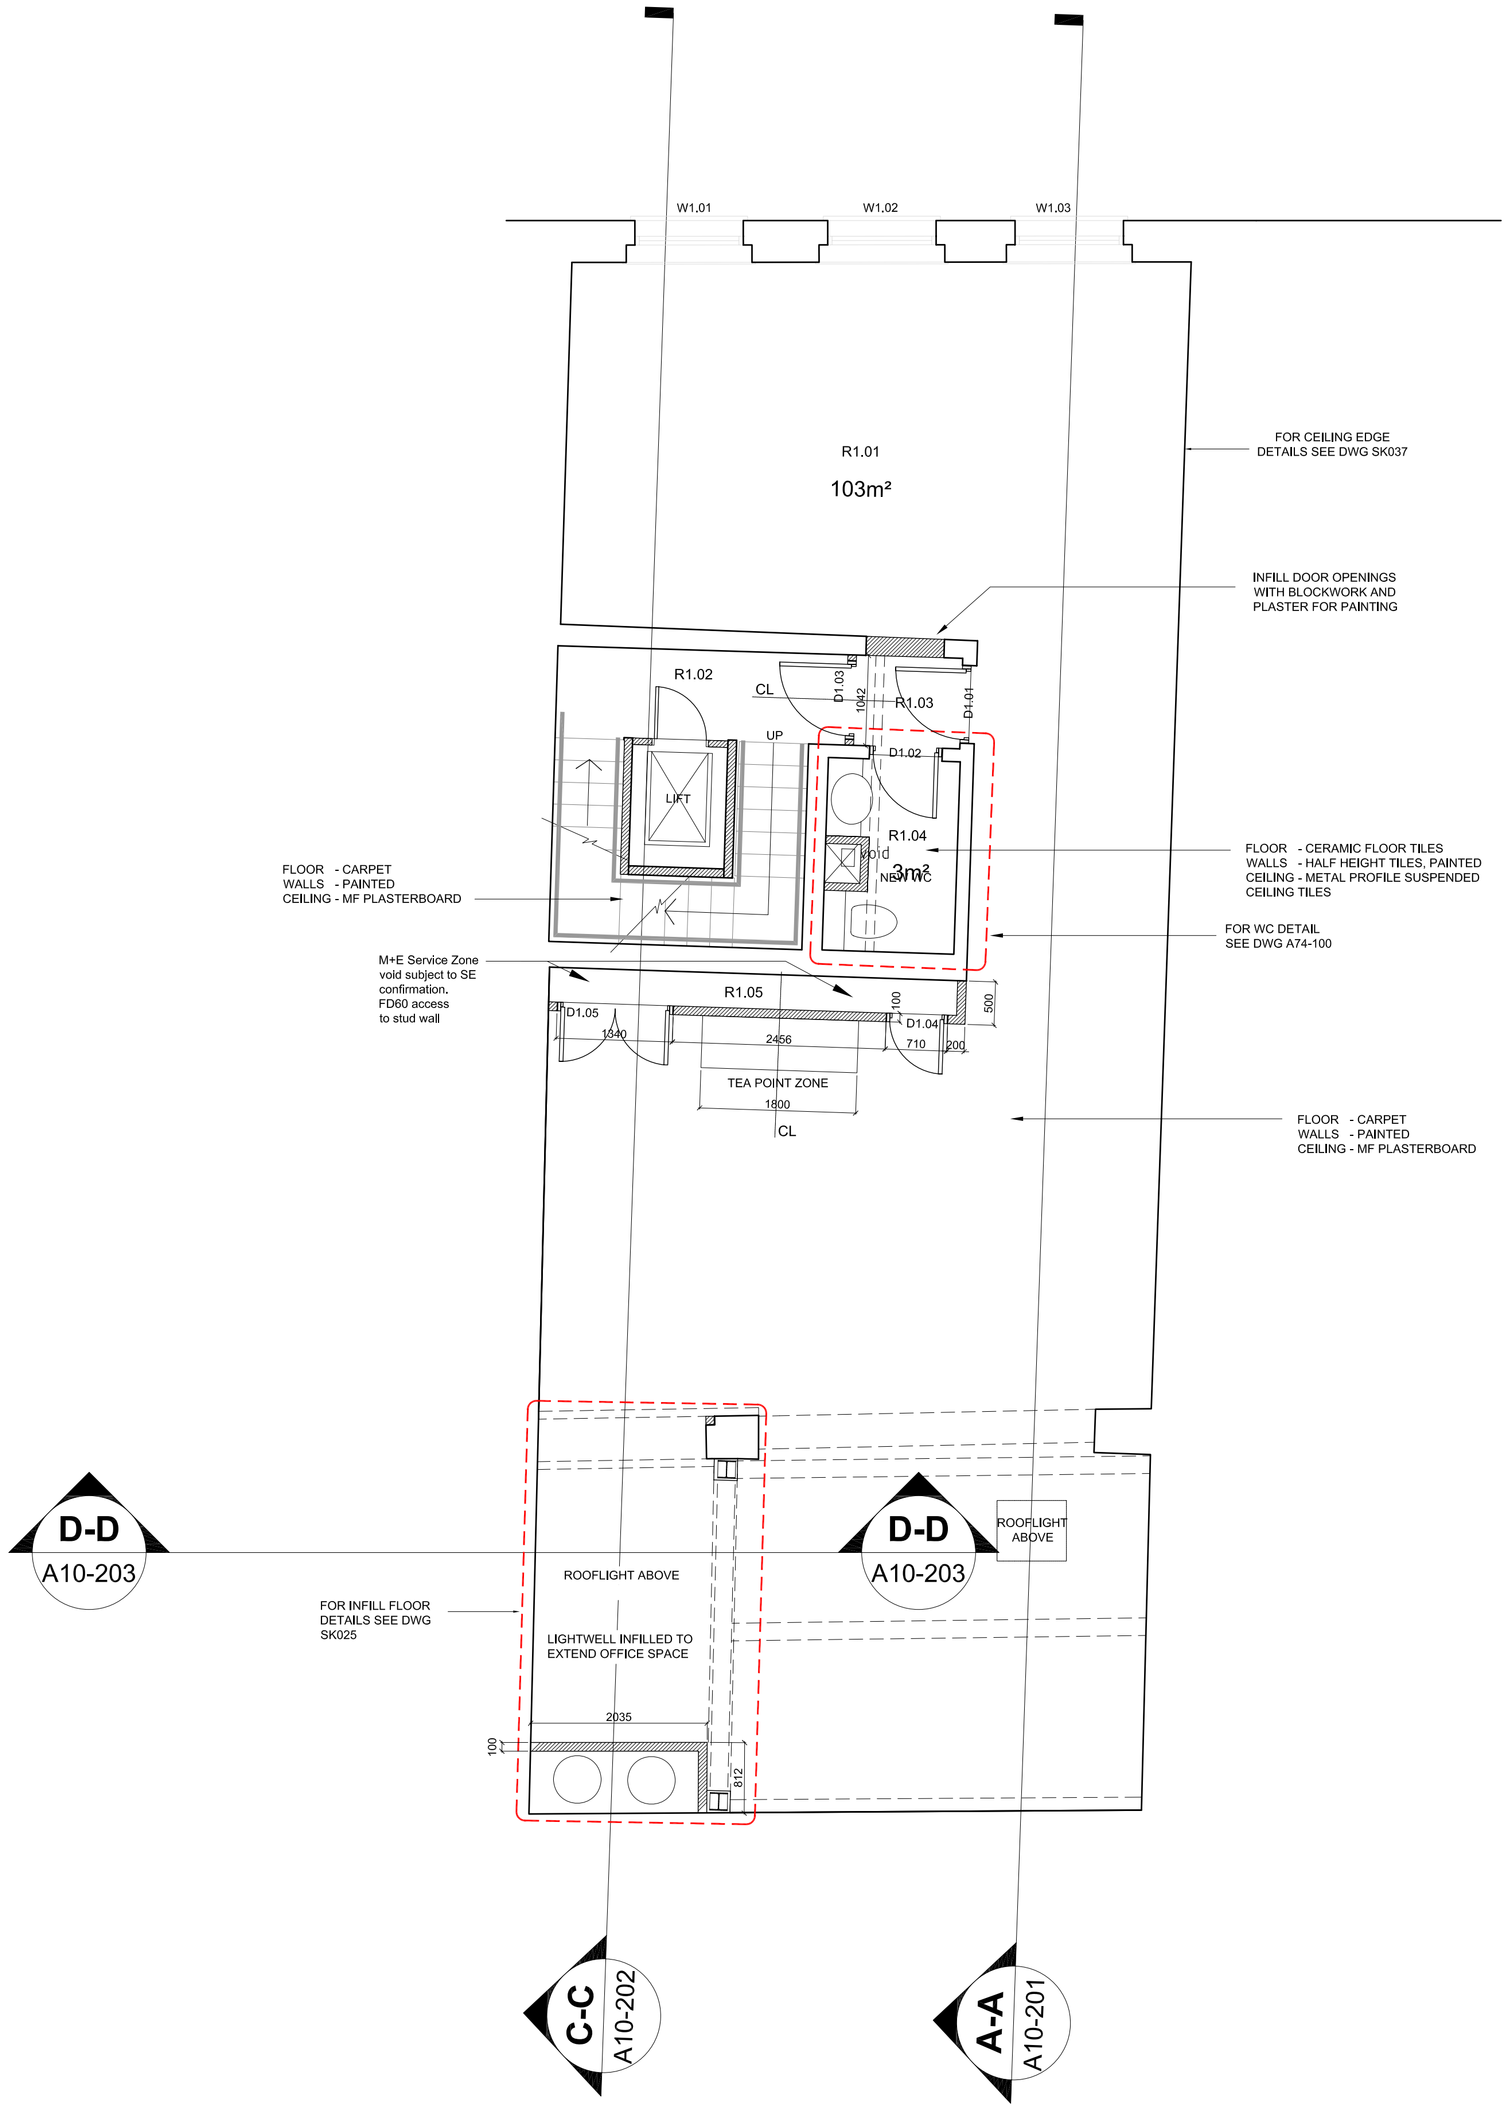

Scale 1:50
0 metres 0.5 1 1.5 2 2.5

N

Disclaimer
Do not scale from this drawing.
Check all dimensions on site before fabrications or setting out.
This document is copyright and may not be reproduced without permission of the owner.

Location

Key

Revisions	Notes	Date	Drawn
M	Revisions for Tender	11.10.12	VP
L	Revisions following client and M&E meeting	01.10.12	EY
K	Drawing update	11.09.12	EY
J	Updated to latest land survey and reflecting enabling works	14.08.12	EY
H	Existing locations of risers in WC corrected. Ceiling finishes updated, handrail in stairs and outline of dado trunking added. New walls hatched.	28.06.12	EY
G	Door nos and doors to service risers added	21.06.12	EY
F	Mechanical and Electrical Riser Voids Accommodated	15.06.12	TH
E	Mechanical and Electrical Risers Accommodated	29.05.12	TH
D	Surface finishes added	23.05.12	EY
C	NIA updated, GIA added.	01.05.12	EY
B	Drawing updated with location of rooflight	24.04.12	EY
A	Drawing update	18.04.12	EY

Drawing Status
INFORMATION

Client
SLM HOLDINGS

Project
19 BEDFORD ROW, WC1R 4EB

Drawing Title
PROPOSED FIRST FLOOR PLAN

Job Number	Drawing Number	Revision
L0914	A10-101	M

Scale	Date Issued	Issued By
1:150 @ A1	10.01.13	VP
CAD File Name	**Date Drawn**	**Drawn By**
L0914_A10-101	05.04.12	TH/VP

Potter & Holmes architects
27 Bulwer Street
London W12 8AR
T. 020 8749 3123
mail@potterandholmes.com