



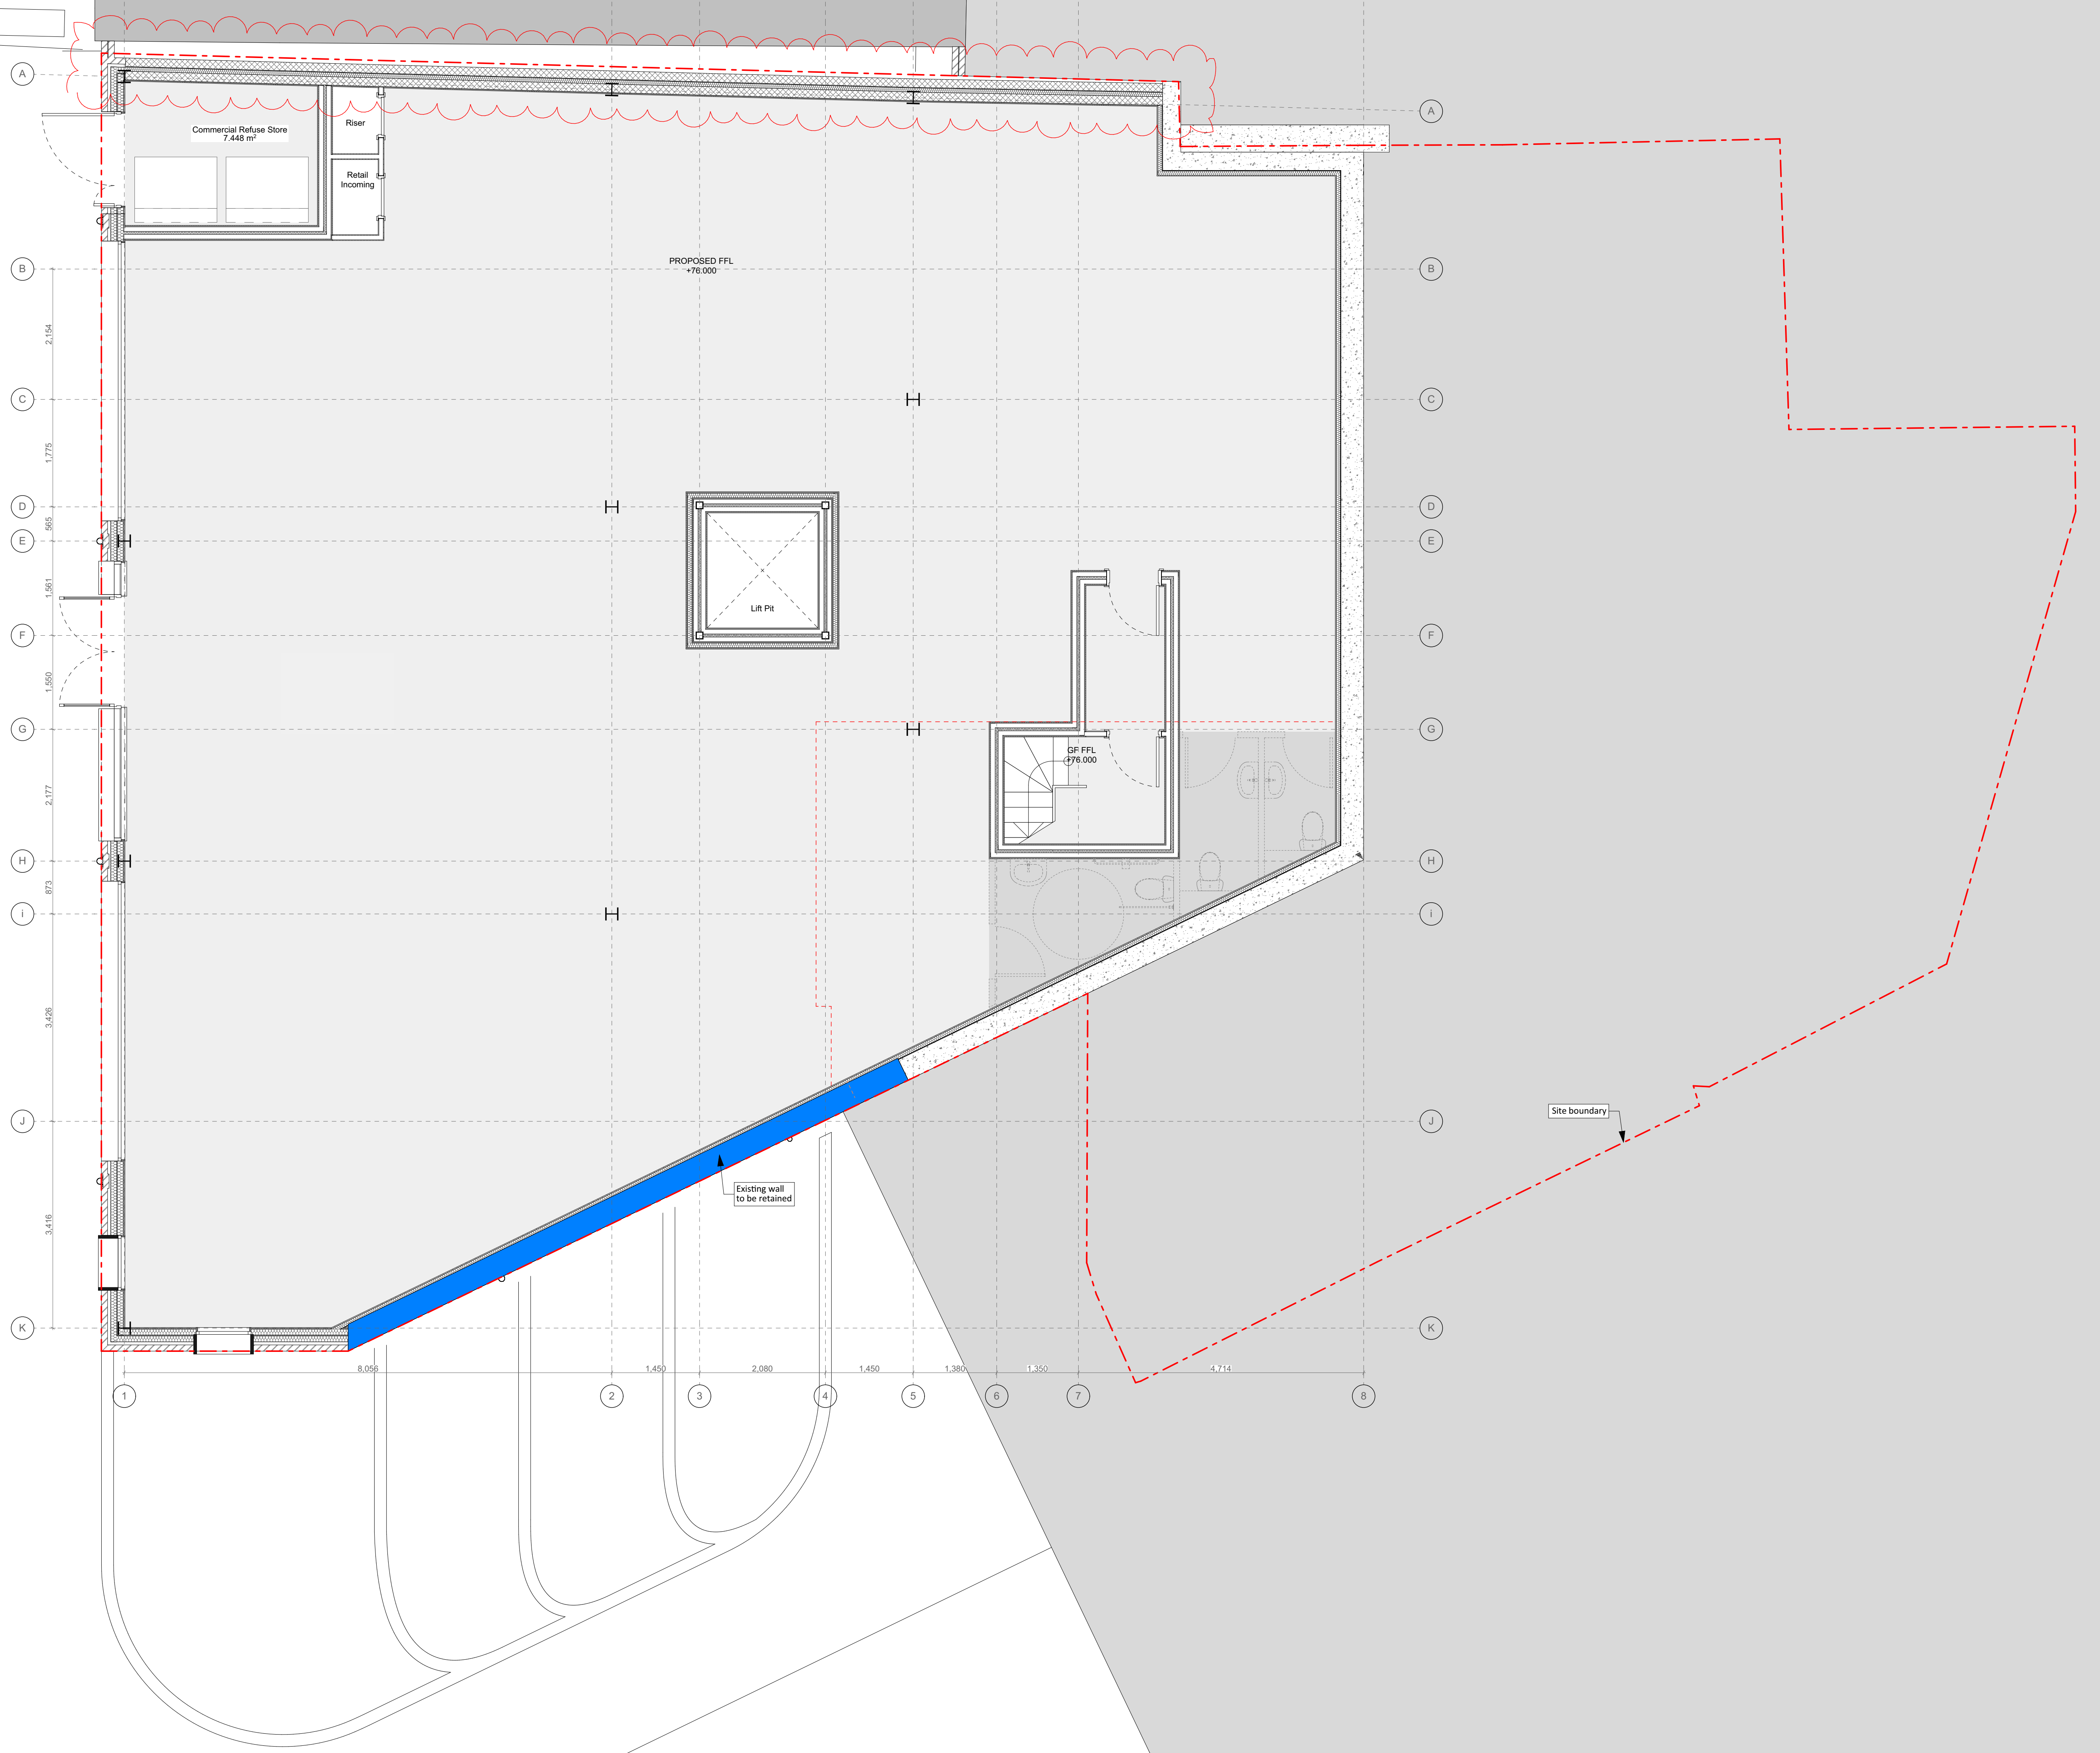

Revision:	Date:	Drawn:	Check:
A	Layout updates as per client comments received.	12.07.21	CEP VTQ
B	Layout updates as per client comments received.	22.07.21	CEP VTQ
C	Updates to secondary escape stair.	26.07.21	CEP VTQ
D	Maximum travel distances to each door added	03.08.21	VTQ
E	Layout updates as per client comments received.	13.08.21	CEP VTQ
F	Layout updates as per client agreed alterations received on 08.10.21	20.10.21	CEP VTQ
G	Ramp removed following client's comments	21.10.21	VTQ RRO
H	South elevation external walls updated to suit GF retaining wall updates from site survey.	28.01.22	CEP VTQ
i	External wall position updated as per site meeting comments. Boundary line added.	23.02.22	CEP VTQ

- Notes:
- Layouts to be confirmed by client & approved by Local Planning Authority.
 - Layouts drawn based on latest plans provided.
 - GIAs to conform with NDSS.
 - Wall build ups to be reviewed based on CPs to achieve correct u-values. Flat areas subject to review of wall build ups.
 - Riser and plant equipment and sizes TBC by M&E consultant

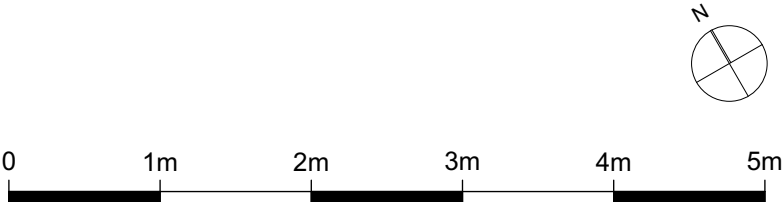

Project:	A development at The Parade, Haywards Heath
Status:	For Comment
Client:	SUL Ltd
Sheet title:	Proposed Ground Floor Plan
Scale:	1:50@A1
Date:	07.07.2021
Drawn:	CEP
Checked:	VTQ
Ref:	101-110/(00)001i

Waterloo House, 71 Princess Road West, Leicester, LE1 6TR · T 0116 204 5800
74 Wells Street, London, W1T 3JQ · T 020 3327 0383
F 0116 204 5801 · rg-p.co.uk · design@rg-p.co.uk

All dimensions to be checked on site. Do not scale off this drawing for construction purposes.
This drawing is the copyright of the Architect, and not to be reproduced without their permission.
Ordnance Survey map information reproduced with permission of HMSO Crown Copyright reserved. rg+p Ltd. Trading as rg+p.