
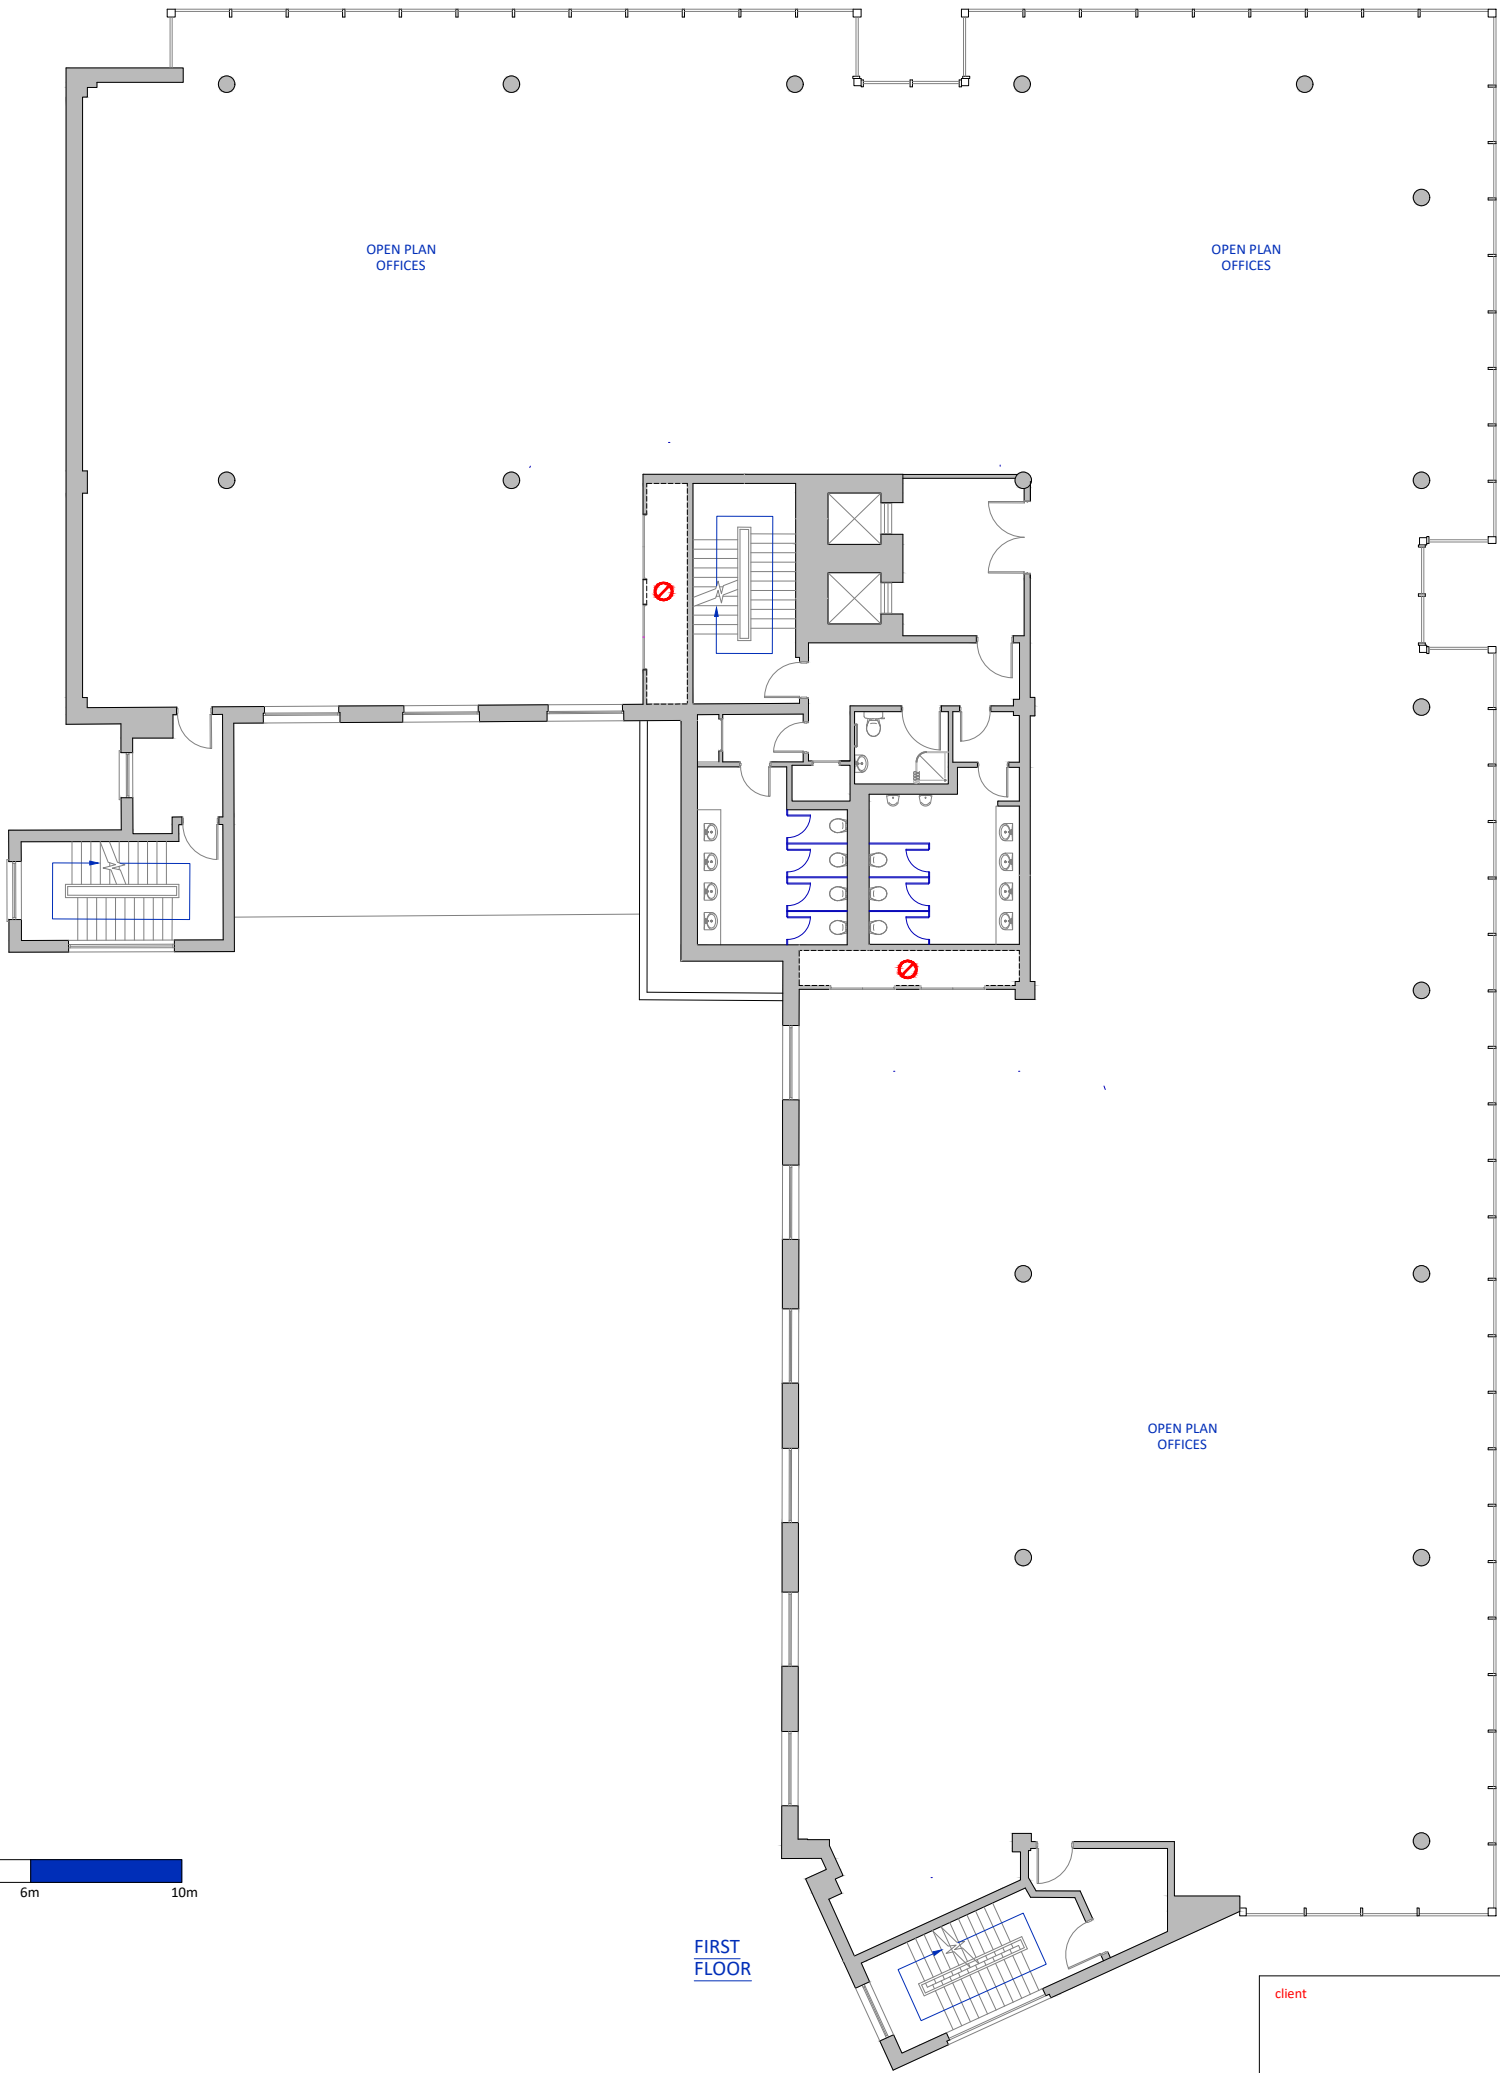


PLEASE NOTE - A3 PLANS TO BE PRINTED "AS IN DOCUMENT" NOT ENLARGED OR SHRUNK TO FIT PAGE

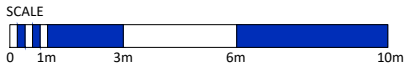

NOTES

- NO ACCESS AT TIME OF SURVEY
- CEILING PROFILES (INDICATIVE ONLY)
- RAMP (DIRECTION ALWAYS UP UNLESS OTHERWISE STATED)
- STAIR DIRECTION (DIRECTION ALWAYS UP UNLESS OTHERWISE STATED)
- FIRE EXIT

THIS SURVEY HAS BEEN CARRIED OUT IN ACCORDANCE WITH THE CURRENT RICS CODE OF MEASURING PRACTICE. IT HAS BEEN PRODUCED TO AN ACCURACY SCALE OF 1:50 AND WILL BE WITHIN THOSE TOLERANCES.

THE SURVEY HAS BEEN CARRIED OUT SURFACE ONLY AND WHERE ACCESS WAS UNRESTRICTED. INACCESSIBLE AREAS HAVE BEEN INDICATED ON THE DRAWINGS. SHOP FITTINGS MAY OBSCURE FULL EXTENT OF THE DEMISE. PLAN-LONDON LIMITED ACCEPT NO RESPONSIBILITY FOR BUILDING ELEMENTS THAT ARE LATER EXPOSED WITH THESE AREAS.

ALL DIMENSIONS SHOULD BE CHECKED ON SITE PRIOR TO CONSTRUCTION.

THIS SURVEY HAS BEEN PRODUCED FOR THE INSTRUCTING CLIENT AND PLAN-LONDON LIMITED ACCEPT NO LIABILITY TO ANY SUBSEQUENT OWNER/AGENT/3RD PARTY.

client	address 1 THE SQUARE TEMPLE QUAY BRISTOL BS1 6DG	location FIRST FLOOR FLOOR PLAN	date 03.10.2014	scale 1:200	sheet A3	S:\Jobs\Plan London CAD Logo.png
			dwg no. PL7565-04	revision	drawn SS/EL checked PB	