

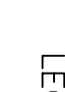




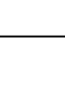



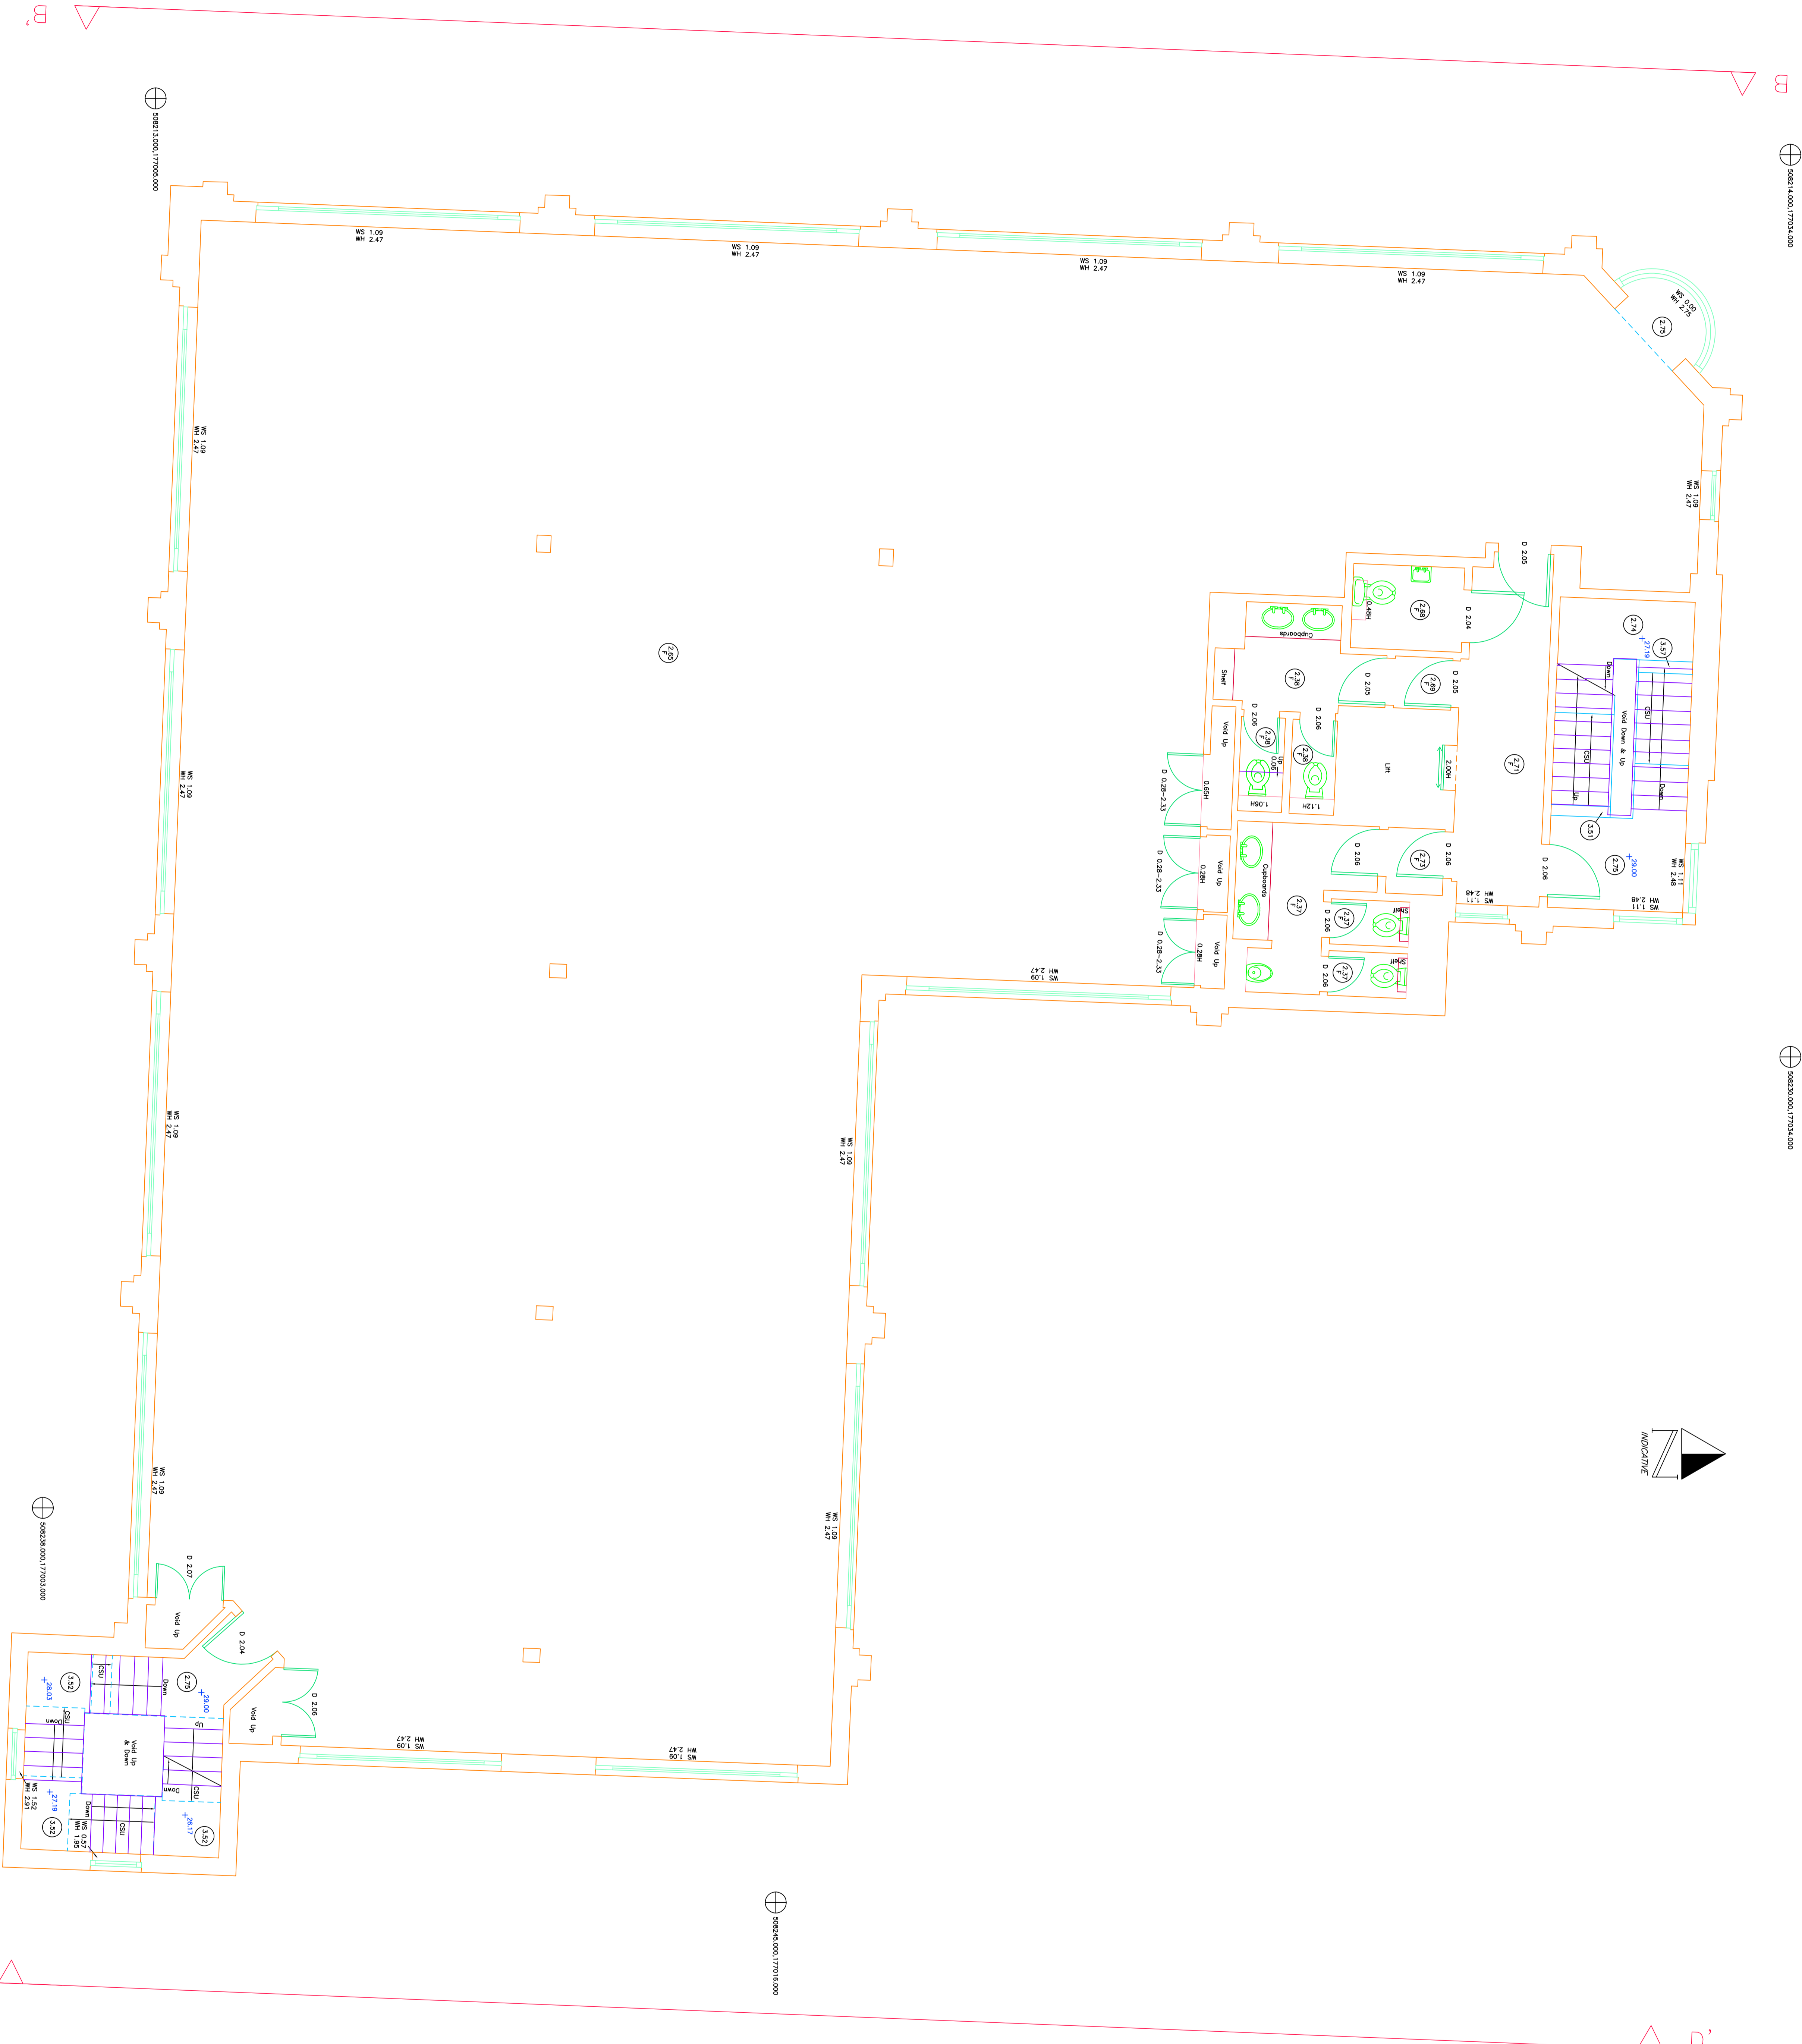


LEGEND

	SCAFFOLDING FRAME
	RAIN WATER
	GAS ESTIMATOR
	GAS ESTIMATOR
LEVEL DATUM

DATUM USED: OS SP6 ACTIVE NETWORK



REVISION

NO.	DATE	REVISION

CORSTORPHINE + WRIGHT
 ONE MORTIMER STREET
 LONDON
 W1T 3JA

5 WONDIAL WAY
 BATH ROAD
 MIDDLESEX
 UB3 5AR

DRAWING TITLE

FIRST FLOOR

SCALE	DATE	BY	CHECKED
1/50	1 FEB 2017	AD	AD