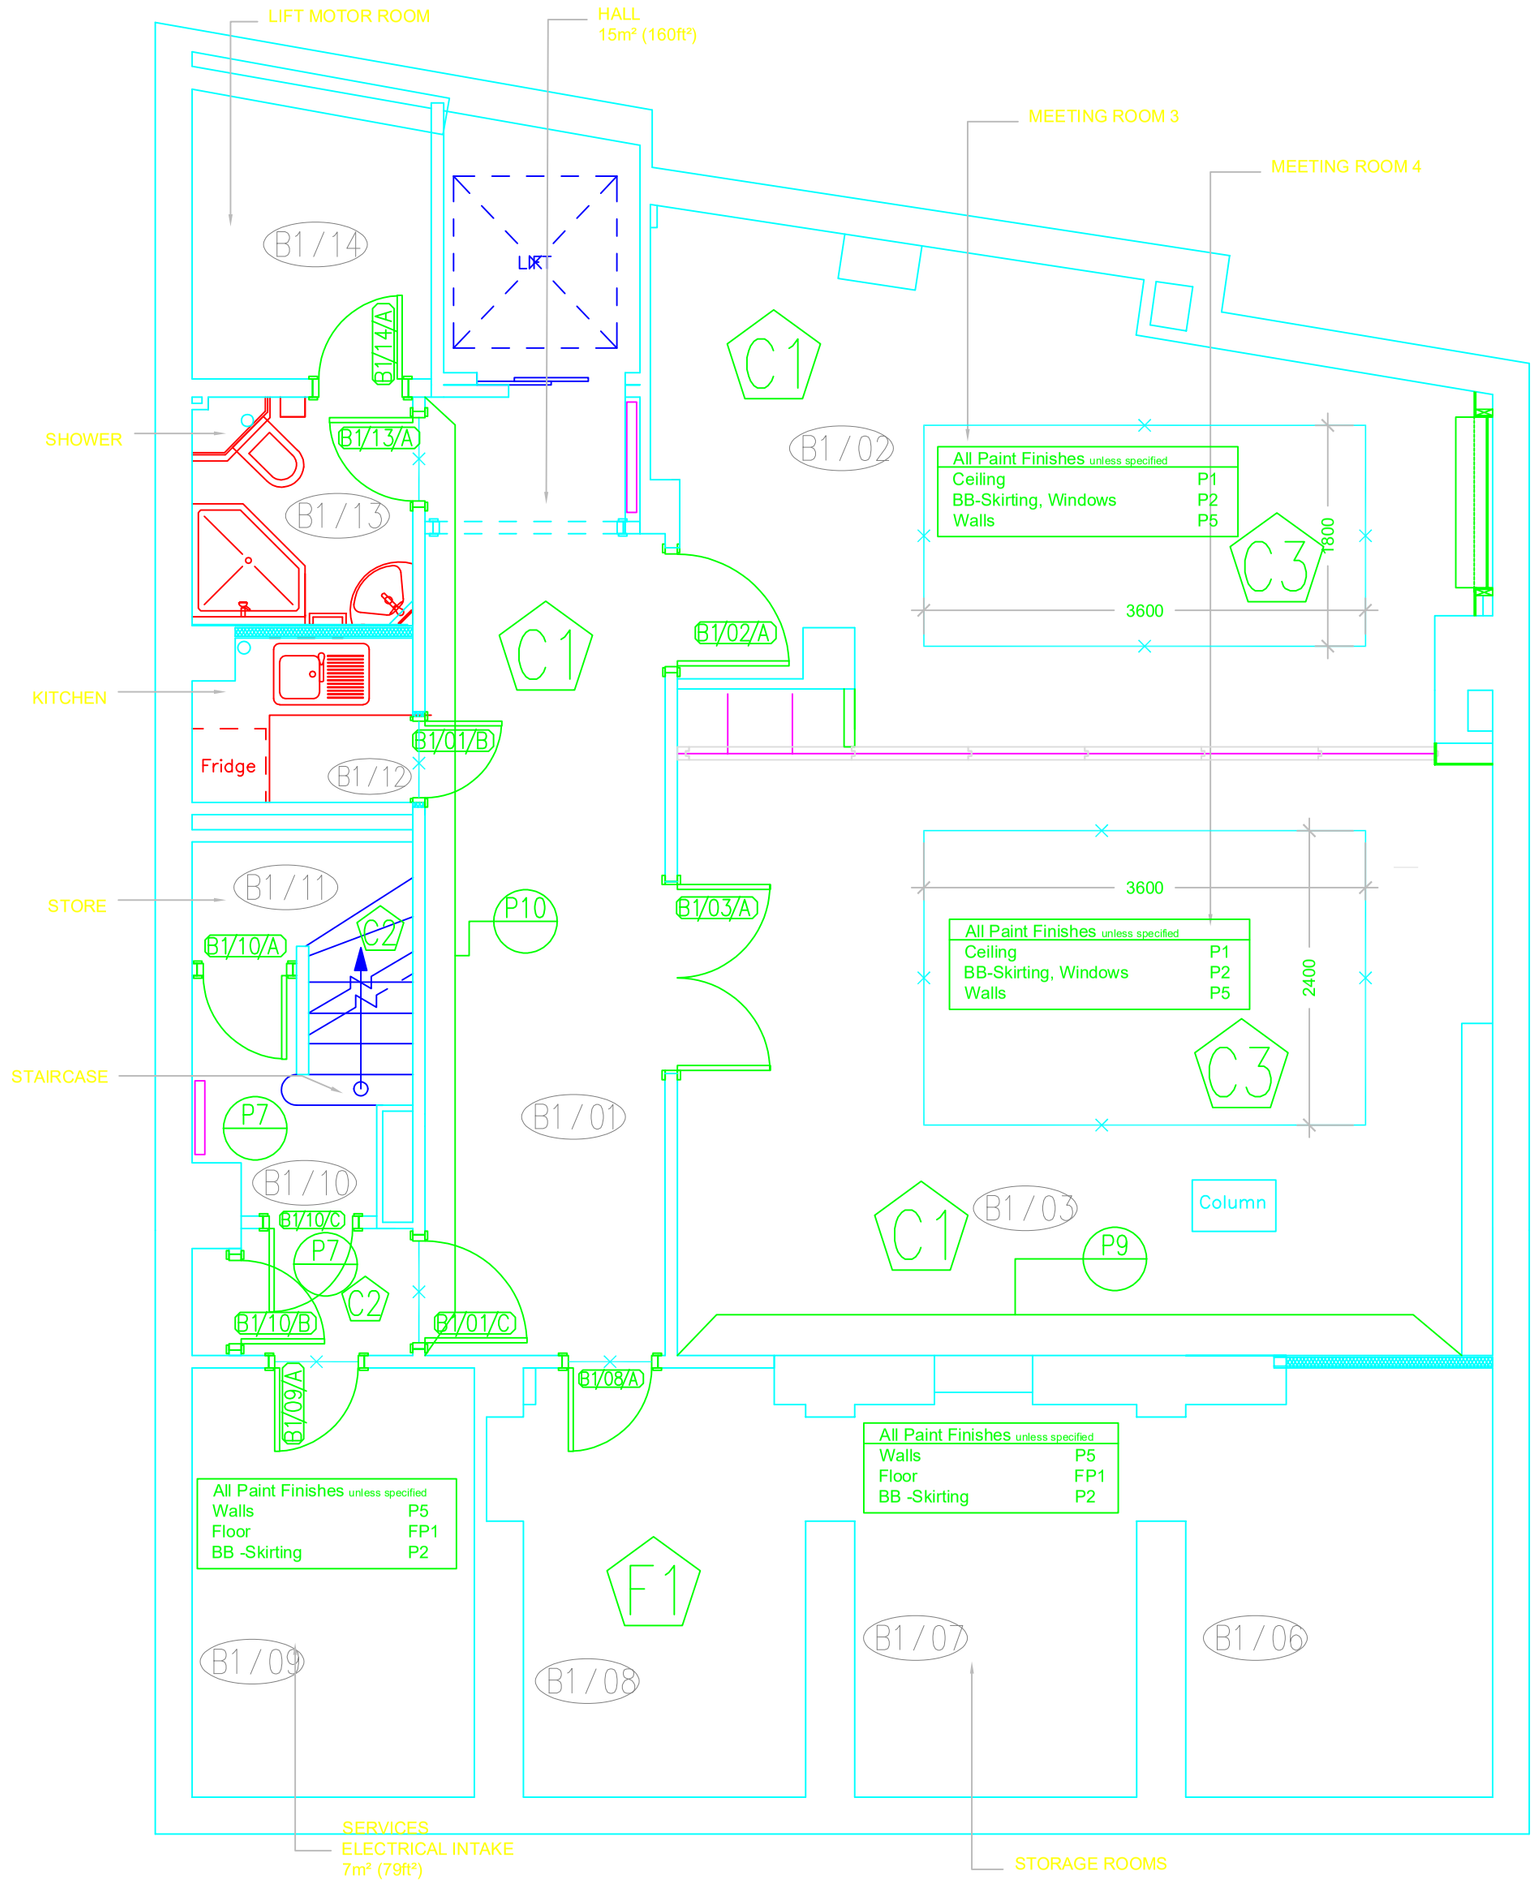

PLAN: BASEMENT FLOOR
SCALE 1:50

B

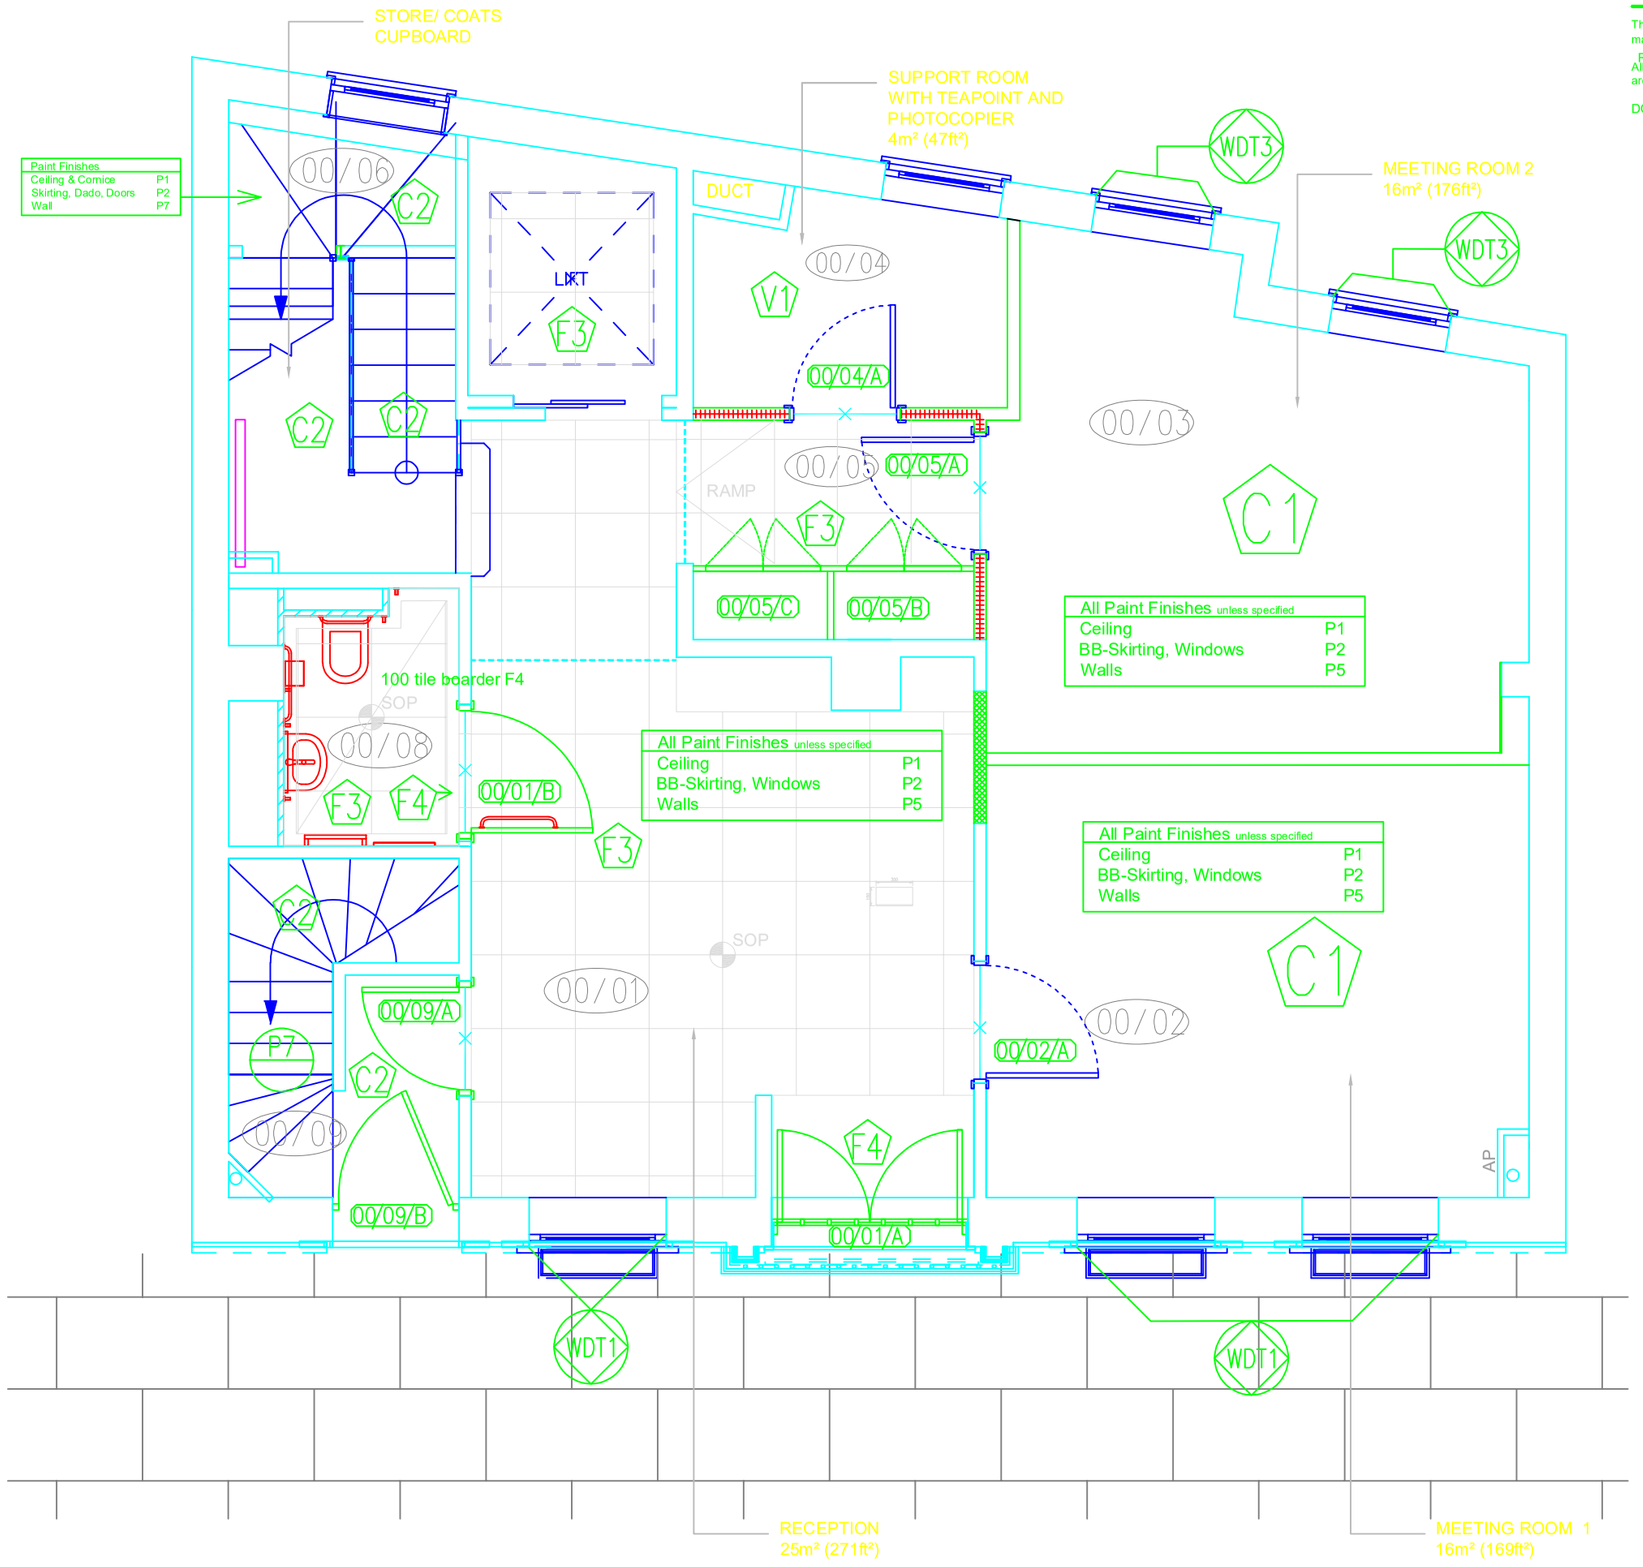

PLAN: GROUND FLOOR
SCALE 1:50

GRD

This drawing is the property of Denton Associates Limited and may not be reproduced or otherwise without prior consent.

Revisions:
All dimensions must be checked on site before any works are undertaken.

DO NOT SCALE THIS DRAWING

Read in conjunction with:
S1 - finishes schedule

AS BUILT

Rev.	Date.	Description	Drawn
#	08/02/08	AS BUILT	TR

Revisions:

Denton Associates
3rd Floor
27-32 Old Jewry
London, EC2R 8DQ

Tel: +44 (0) 20 7776 2888
Fax: +44 (0) 20 7776 2889
Email: info@dentonassociates.com

Project Title:
EGOROV PUGINSKY AFANASIEV & PARTNERS
3 GOUGH SQUARE
LONDON
EC3

Drawing Title:
FINISHES PLAN
GROUND & BASEMENT
AS BUILT

Drawn By:	Date:
TR	12/04/07
Scale:	**Checked By:**
1:50@A2	TR

Job No	Dwg type	Level	Revision
8630	FN	GRD & B1	AB

FINISHES LEGEND

FOR SERIES FN-__ DRAWINGS

NOTES:

READ IN CONJUNCTION WITH FINISHES SCHEDULE

PAINT FINISHES
Unless indicated

WALL	= P1
SKIRTINGS	= P2
WINDOWS	= P2
PLASTERBROAD CEILING	= P1

ALL PERIMETER WINDOWS
Have blind's see Finishes Schedule
ref.: WDT3

C1 — FLOOR FINISH
REFER TO FINISHES SCHEDULE.

DIRECTION OF FLOOR FINISH

CHANGE IN FLOOR FINISH

MOVEMENT JOINT

FLOOR FINISH
REFER TO SCOPE AND FINISHES SHEDULE

INDICATES EXTENT OF FINISH

W1 — WALL FINISH
SK1 — SKIRTING FINISH

WDT1 — WINDOW AND OR MANIFESTATION TREATMENT