




SERVICE CORRIDOR

3.24
conc floor

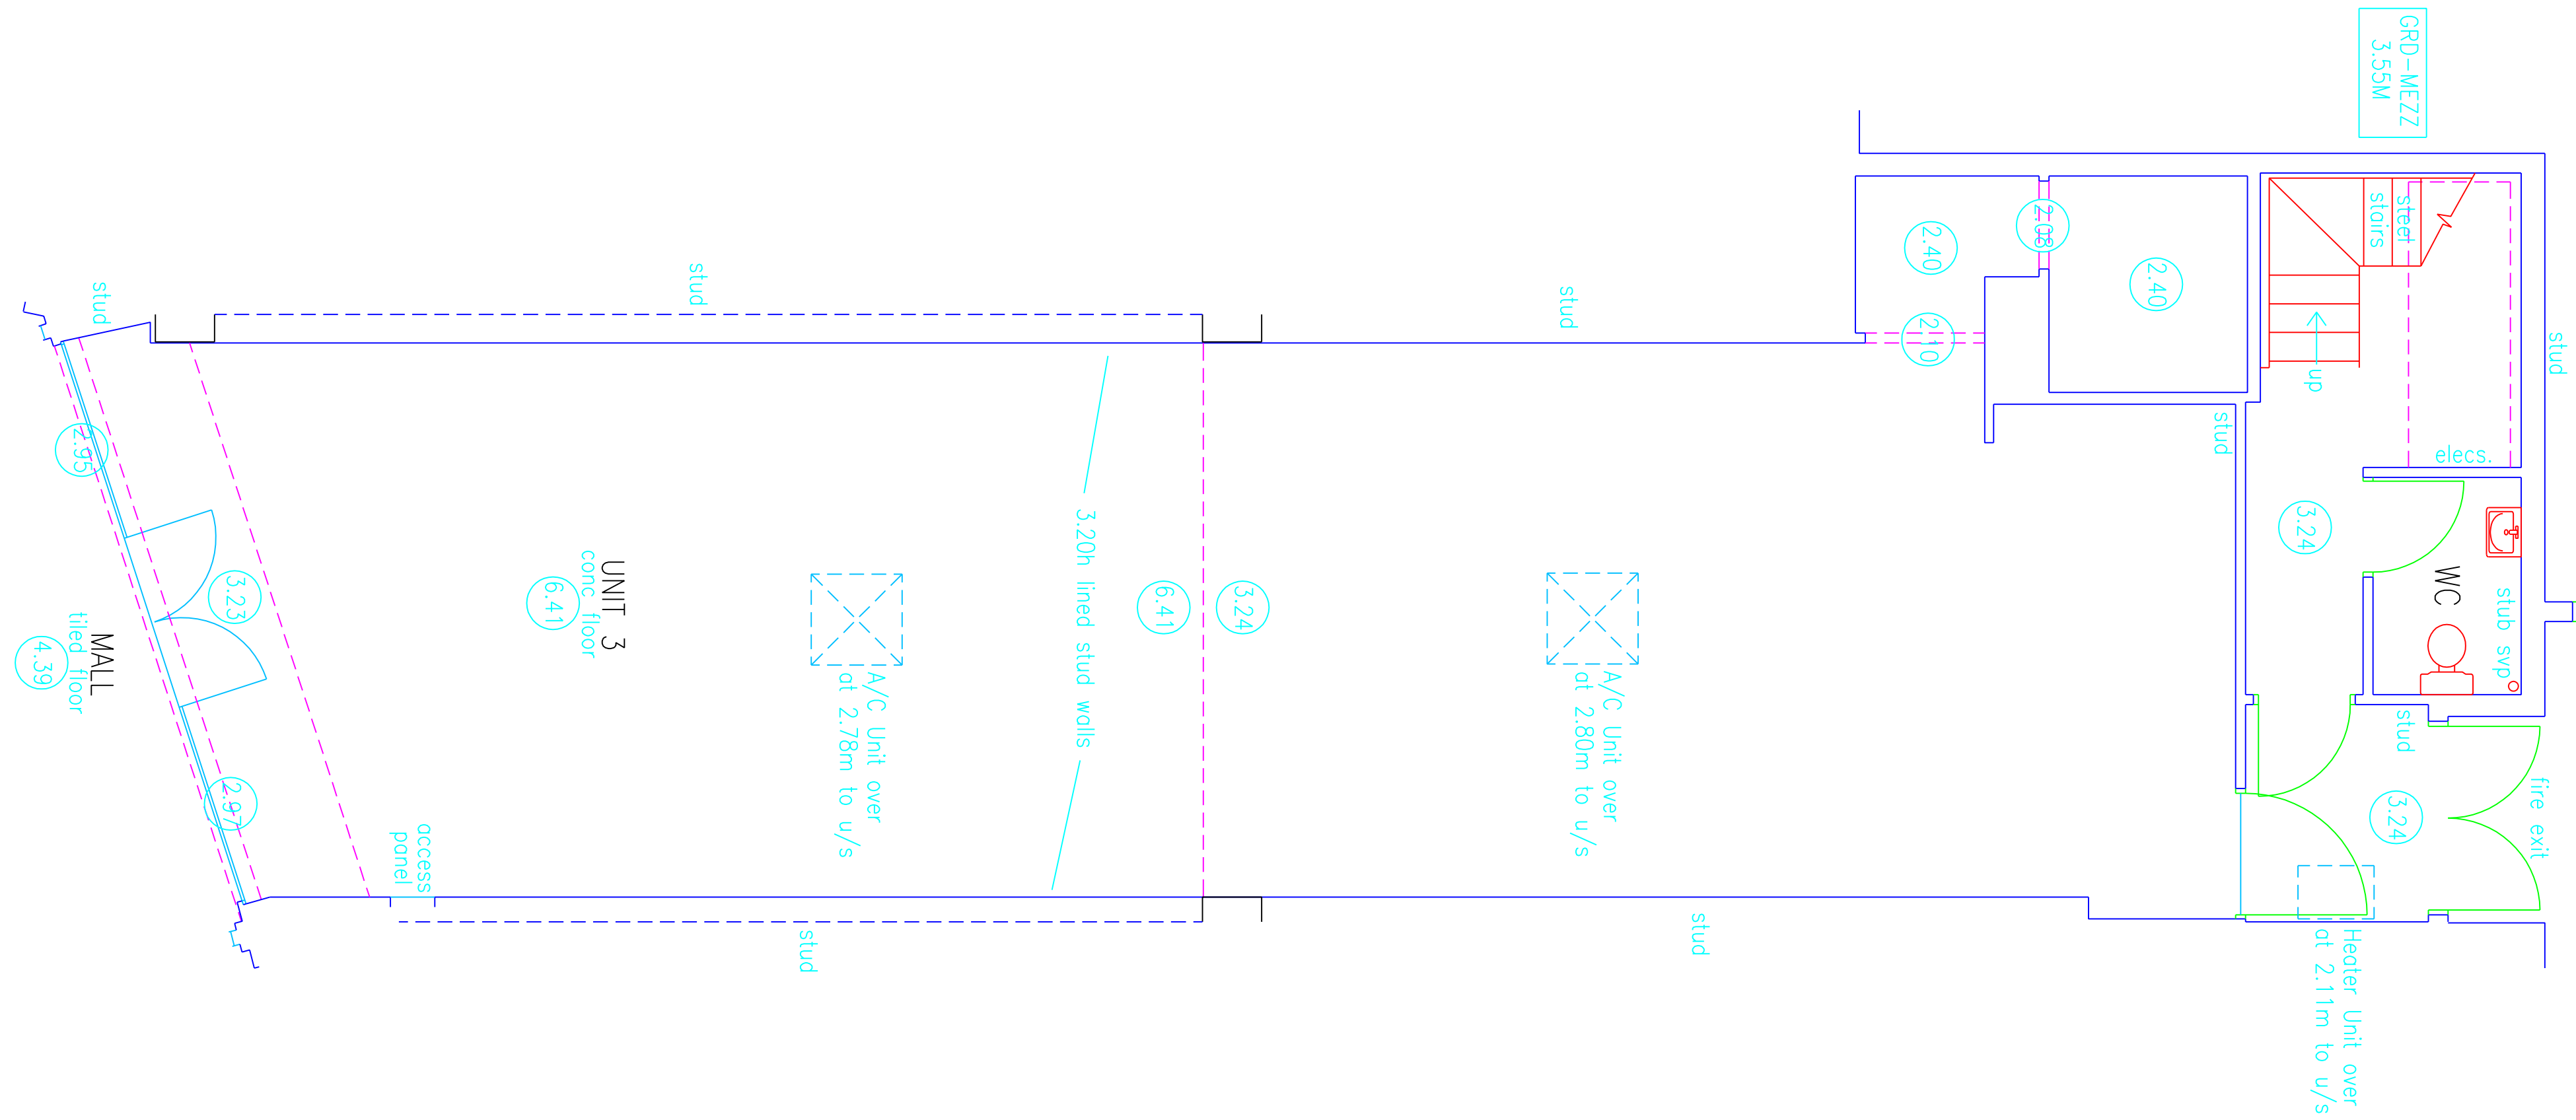

SERVICE CORRIDOR

2.90
conc floor

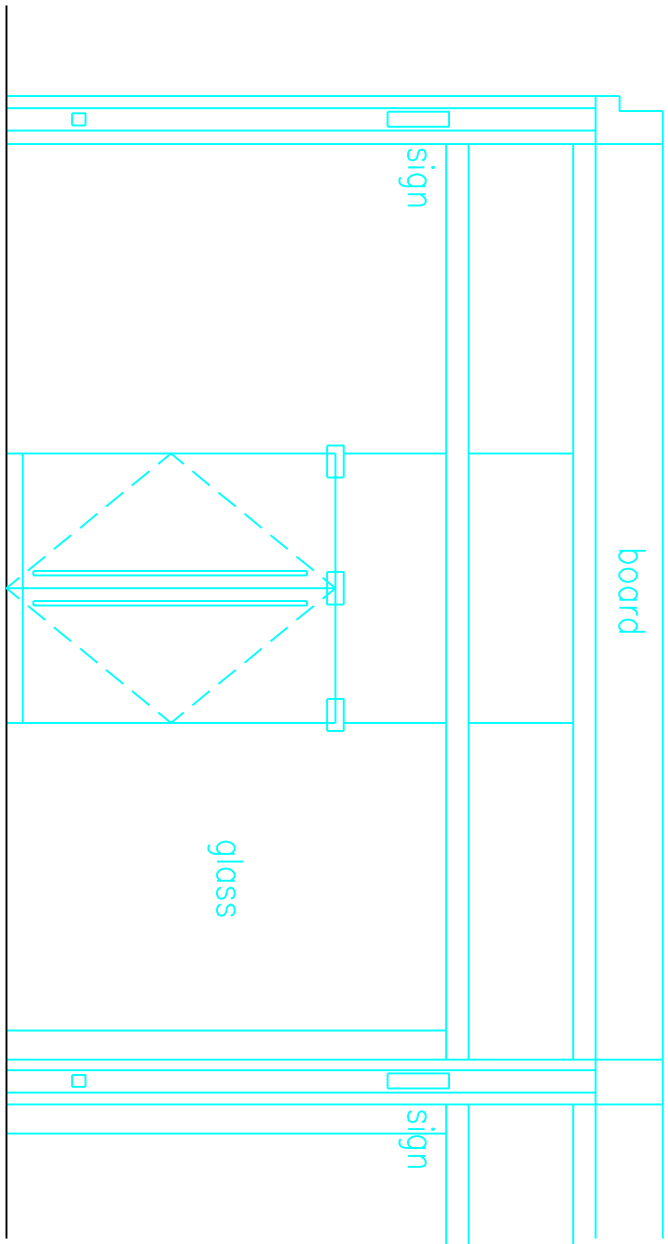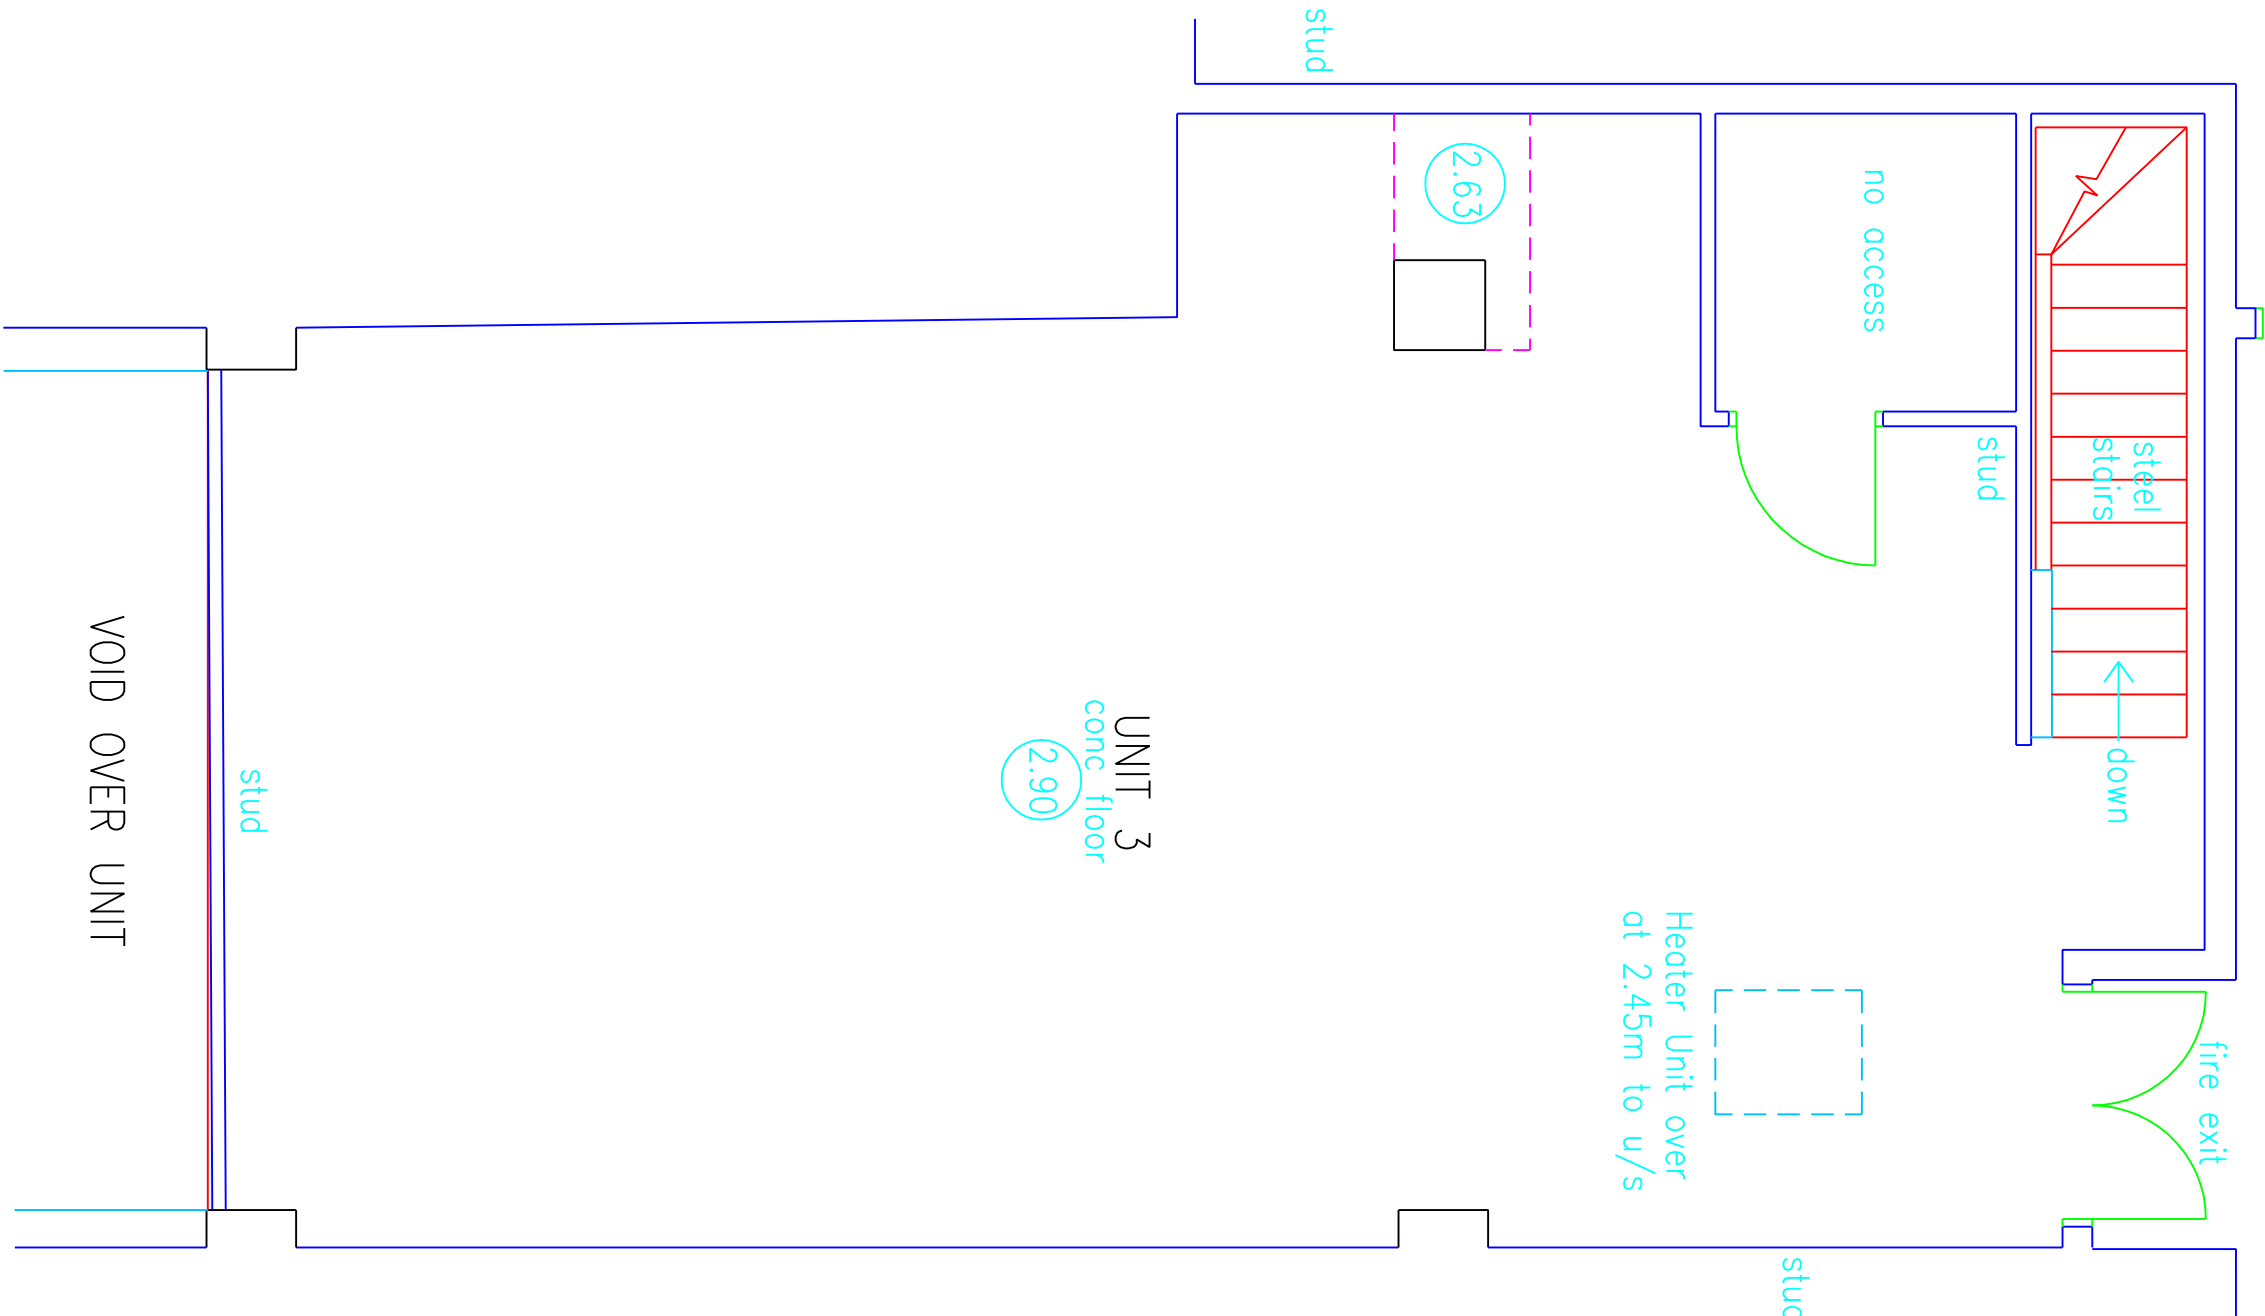


NOTES

PROJECT
UNIT 3 RESORTS WORLD.
BIRMINGHAM.

CLIENT
GENTING CASINO'S

DRAWING
FLOOR PLANS & ELEVATION

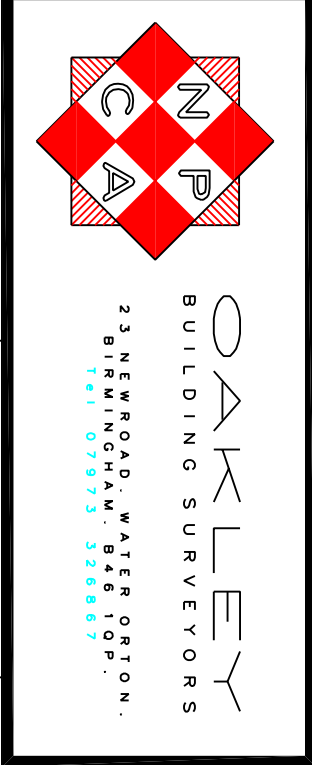

SCALE
1:50 (A1)
DATE
JAN 23

DRG No
5420-02

REV