


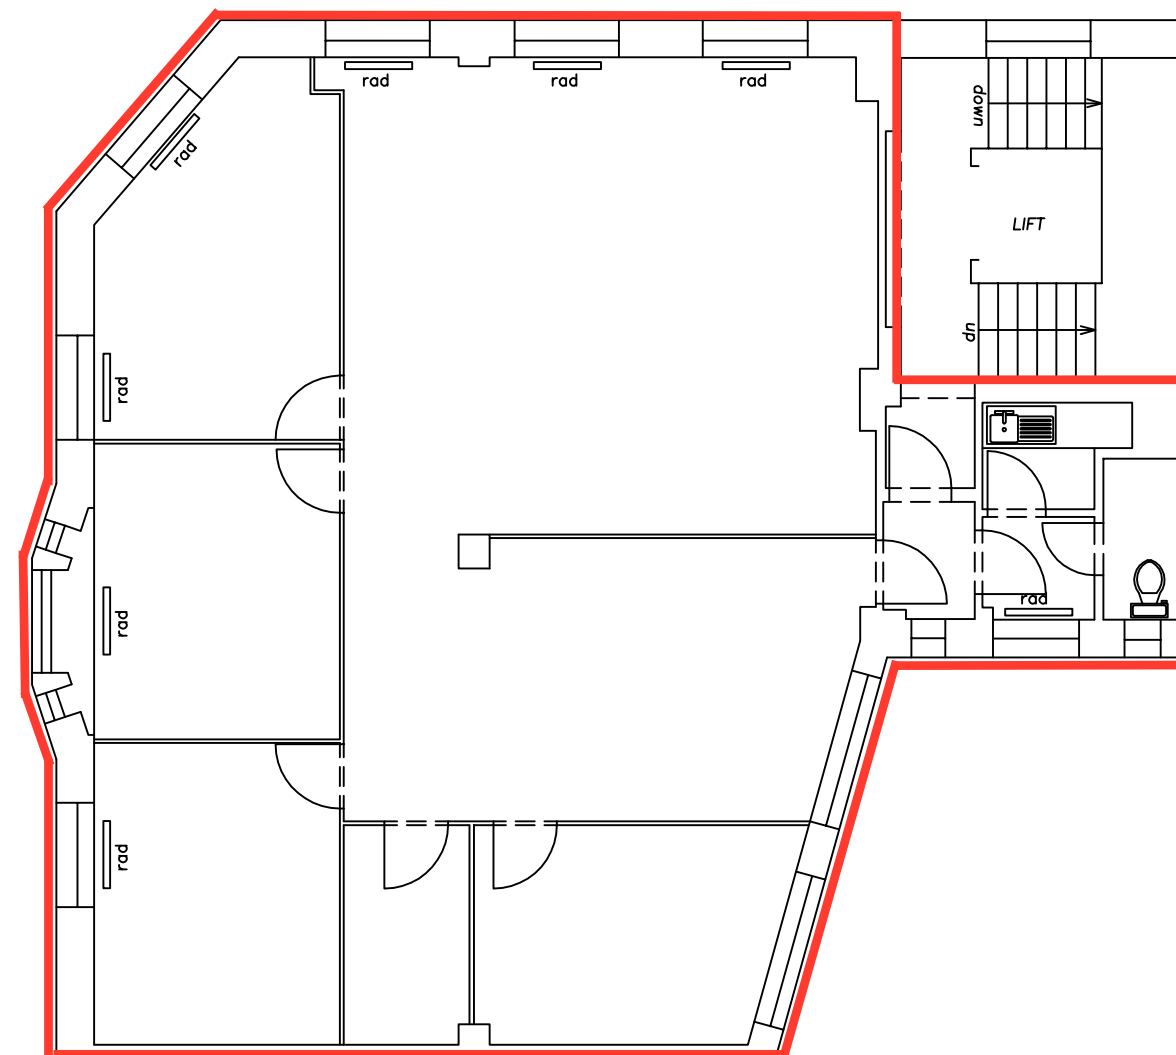

KEY

(n.nn)	CEILING HEIGHT
(Fn.nn)	FALSE CEILING HEIGHT
USB	UNDERSIDE OF BEAM
FC	FLOOR TO CILL HEIGHT
CH	CILL TO HEAD HEIGHT
DH	DOOR HEAD HEIGHT
x 9.99	FLOOR LEVEL
SPR	SPRINGER HEIGHT
CRO	CROWN HEIGHT



GRYPHON SURVEYS

Hanover House
78-82 High Street
Brentwood, Essex CM14 4AP
Telephone: 01277-212794
Fax: 01277-214928

e-mail: admin@gryphonsurveys.co.uk
www.gryphonsurveys.co.uk

Project: HIGHLIGHT HOUSE
57 MARGARET STREET
LONDON, W1

Title: FIRST

Drawn
S.K
Checked

Scale
1/100@a3

Date
09/10

Ref:
57MS