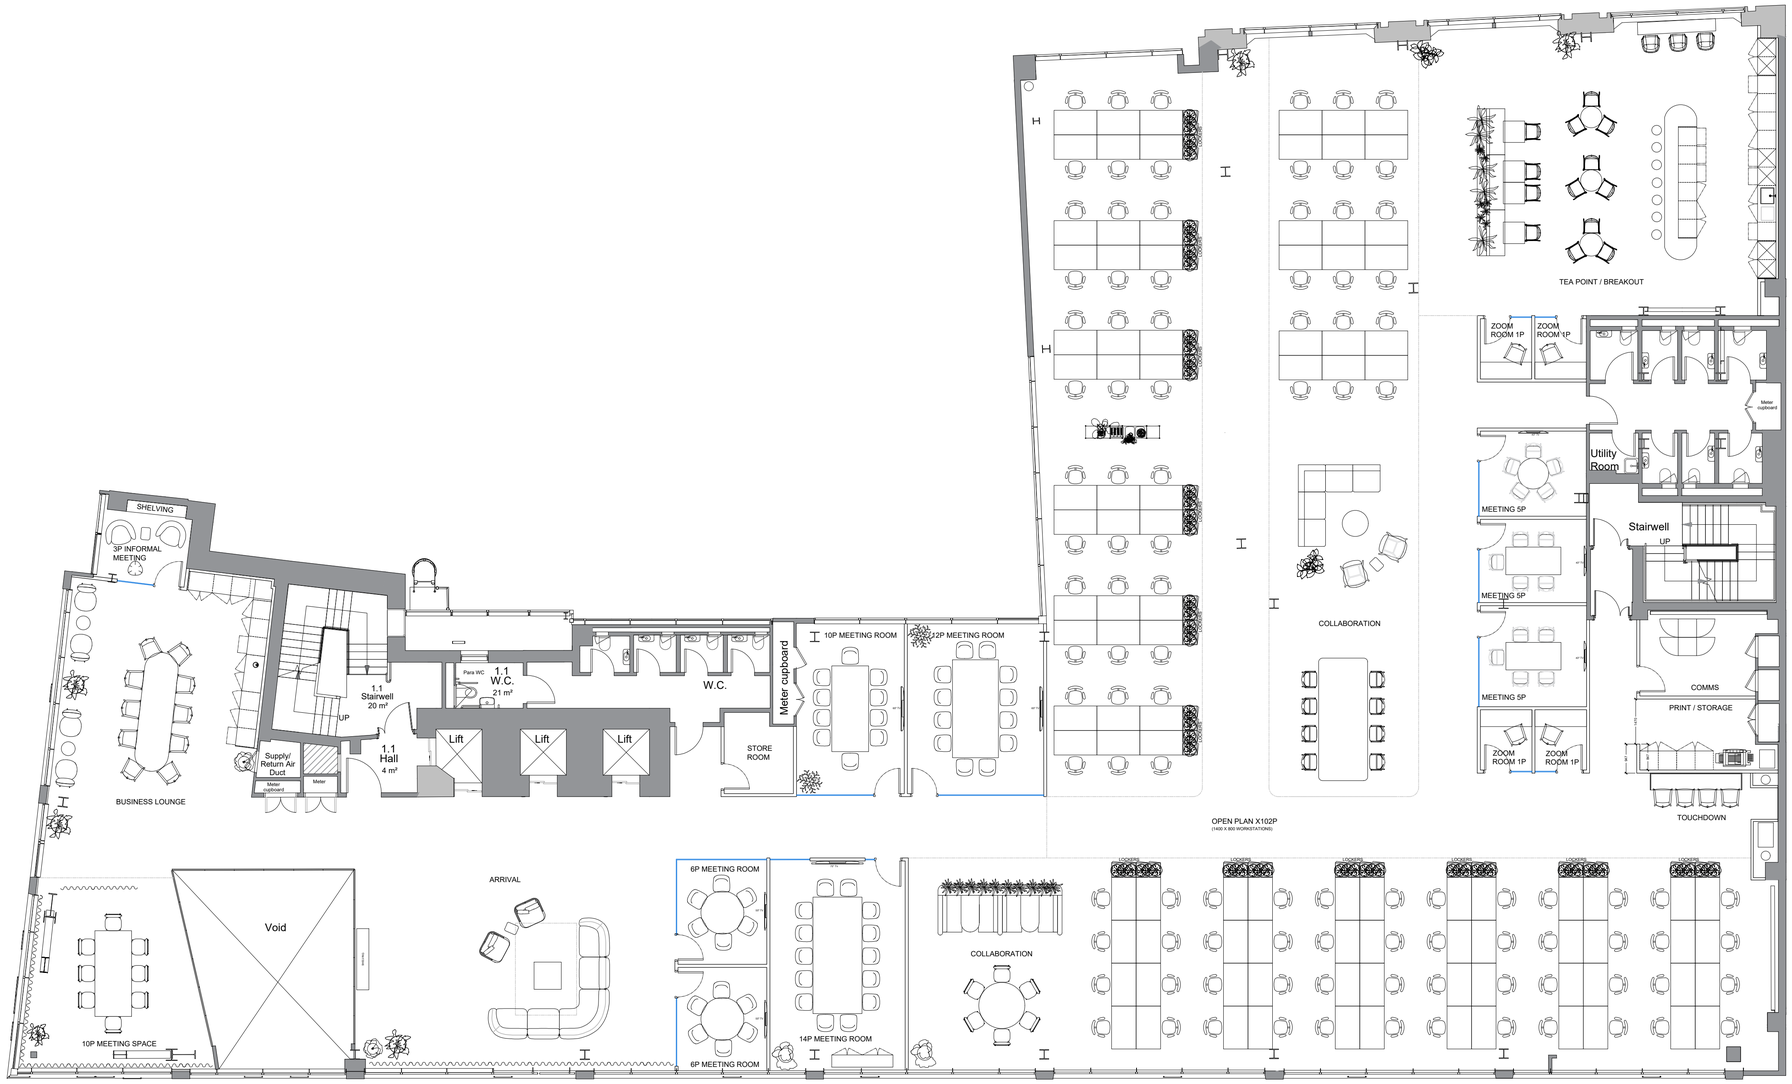

GENERAL NOTES

REV	DATE	DESCRIPTION	DRW BY	CHK BY

RECORD DRAWINGS
TI1850
VALEO CAPITAL
70 WILSON STREET
LONDON, EC2A 2DB

© Think Inside Limited.
All designs are the sole property of Think Inside Ltd. and may not be used, transferred, or disclosed to a third party without their express permission. Electronic copies of this drawing are supplied for convenience only. No dimensions or other information should be inferred from the electronic copy unless specifically shown on the hard copy drawings or specifications. Do not scale from this drawing. Figured dimensions only are to be used 'For Construction' and any scaling of the drawing will be at the Contractor's risk. Contractor to verify all dimensions, levels, and components on-site. Any discrepancies shall be addressed in writing to this office for clarification prior to the commencement of the work, otherwise the Contractor shall bear full responsibility for any associated cost. Any claims for variations or extras shall be submitted to this office for assessment prior to approval of any such variation or extra. This drawing is to be read on conjunction with all other contract documentation.

PROPOSED PLAN

LEVEL
01

www.think-inside.com
info@think-inside.com

DRAWING NO.	REVISION	SCALE
AP-00-L1	RD	1:100 @ A1