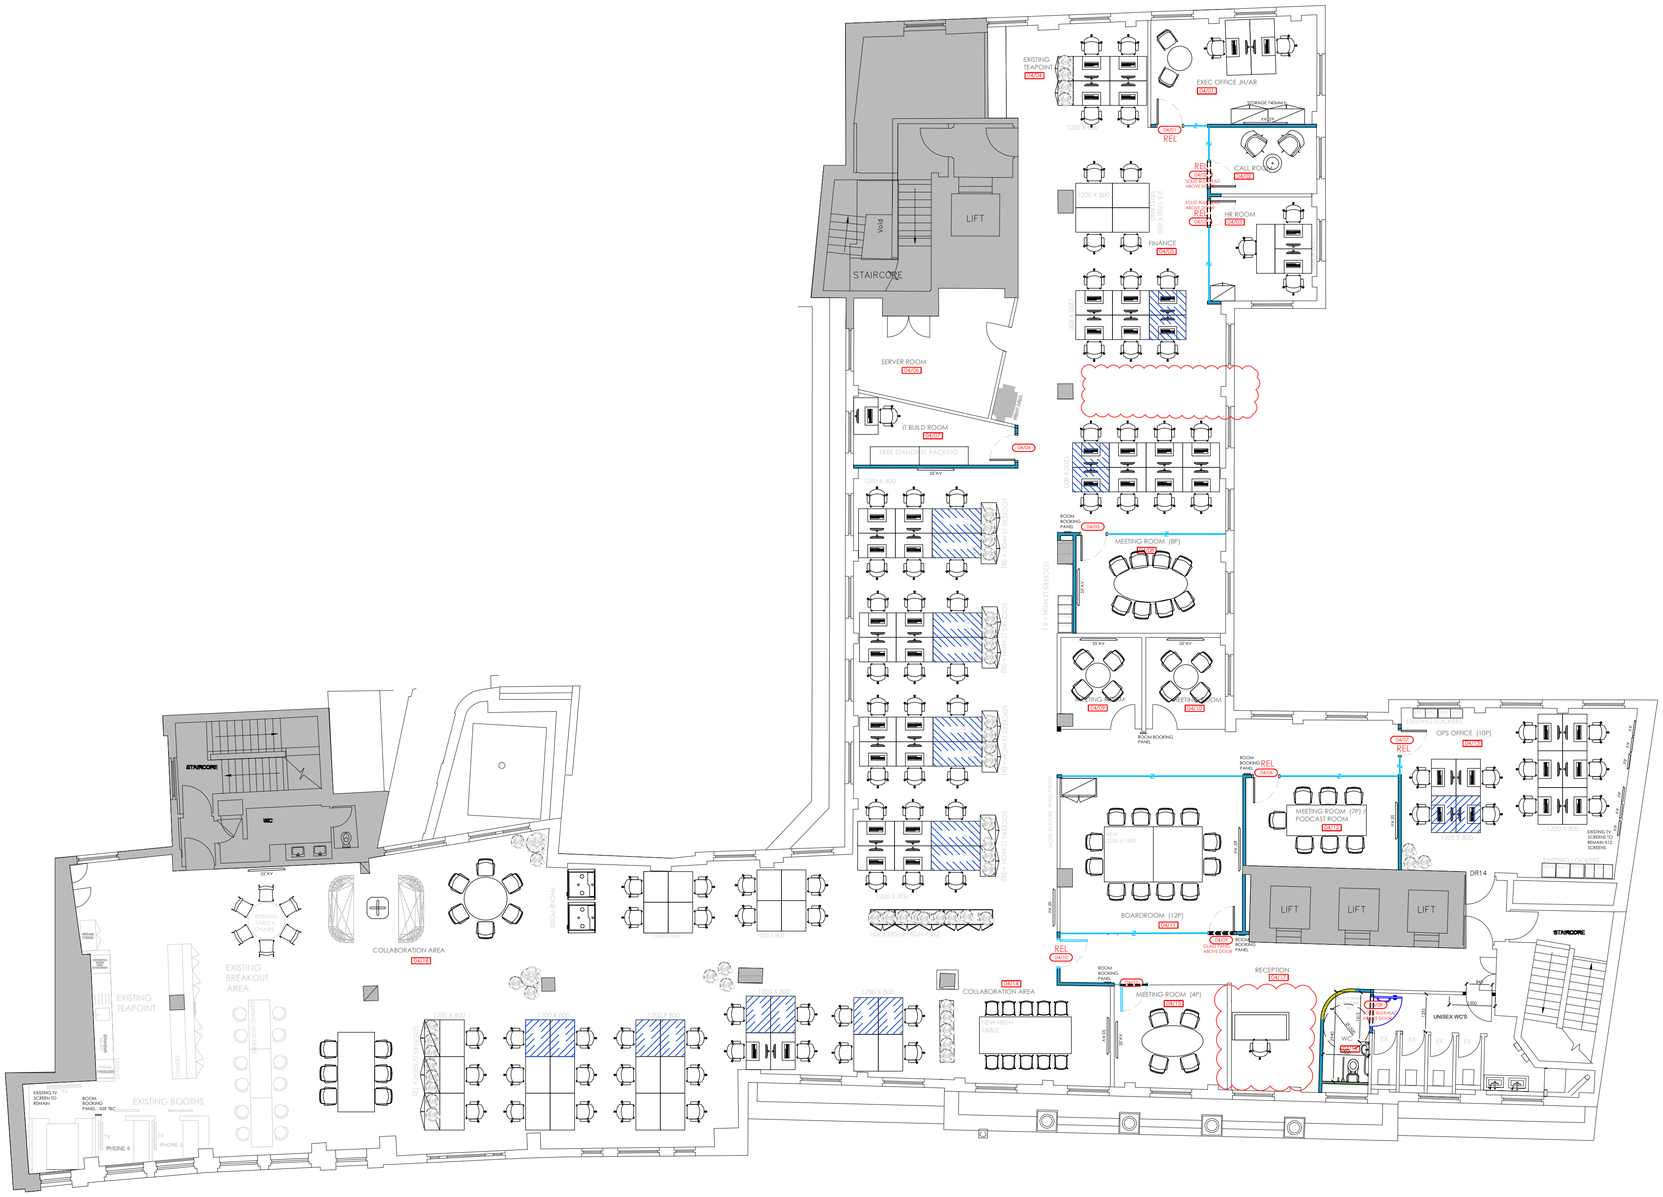

GENERAL ARRANGEMENT LEGEND

BASE BUILD INFORMATION

- HATCH/LINES INDICATIVE OF BASEBUILD SHELL
- HATCH/LINES INDICATIVE OF EXISTING DEMISE
- HATCH INDICATIVE OF LANDLORD AREAS

FURNITURE TYPES

- EXISTING FURNITURE
- NEW FURNITURE
- FURNITURE SIT/STAND DESKS
- FURNITURE OPTION/DAY 2 ALLOWANCE

PARTITIONS AND DOORS TYPES

- NEW RAF TO CL PARTITION
- NEW CURVED RAF TO CL PARTITION
- NEW RAF TO CL PARTITION
- NEW IDEPENDENT WALL LINING FROM RAF TO CL PARTITION
- NEW SINGLE GLAZED PARTITION
- NEW SINGLE SOLID CORE DOOR
- NEW GLAZED SINGLE DOOR
- NEW DOUBLE SOLID CORE DOOR
- NEW GLAZED DOUBLE DOOR
- NEW HOSPITAL SOLID CORE DOOR
- NEW SINGLE GLAZED SLIDING DOOR
- NEW SINGLE SOLID CORE SLIDING DOOR
- INDICATES ROOM NUMBER

REFER TO PARTITION TYPES AND PARTITION SETTING OUT DRAWINGS FOR ADDITIONAL DETAILS

GENERAL REFERENCES

- INDICATIVE OF TWO HEIGHT STORAGE UNIT
- INDICATIVE OF THREE HEIGHT STORAGE UNIT
- INDICATIVE OF FOUR HEIGHT STORAGE UNIT
- GENERAL STORAGEWALL
- COATS STORAGEWALL
- HATCH INDICATIVE OF SPECIALIST JOINERY
- TAG INDICATIVE OF JOINERY REFERENCE

DRAWING TO BE READ IN CONJUNCTION WITH SCOPE OF WORKS

N

FLOOR PLATE AREA: 7,800 SQFT

DRAWING APPROVED FOR CONSTRUCTION

REV	DESCRIPTION	DRWN	CHKD	DATE
G	EXISTING PARTITION/ STORE WALL REMOVED + RECEPTION DESK LOCATION	JLM		22/08/24
F	ISSUED FOR CONSTRUCTION	JLM		09/07/24

DRAWING STATUS

CONSTRUCTION

CLIENT

Calastone

PROJECT ADDRESS

4th Floor
Birchin Court
20 Birchin Lane, EC3V 9DU

TITLE

LEVEL 04
GENERAL ARRANGEMENT

SCALE	1:100@A1	DATE	01/12/2023
DRAWN	JLM	CHECKED	FH

PROJECT NO	BLDG.	FLOOR	DETAIL	REV.
23-7197	01	04	GA	REV_G

AIS

Ground Floor, St Paul's House, 10 Warwick Lane, London, EC4M 7BP
Tel: 020 7101 1177
enquiries@aisworkplace.com
www.ais-interiors.com

The copyright in this drawing is vested in Advanced Interior Solutions Group Companies Limited and its subsidiary companies ("AIS"), and no license or assignment of any kind has been, or is, granted to any third party whether by provision of copies, originals or otherwise, unless agreed expressly in writing by AIS. This drawing may not be copied, shown or given to a third party unless agreed expressly in writing by AIS.
© Copyright AIS

Layouts and all dimensions are subject to confirmation on site prior to commencement of any works. Do not scale from this drawing. AIS cannot accept responsibility for the accuracy of scaled plans supplied to us by third parties in either hard copy or PDF formats.