




Note:  
All levels relate to Local Datum.  
Dashed lines are assumed. Unable to fully  
survey. Hidden survey detail shown faint.

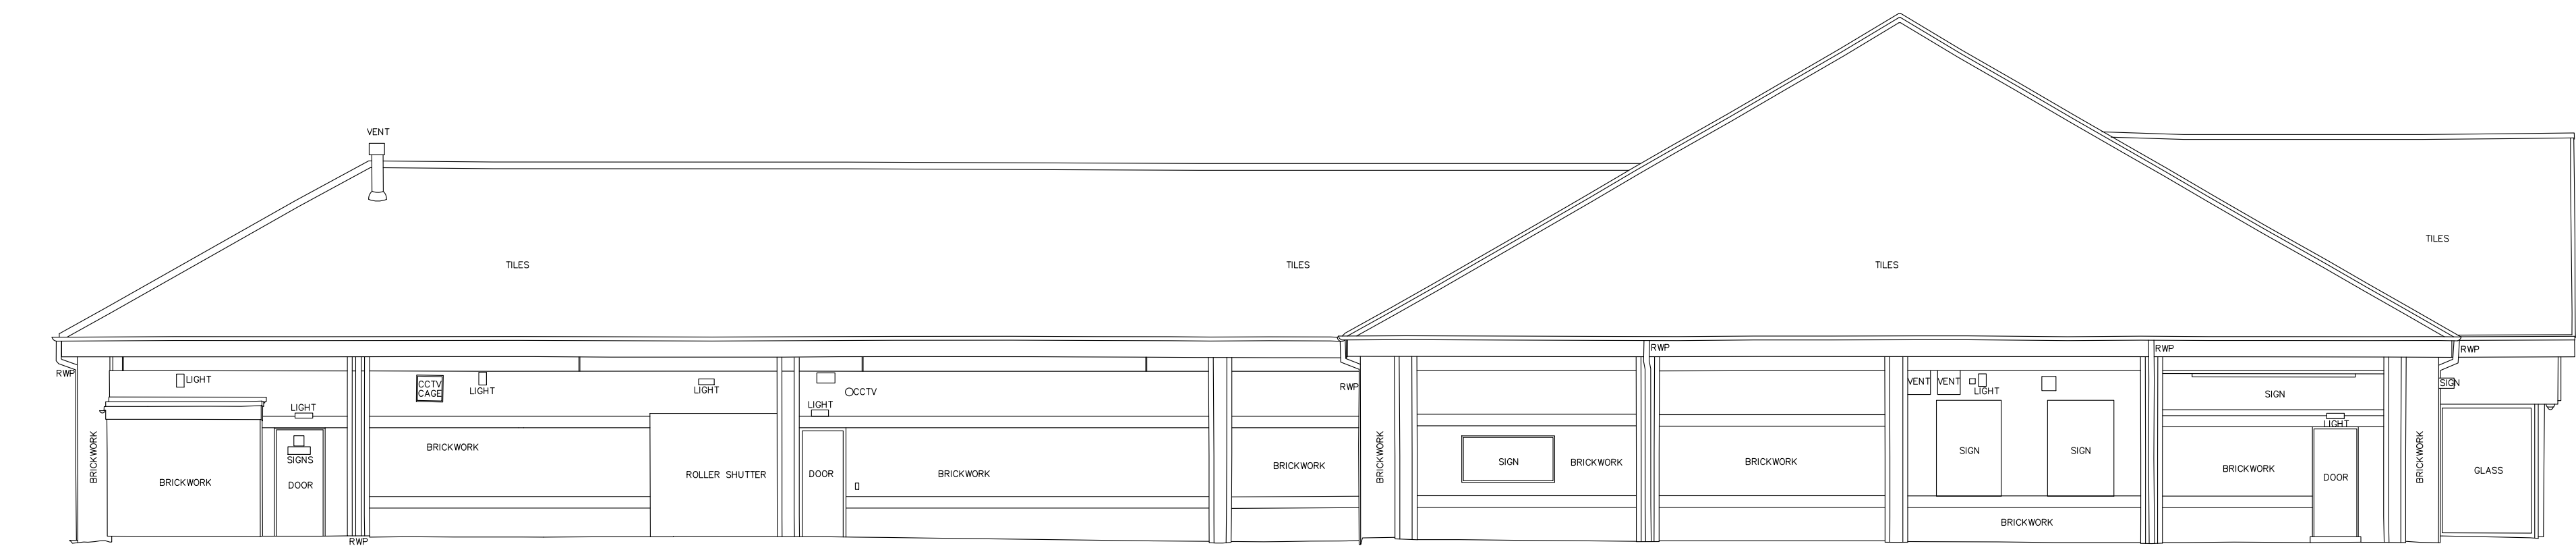


Datum 4.00m  
Elevation 1

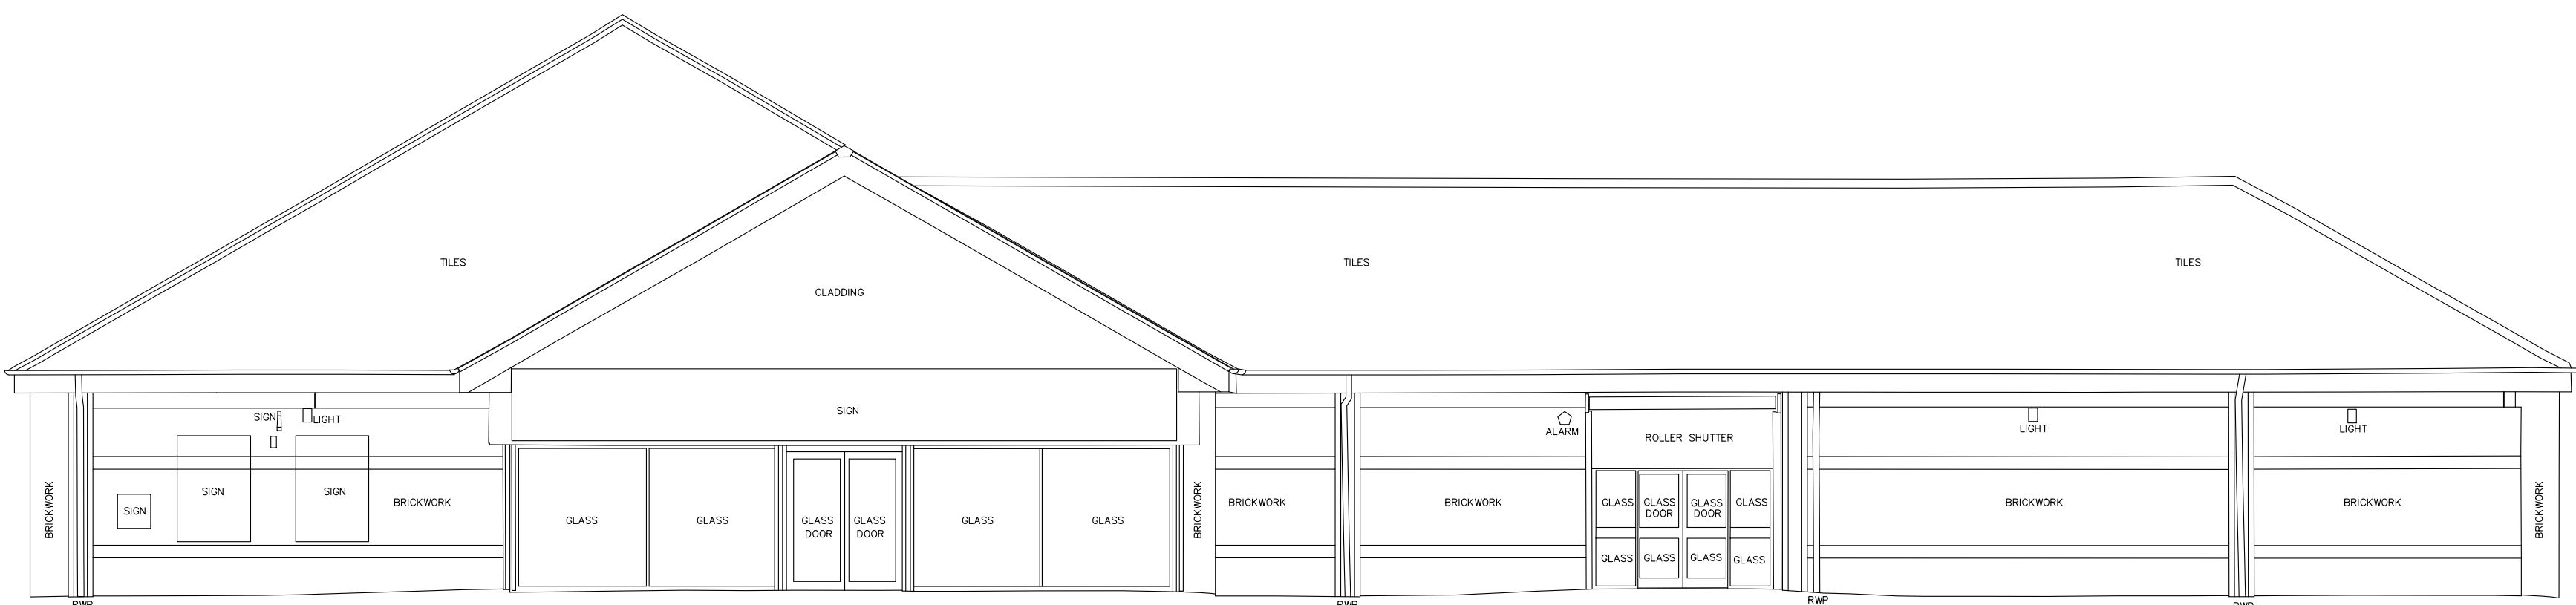


Datum 4.00m  
Elevation 2

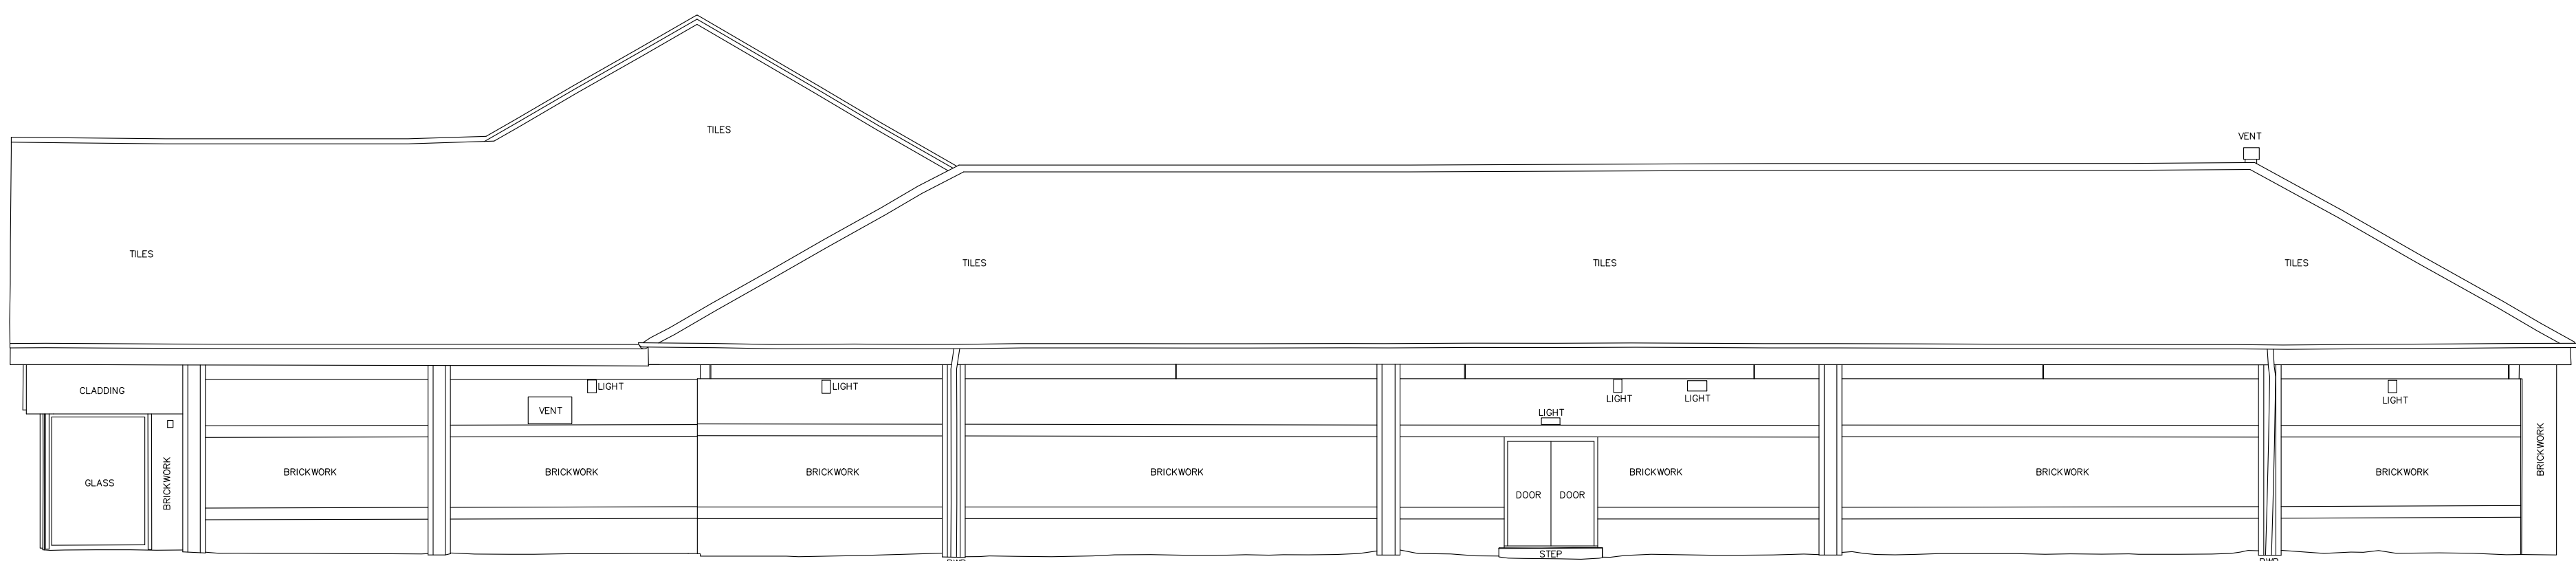


Datum 4.00m  
Elevation 3

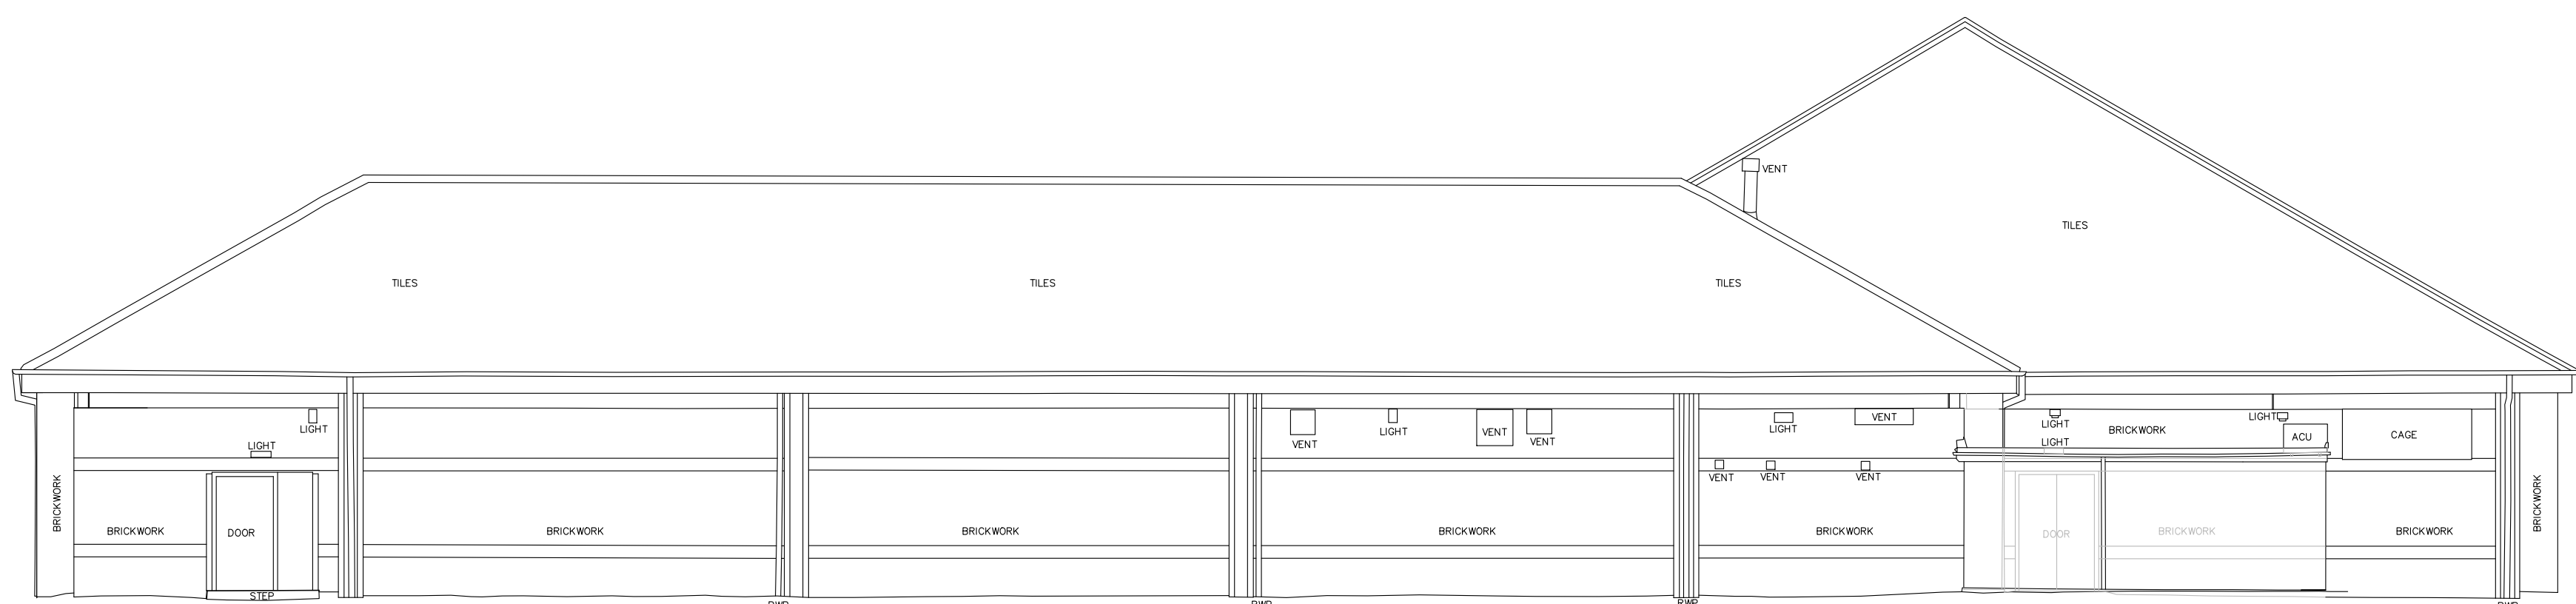

Datum 4.00m  
Elevation 4

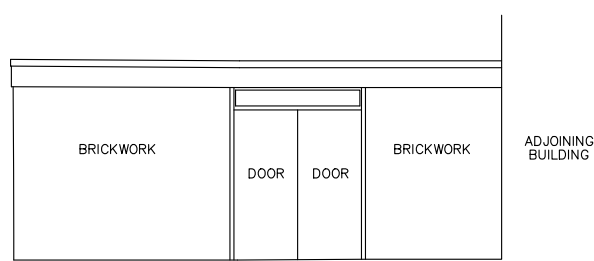

Datum 5.00m  
Elevation 5

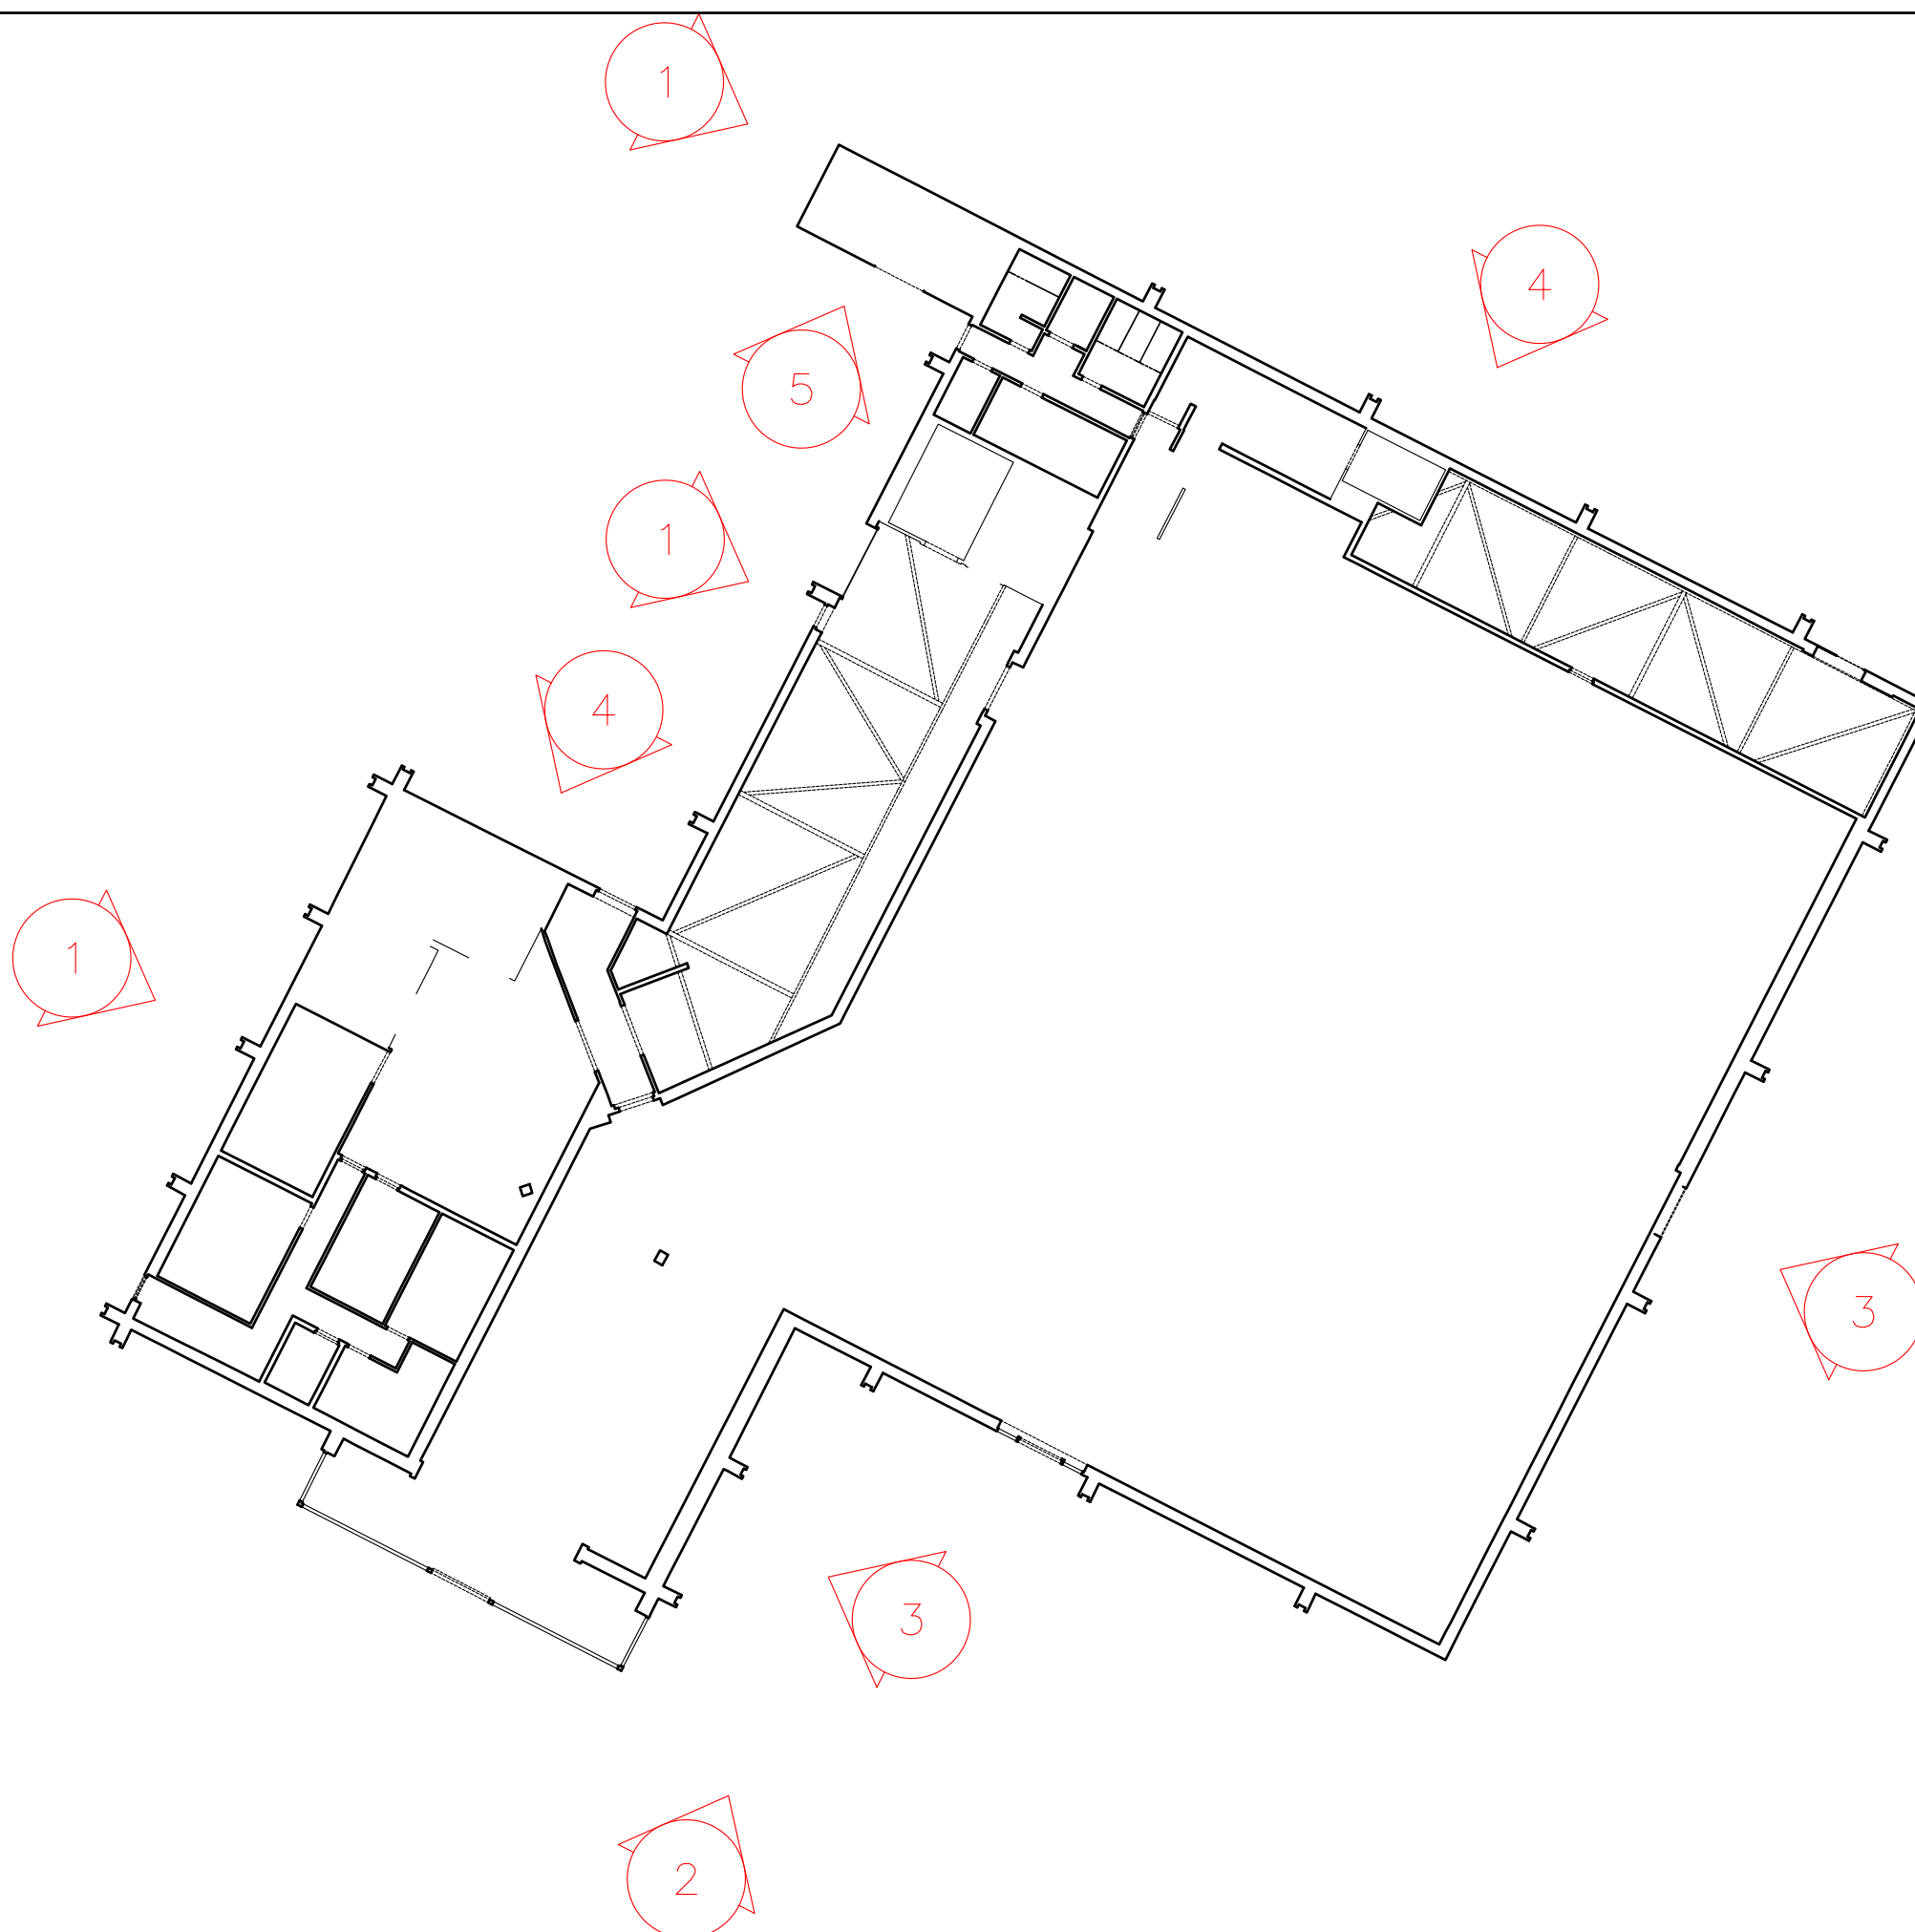

ELEVATION LOCATION PLAN  
(NOT TO SCALE)



Smith Street, Skelmersdale, Lancs. WN8 8LN  
Tel: 01695 725662 Fax: 01695 51816  
Email: mail@surveys.co.uk - www.surveys.co.uk

Client  
Northhold Group

Drawing Title  
Elevational Survey at:  
The Redgate Centre  
Bridgewater

Scale(s)  
1:100

Date  
Jul 20

Job Number  
20F252

Surveyor  
MS

Drawn  
AM

Checked  
SO

Sheet Size & Org Number & Revision  
A0 20F252/002