

All levels are related to the Ordnance Survey national grid by means of GPS using the Leica Smartnet RTK network.

All dimensions are in meters.

Do not scale from this drawing

Where built-in cupboards are present, the inside has been measured as the wall line and noted. Boxing-in and tunking has not been measured except where the wall line behind it cannot be established.

All measurements are taken to existing finishes or faces which are constant and represent an average face or wall line.

All window head and window sill levels are internal measurements.

Ceiling height measurements are taken to a point which best represents the general room height.



Specialist Geospatial Surveyors



Unit 5 Hoath Business Centre
Hoath Lane
Gillingham
Kent ME8 0BF

Tel: +44 (0)1634 751 002
Web: www.OmegaGeo.co.uk
Enquiries: survey@OmegaGeo.co.uk

CLIENT ANACOTT CAPITAL

PROJECT NO. 79 ROYAL HOSPITAL ROAD,
CHELSEA, LONDON,
SW3 4HN


TITLE	EXTERNAL ELEVATIONS
-------	---------------------

ORIGINAL SURVEY DATE	SEPT 18
----------------------	---------


SCALE	1:50 @ A1	DWG. No.	1 OF 3
-------	-----------	----------	--------

JOB Ref.	18-0589	CAD FILE	ELEV_03
----------	---------	----------	---------

© Omega Geomatics Ltd
This drawing and any intellectual property within it remain the property of Omega Geomatics Ltd and should not be copied or passed to any third parties without prior consent from Omega Geomatics Ltd.

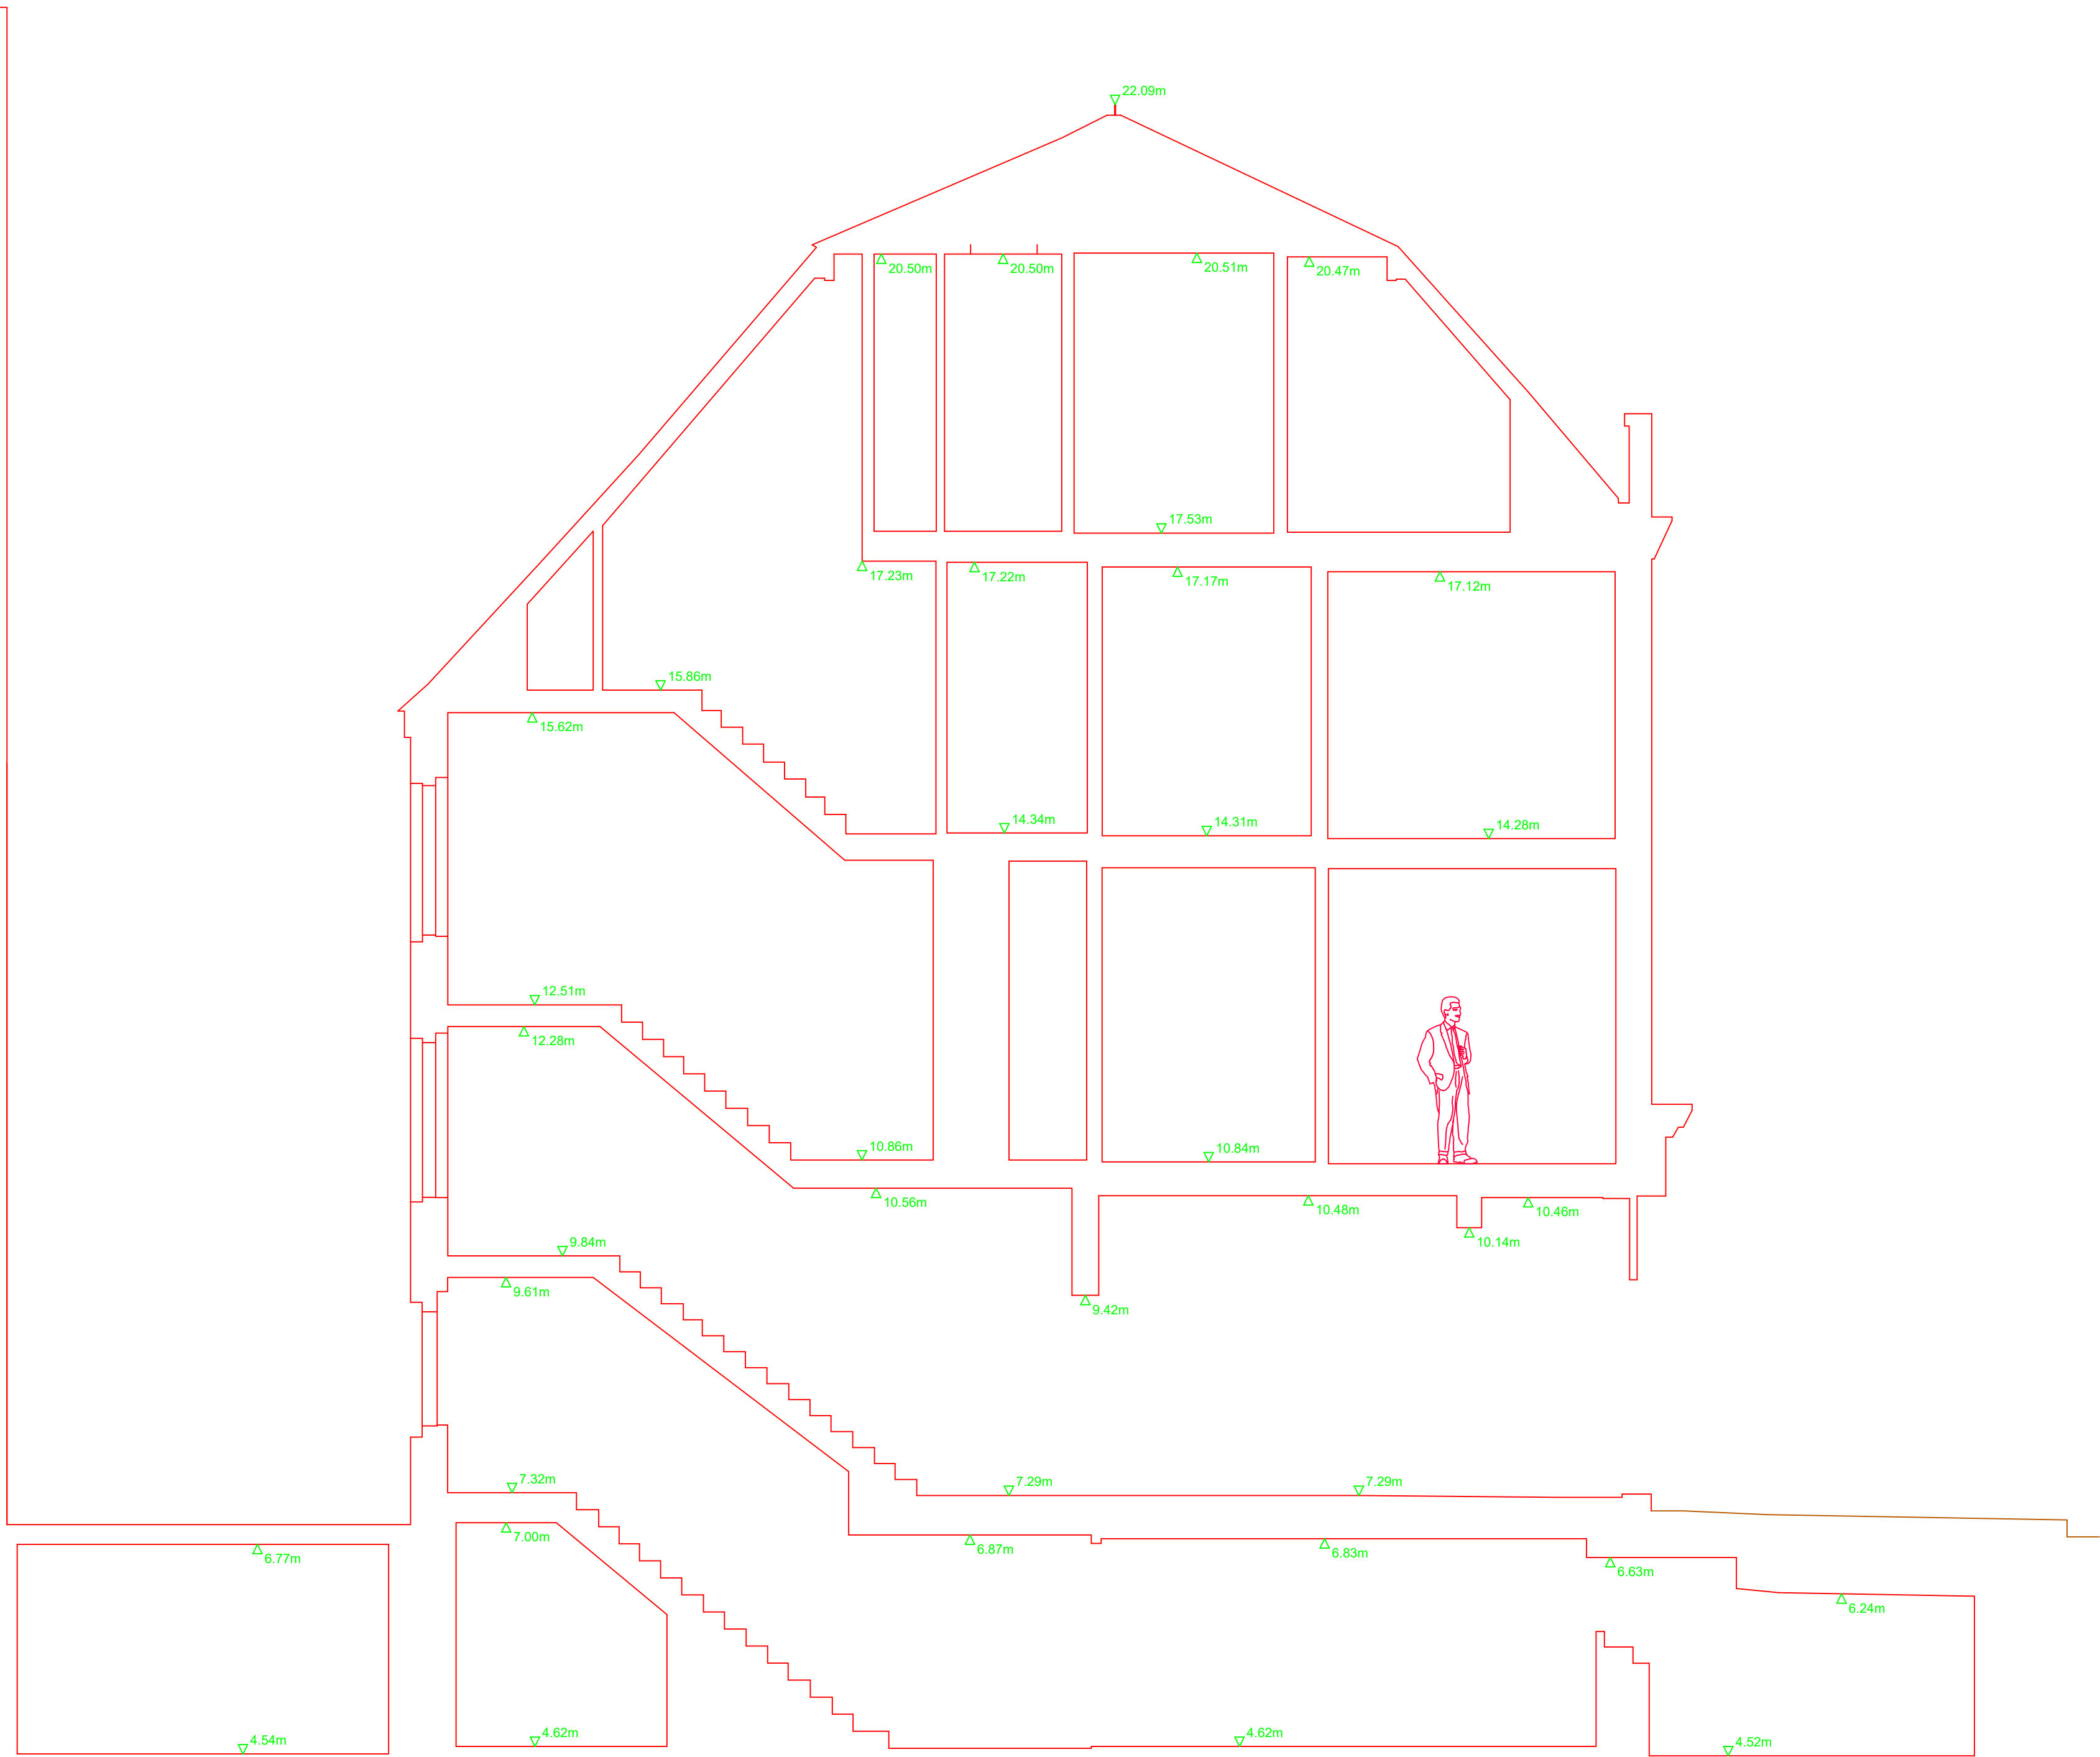

0.000m AOD
Section A

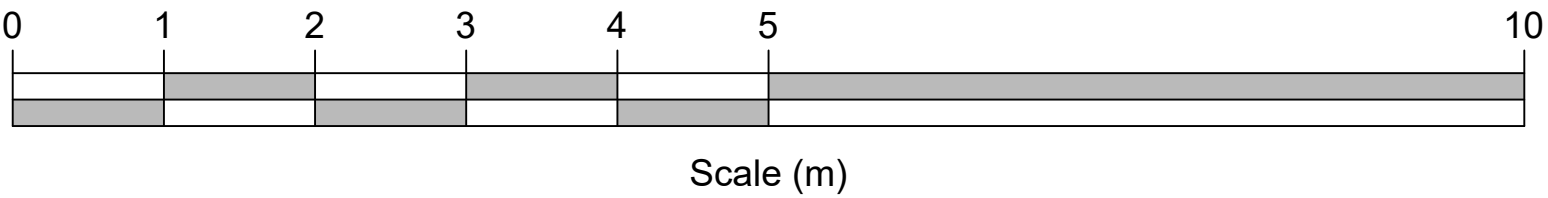

LEGEND

ACL	Arch Center Level / Height above floor
ASL	Arch Spring Level / Height above floor
C-H	Window Cill to Window Head Dimension
CLG	Ceiling Level / Height above floor
DH	Door Head Height above floor
DHL	Door Head Level
F-C	Floor to Window Cill Dimension
FL	Floor Level
RU	Ramp Up
SCLG	Suspended / False Ceiling Level / Height above floor
SL	Sub Level
SU	Steps Up
TH	Threshold Height above floor
THL	Threshold Level
TWL	Top of Wall Level
US	Underside Level / Height above floor
USB	Underside of Beam level / Height to underside above floor
USL	Underside of Joist level / Height to underside above floor
WACL	Window Arch Center Level
WASL	Window Arch Spring Level
WCL	Window Cill Level
WHL	Window Head Level
	Sloping Roof
	Sloped Ceiling (Points up)
	Arched / Vaulted Ceiling
	Building Line / Wall Line
	Detail / Steps
	Overhead Detail
	Partitions
	Glazing

NOTES

All levels are related to the Ordnance Survey national grid by means of GPS using the Leica Smartnet RTK network.

All dimensions are in meters.

Do not scale from this drawing.

Where built-in cupboards are present, the inside has been measured as the wall line and noted. Boxing-in and trunking has not been measured except where the wall line behind it cannot be established.


All measurements are taken to existing finishes or faces which are constant and represent an average face or wall line.

All window head and window cill levels are internal measurements.

Ceiling height measurements are taken to a point which best represents the general room height.

Drawing Revisions

Rev No.	Date	Details
Original	See below	Original survey carried out

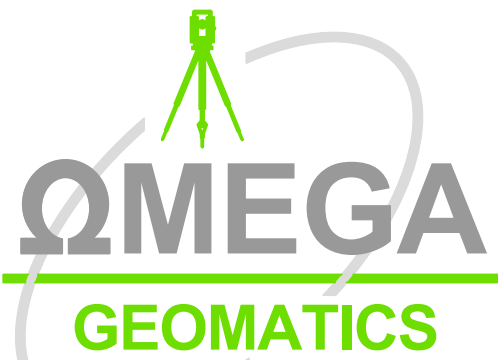

Specialist Geospatial Surveyors



Unit 5 Hoath Business Centre
Hoath Lane
Gillingham
Kent ME8 0BF

Tel: +44 (0)1634 751 002
Web: www.OmegaGeo.co.uk
Enquiries: survey@OmegaGeo.co.uk

CLIENT
ANACOTT CAPITAL

PROJECT NO. 79 ROYAL HOSPITAL ROAD,
CHELSEA, LONDON,
SW3 4HN

TITLE
SECTIONS

ORIGINAL SURVEY DATE
SEPT 18


SCALE
1:50 @ A1

DWG. No.
2 OF 3


JOB Ref.
18-0589

CAD FILE
ELEV_03

© Omega Geomatics Ltd
This drawing and any intellectual property within it remain the property of Omega Geomatics Ltd and should not be copied or passed to any third parties without prior consent from Omega Geomatics Ltd.

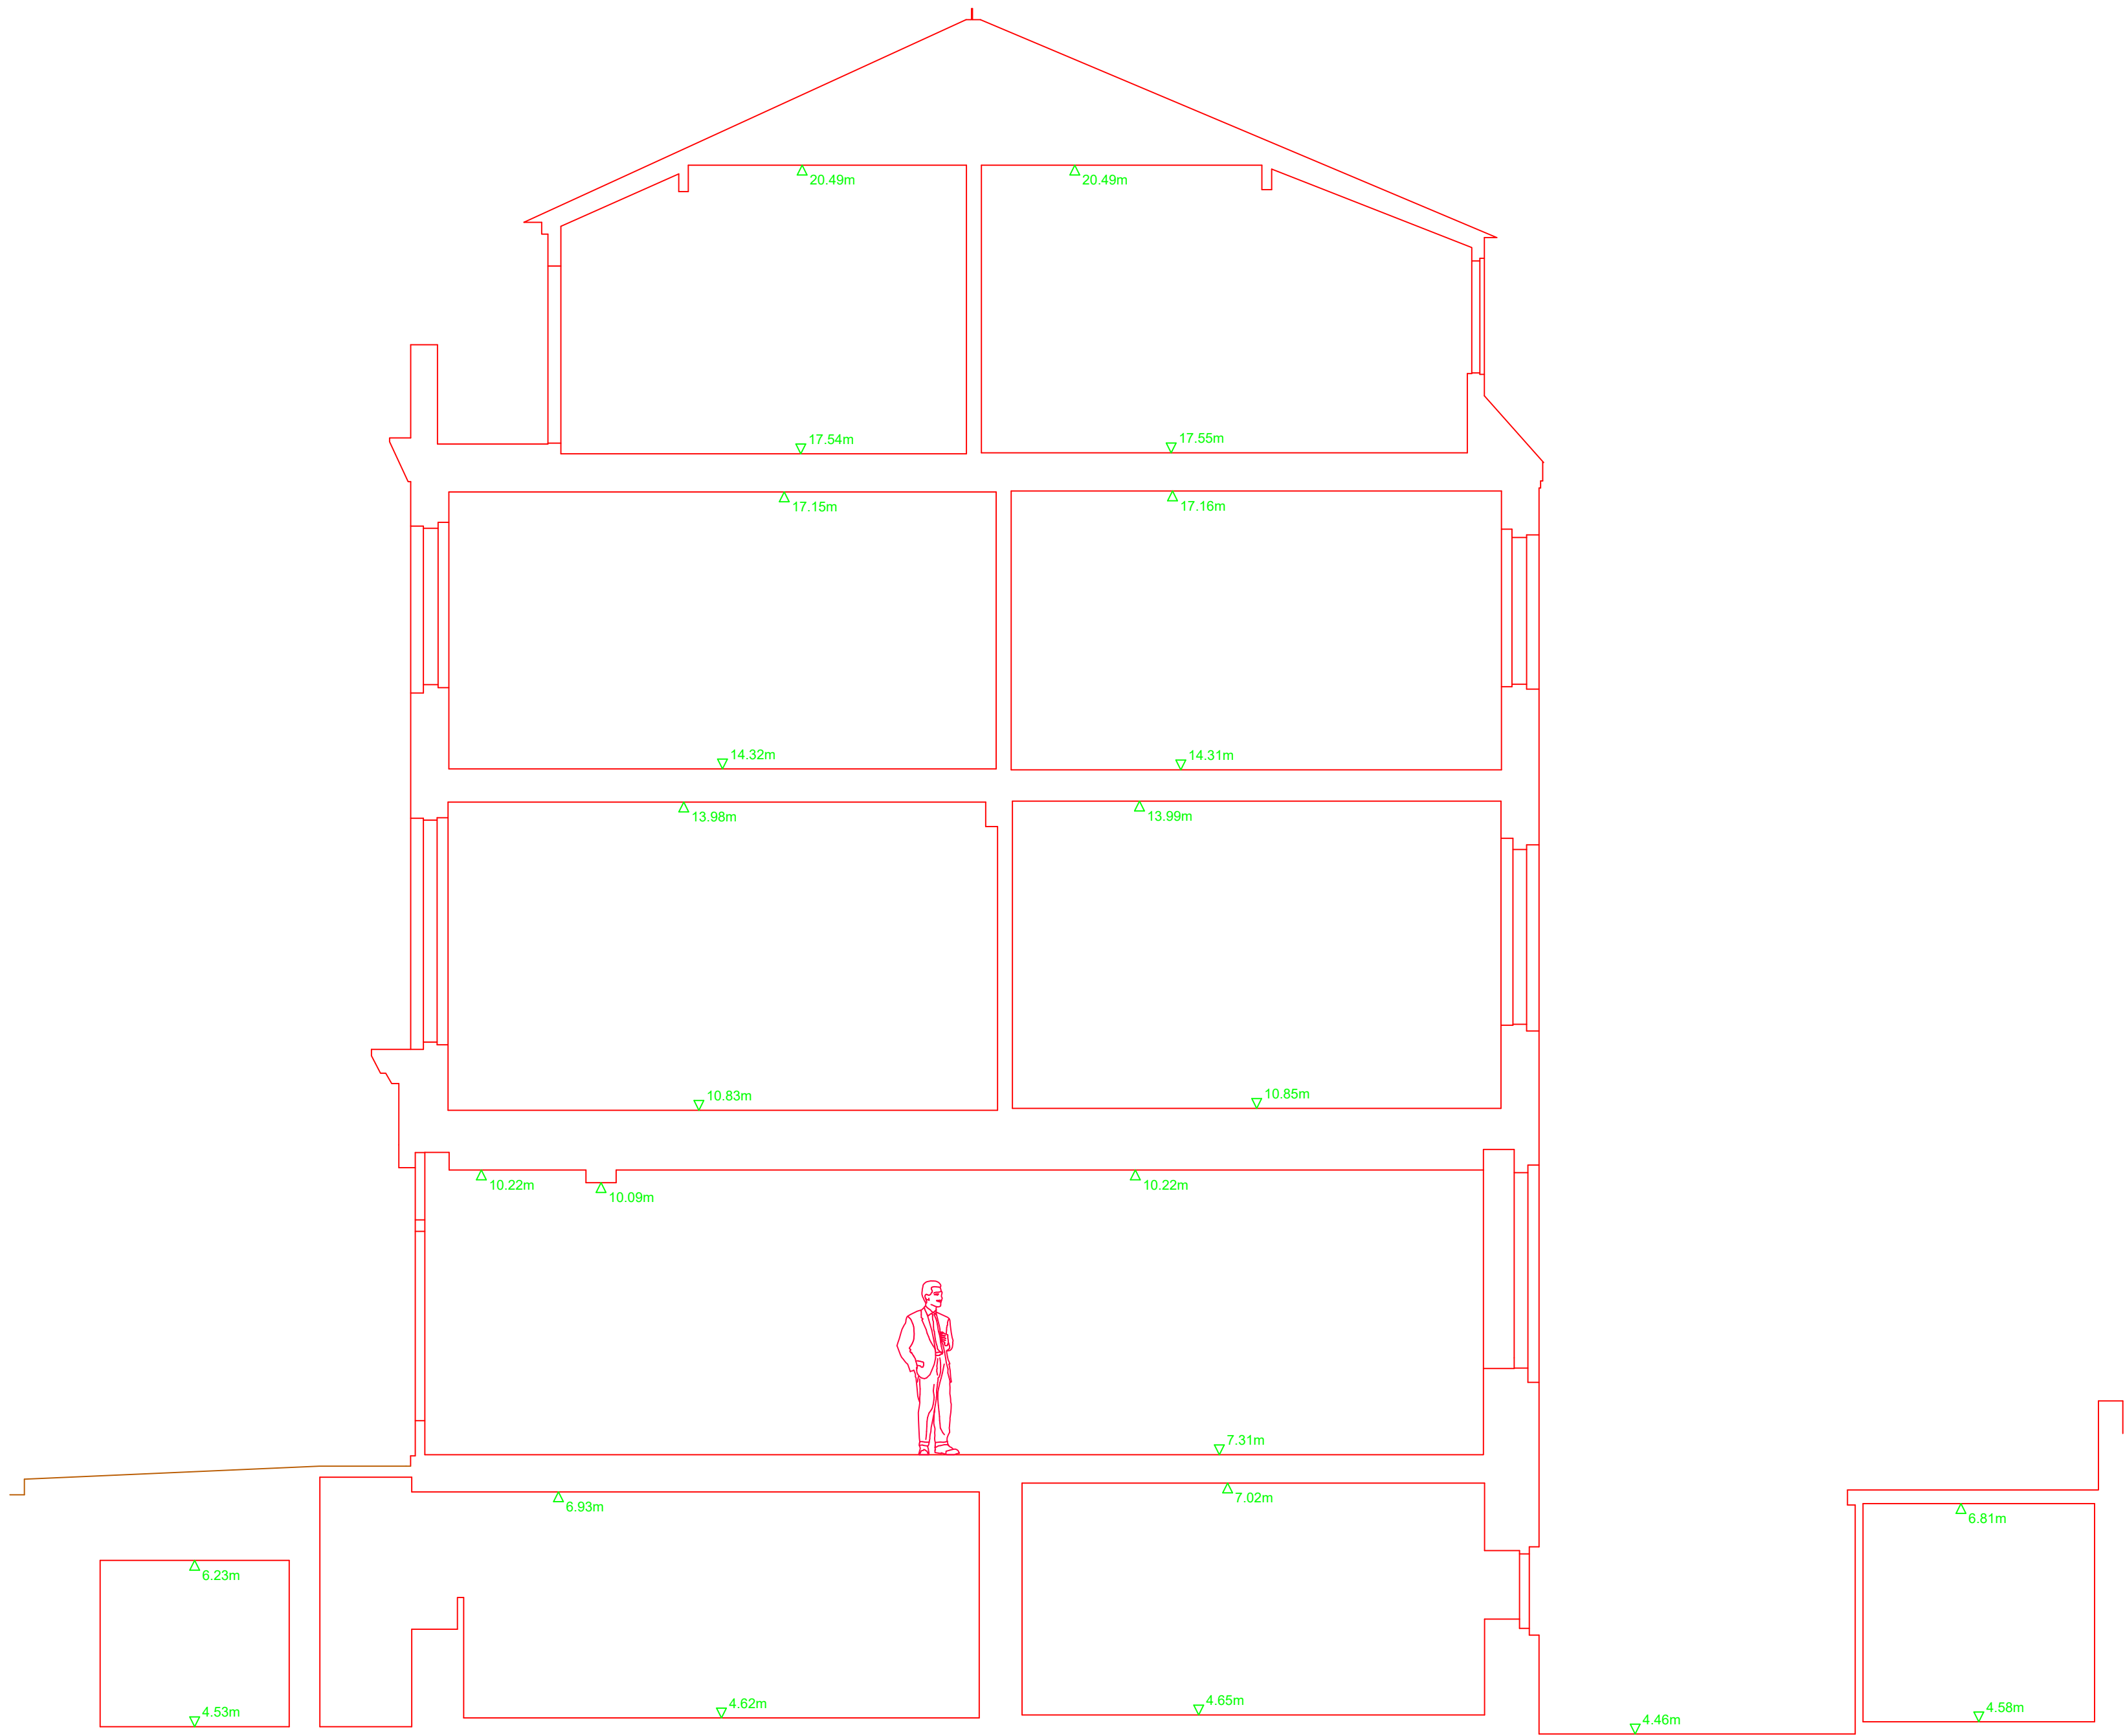

0.000m AOD
Section B

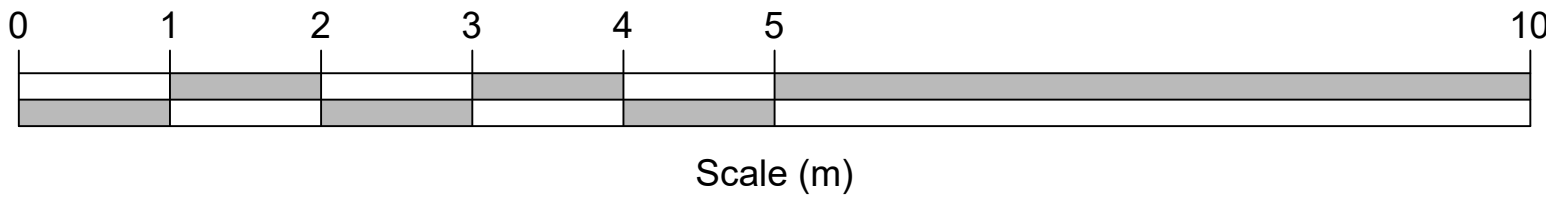

LEGEND

ACL	Arch Center Level / Height above floor
ASL	Arch Spring Level / Height above floor
C-H	Window Cill to Window Head Dimension
CLG	Ceiling Level / Height above floor
DH	Door Head Height above floor
DHL	Door Head Level
F-C	Floor to Window Cill Dimension
FL	Floor Level
RU	Ramp Up
SCLG	Suspended / False Ceiling Level / Height above floor
SL	Sub Level
SU	Steps Up
TH	Threshold Height above floor
THL	Threshold Level
TWL	Top of Wall Level
US	Underside Level / Height above floor
USB	Underside of Beam level / Height to underside above floor
USL	Underside of Joist level / Height to underside above floor
WACL	Window Arch Spring Level
WASL	Window Arch Spring Level
WCL	Window Cill Level
WHL	Window Head Level

Sloping Roof

Arched / Vaulted Ceiling

Building Line / Wall Line

Detail / Steps

Overhead Detail

Partitions

Glazing

NOTES

All levels are related to the Ordnance Survey national grid by means of GPS using the Leica Smartnet RTK network.

All dimensions are in meters.

Do not scale from this drawing.

Where built-in cupboards are present, the inside has been measured as the wall line and noted. Boxing-in and trunking has not been measured except where the wall line behind it cannot be established.


All measurements are taken to existing finishes or faces which are constant and represent an average face or wall line.

All window head and window cill levels are internal measurements.

Ceiling height measurements are taken to a point which best represents the general room height.

Drawing Revisions

Rev No.	Date	Details
Original	See below	Original survey carried out

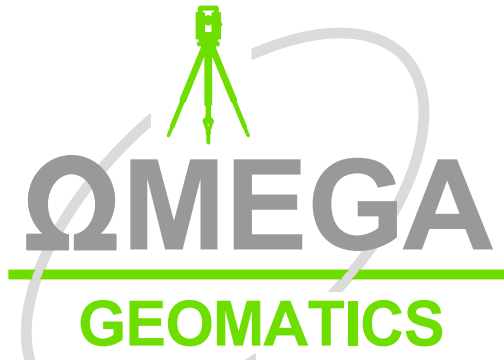

Specialist Geospatial Surveyors



Unit 5 Hoath Business Centre
Hoath Lane
Gillingham
Kent ME8 0BF

Tel: +44 (0)1634 751 002
Web: www.OmegaGeo.co.uk
Enquiries: survey@OmegaGeo.co.uk

CLIENT

ANACOTT CAPITAL

PROJECT NO. 79 ROYAL HOSPITAL ROAD,
CHELSEA, LONDON,
SW3 4HN

TITLE SECTIONS

ORIGINAL SURVEY DATE SEPT 18

SCALE 1:50 @ A1 DWG. No. 3 OF 3

JOB Ref. 18-0589 CAD FILE ELEV_03

© Omega Geomatics Ltd
This drawing and any intellectual property within it remain the property of Omega Geomatics Ltd and should not be copied or passed to any third parties without prior consent from Omega Geomatics Ltd.