



Notes

ALL LEVELS ARE IN METRES DERIVED FROM GPS TRANSFORMATION OSGM15
 THE CO-ORDINATES ARE DERIVED FROM THE ORDINANCE SURVEY ACTIVE STATION NETWORK OSTN15 (BASE STATION ST02)

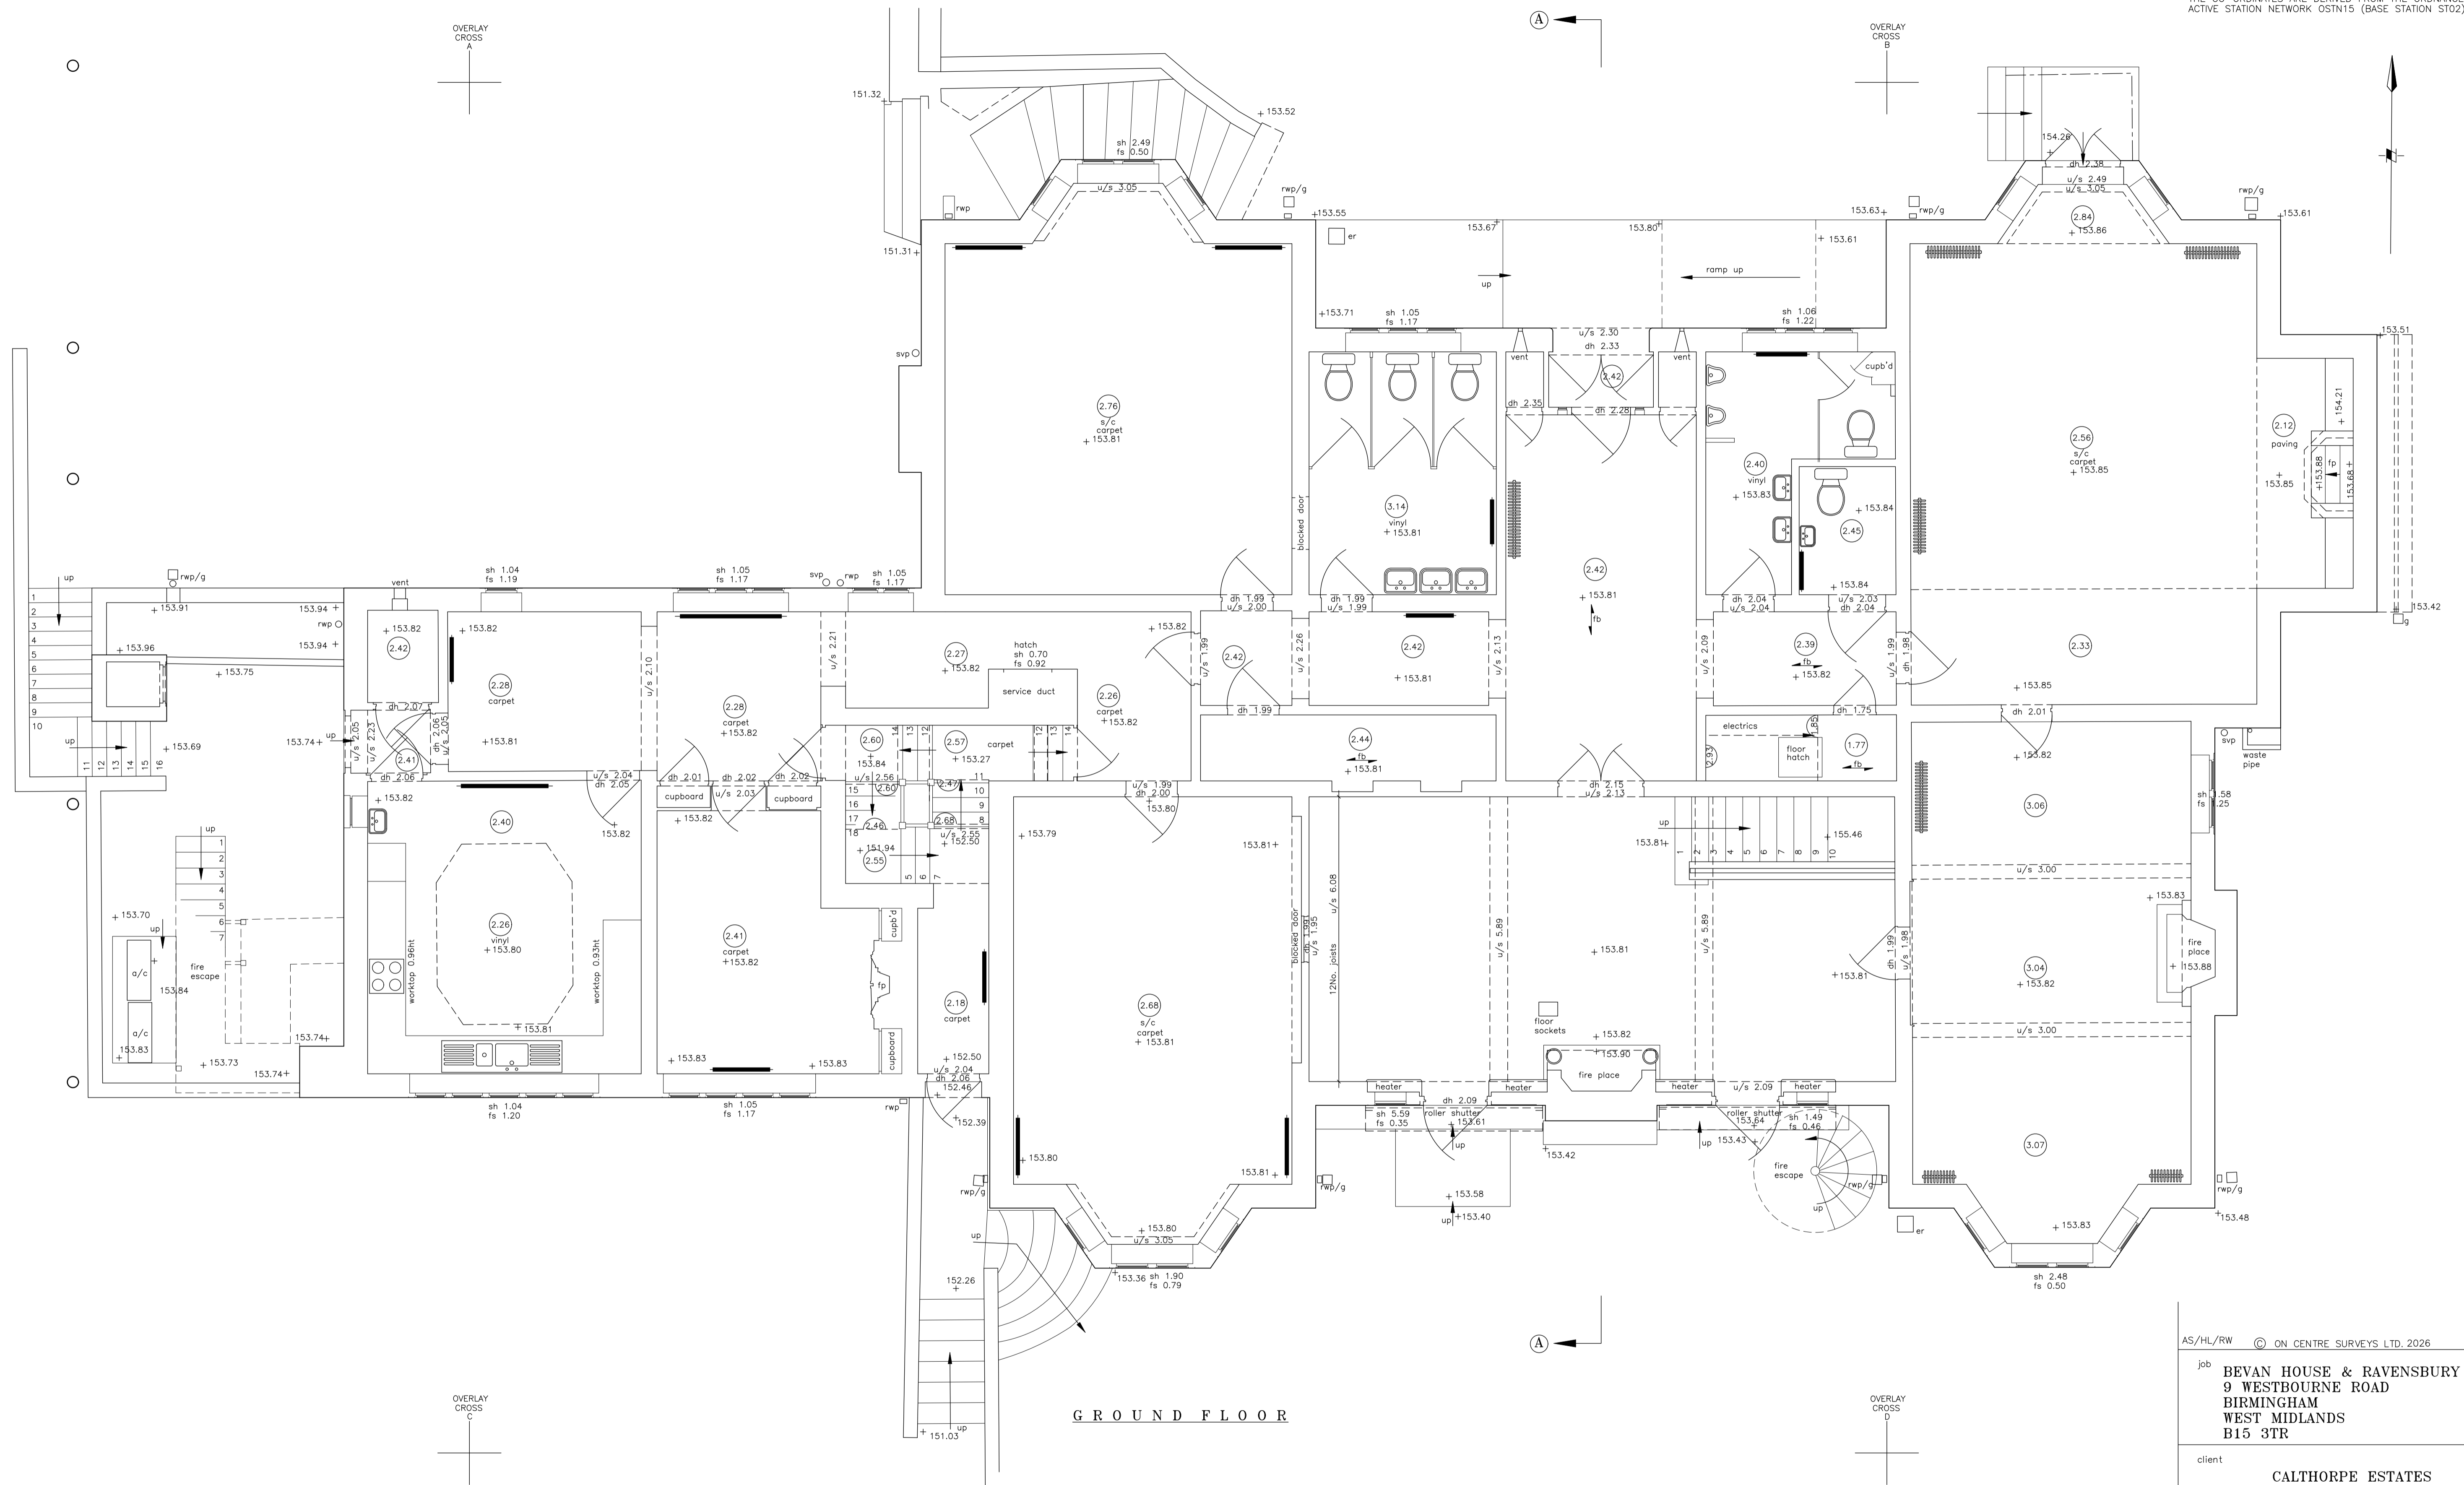

GROUND FLOOR

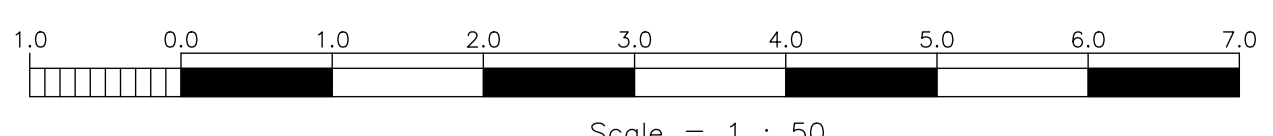

AS/HL/RW © ON CENTRE SURVEYS LTD. 2026	
job BEVAN HOUSE & RAVENSBURY HOUSE 9 WESTBOURNE ROAD BIRMINGHAM WEST MIDLANDS B15 3TR	
client CALTHORPE ESTATES	
title GROUND FLOOR RAVENSBURY HOUSE	dwg no. 29785A/4
scale 1/50	date 9th March 2026
 ON CENTRE SURVEYS LTD. LAND & BUILDING SURVEYORS GEODETIC ENGINEERS 2 CHARLES COURT, BUDBROOKE ROAD, WARWICK CV34 5LZ TEL: 01926 494294 E-MAIL: info@oncentre.co.uk A member of The Survey Association	