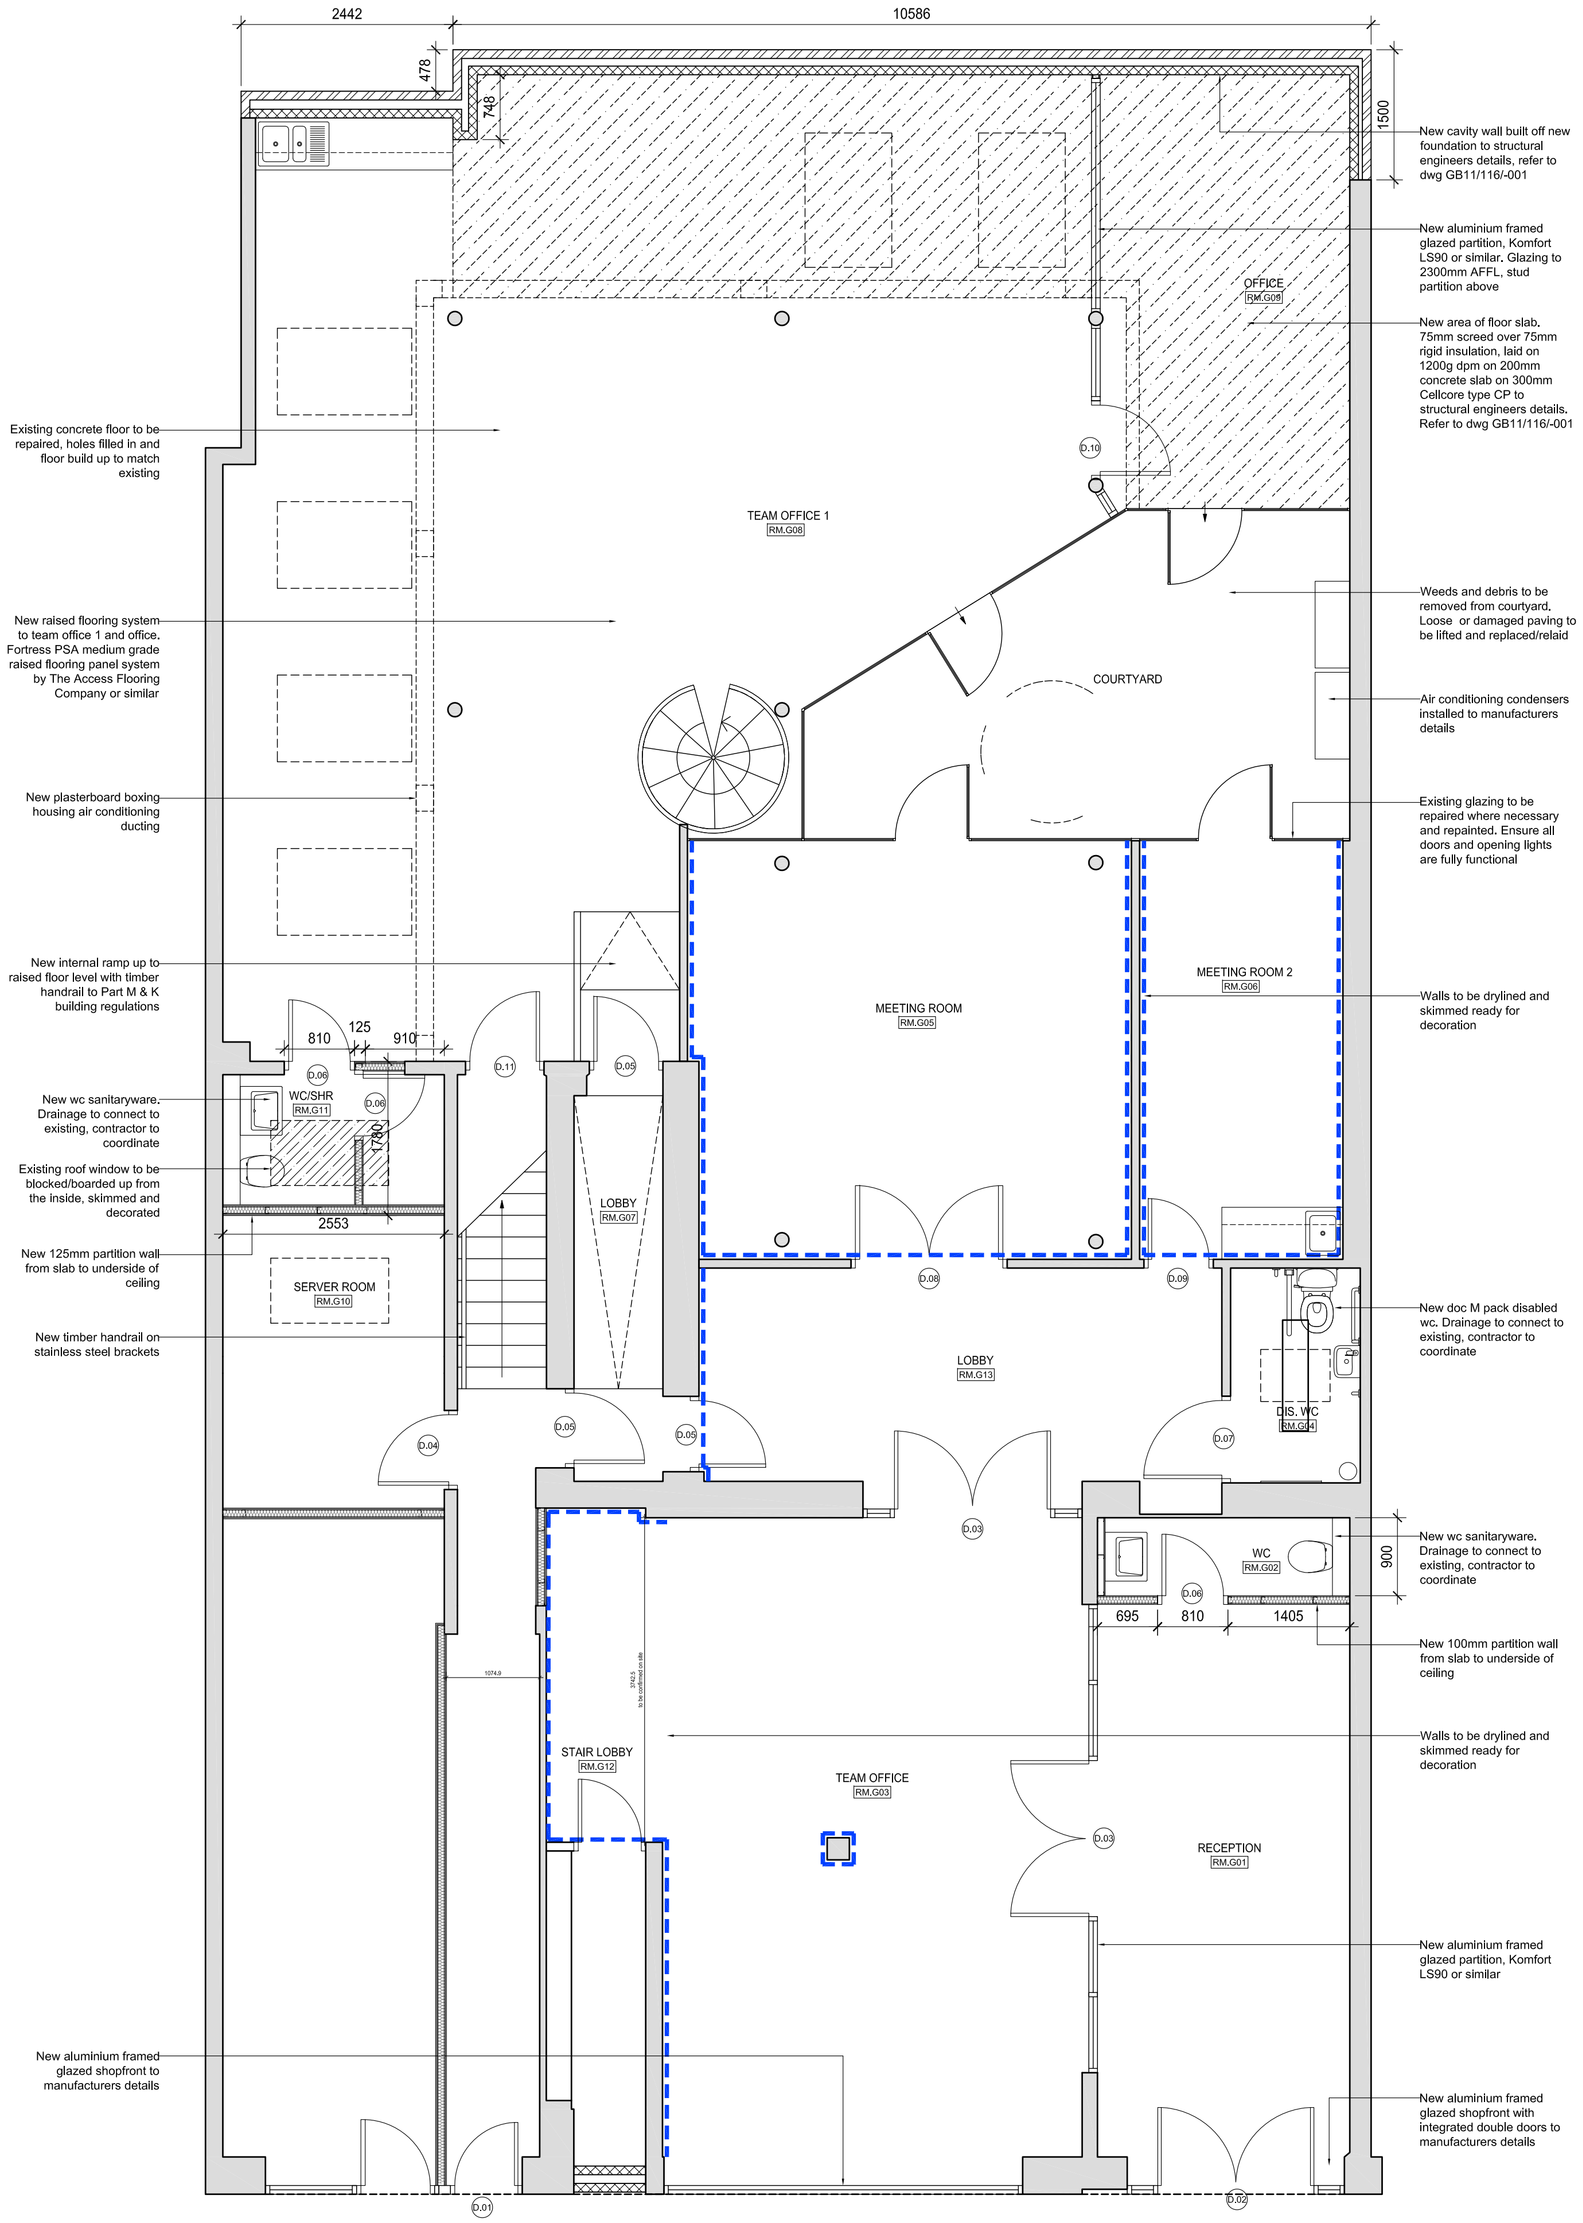

01 GROUND FLOOR PLAN
SCALE 1 : 50 @ A1

GA&A DESIGN

59 Green Leys, Nottingham, NG2 7RX
0115 921 52 52 07788144185
sundeep@gaadesign.co.uk

NOTES

1. All dimensions and levels to be checked on site. Client to be notified of any discrepancies.

2. All structural details to be checked against the structural engineers drawings.

3. This drawing to be read in conjunction with the other relevant project drawings and in addition, with structural, M & E engineers, approved sub-contractors drawings and current instructions.

4. All work to be undertaken with the requirements of the current Building and Water Regulations.

WALL TYPES

- Existing walls
- External wall: 102.5mm facing brickwork, cavity insulated with 50mm rigid insulation, 140mm blockwork inner leaf, 15mm plasterboard
- Internal wall (100mm partition): 15mm plasterboard, 70x34mm metal 'C' studs at 600mm centres filled with Isover High Performance Acoustic Slab, 15mm plasterboard
- Internal wall (130mm partition): 2No. layers 15mm plasterboard, 70x34mm metal 'C' studs at 600mm centres filled with Isover High Performance Acoustic Slab, 2No. layers 15mm plasterboard
- Internal wall: 15mm plasterboard, 100mm blockwork, 15mm plasterboard
- Internal plasterboard lining: Single layer 15mm plasterboard on adhesive dabs

D	Client Amends	04.02.12
	Entrance added, Wall demolished to residential sales office, Spiral Stair added	
C		03.01.12
B	All of rear wall rebuilt	02.11.11
A	Rear wall & slab rebuilt, New doorset	21.10.11

68 Parkway London NW1 7AH

GROUND FLOOR PLAN AS PROPOSED

Drawing number	201
Date	JULY 11
Drawn by	RJS
Checked by	SB
	201-16-001D
Scale	1:50@A1