


- KEY
- FC Floor to Ceiling
 - FFC Floor to False Ceiling
 - F-C Floor to Cill
 - C-H Cill to Head
 - CRO Cill to Crown
 - SPR Cill to Springer
 - USB Underside of Beam
 - RAD Radiator

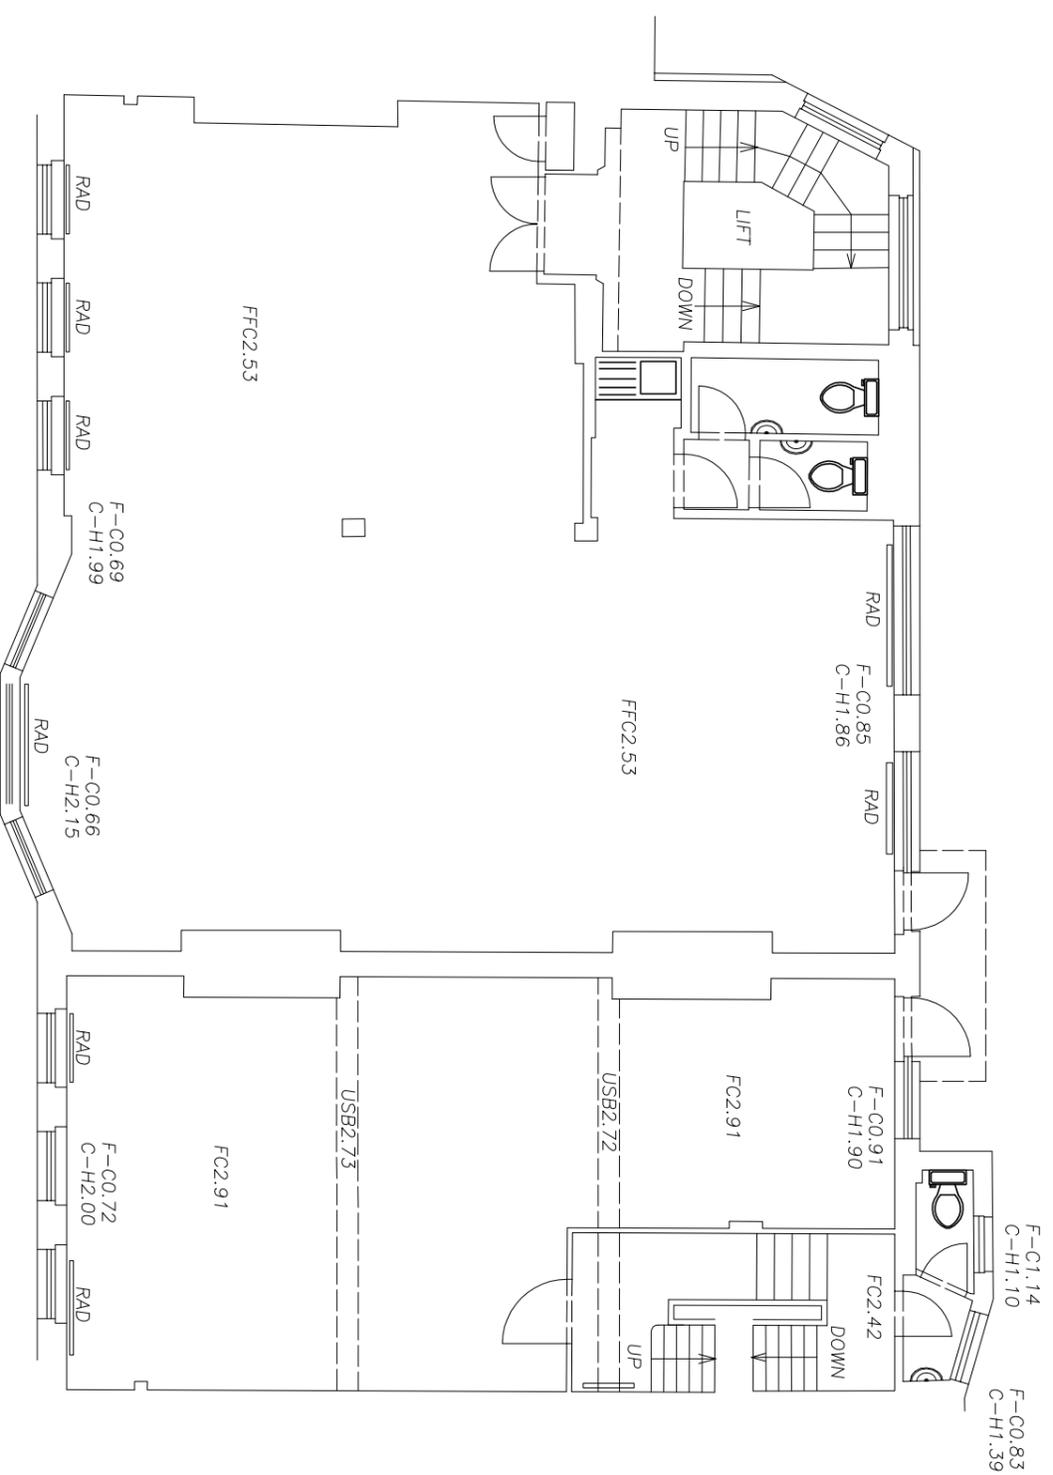

GRYPHON SURVEYS

Hanover House
 78-82 High Street
 Brentwood, Essex CM14 4AP
 Telephone: 01277-212794
 Fax: 01277-214928
 e-mail: gryphon@kelsey-gryphon.co.uk
 www.gryphonsurveys.co.uk

Project: **RADIANT HOUSE**
MORTIMER STREET

Title: **THIRD FLOOR PLAN**

Drawn
L.J.R.

Checked

Scale
1:100@A3

Date
05/07

Ref:

2676-5

D

C

B

A