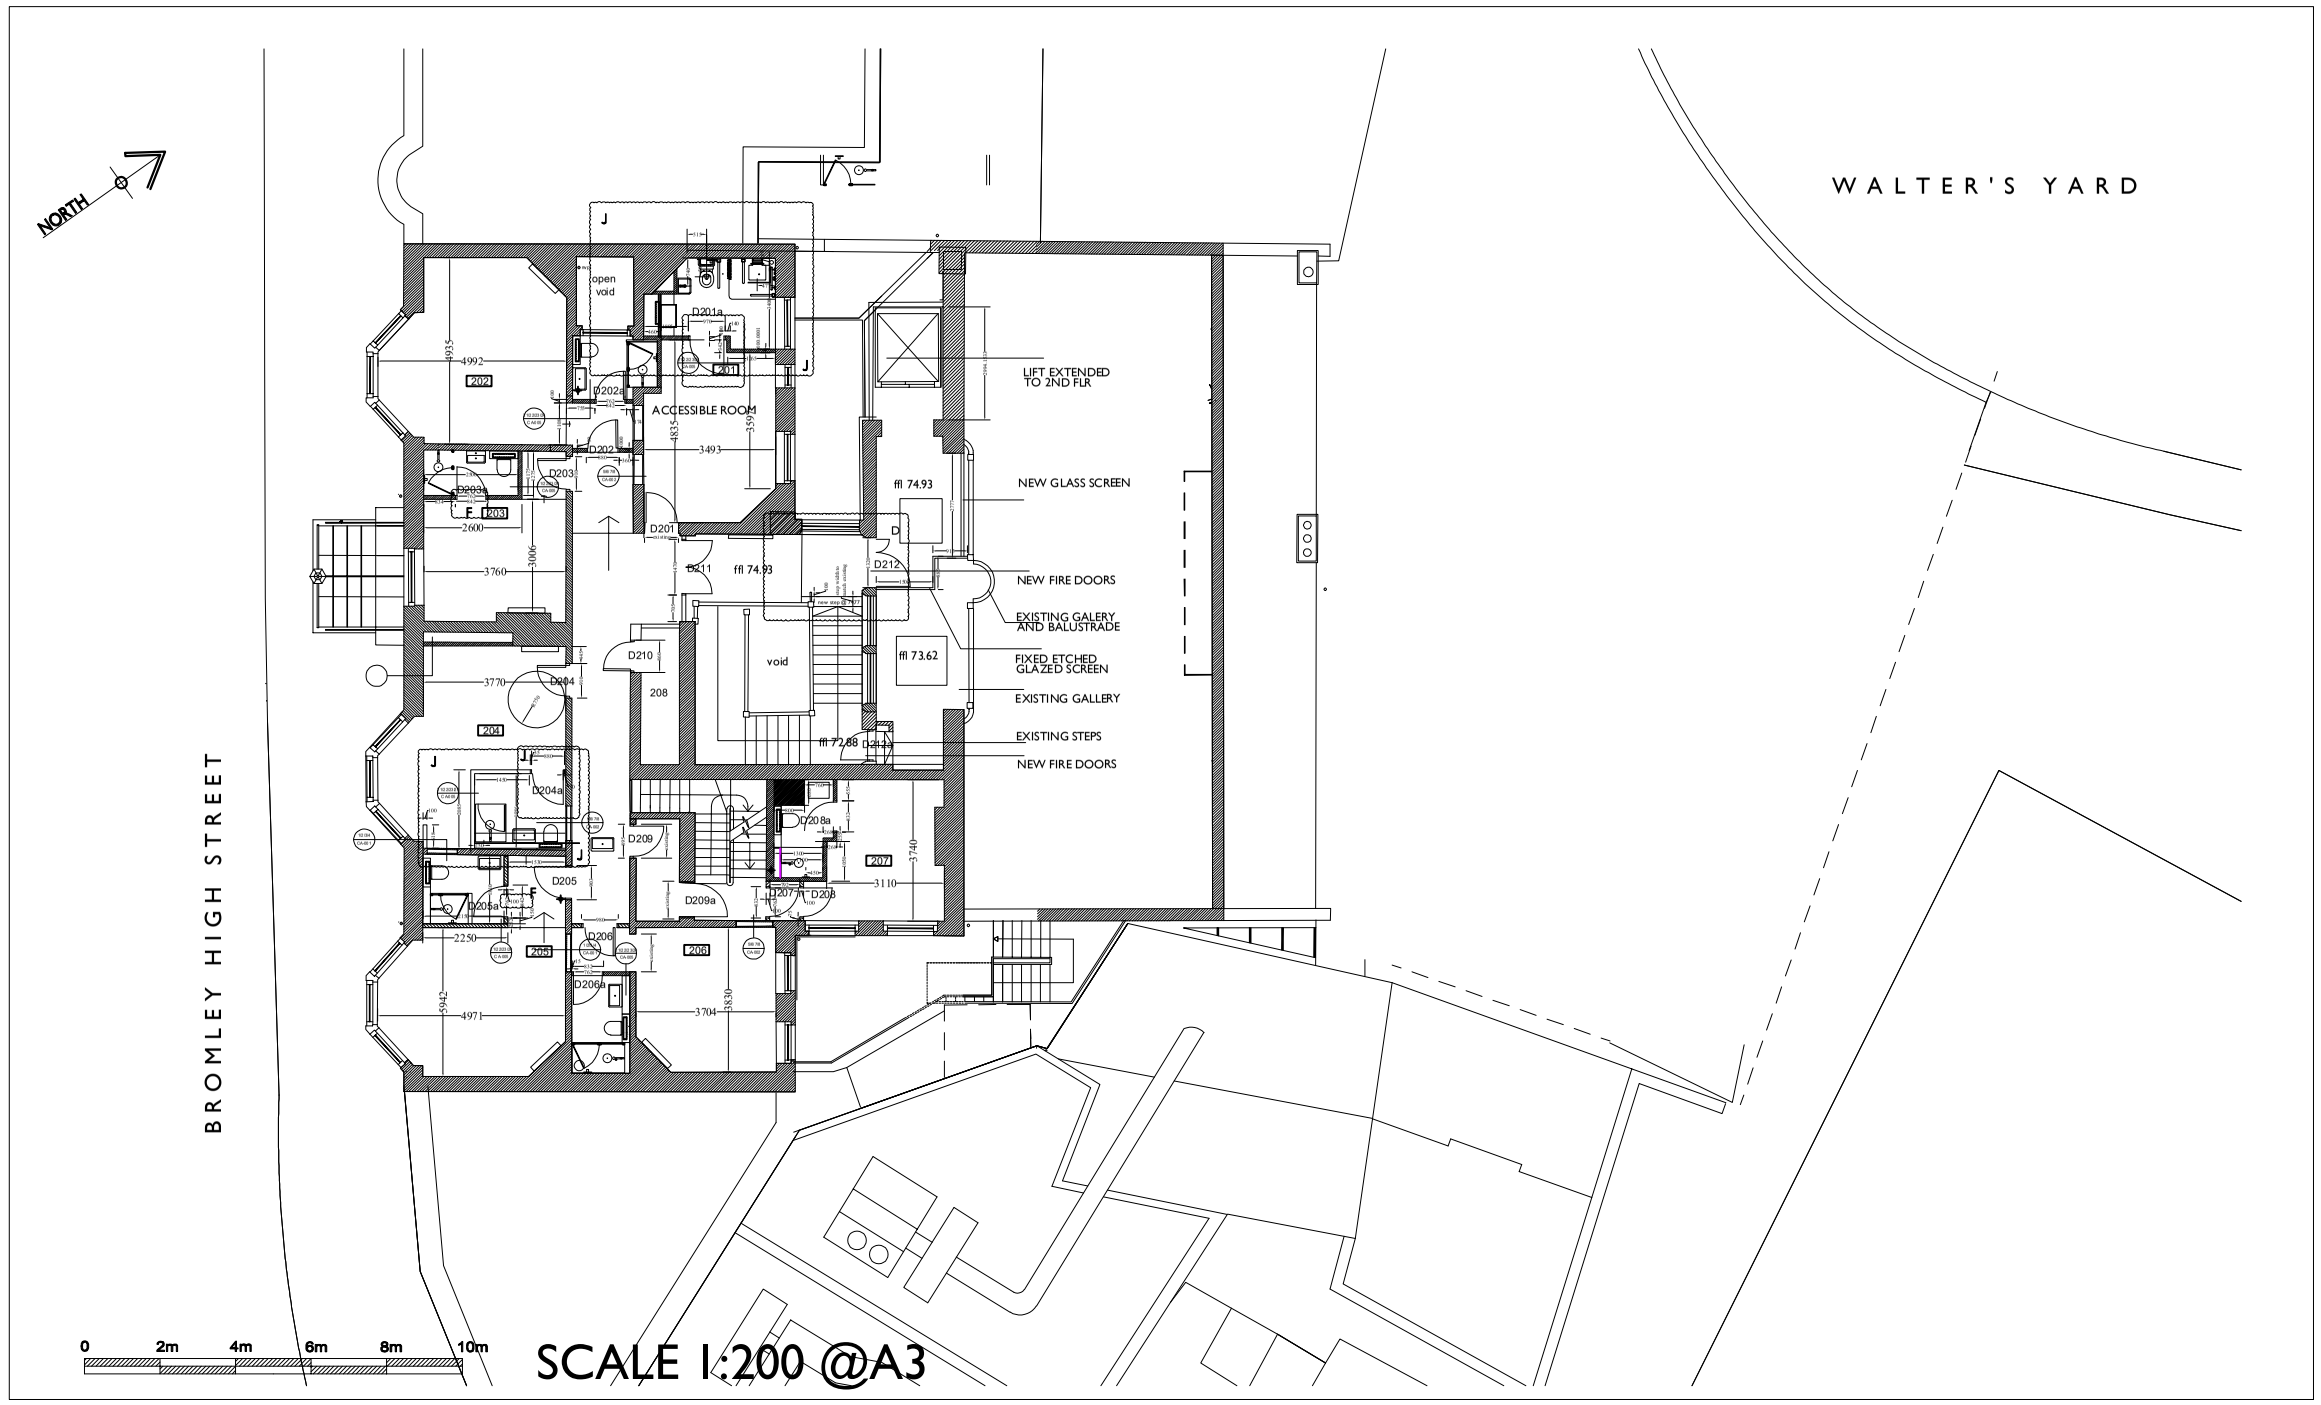

NOTES. —
Do not scale from this drawing.
It is the contractor to take and check all dimensions on site before work commences. Discrepancies to be reported to the architect. Subcontractors to verify all dimensions on site before making shop drawings or commencing manufacture.

CAD File

Rev.	Description	Initial	Date
A	LEVELS ADDED TO GALLERY	MKE	04-11-24
B	DOOR NUMBERS ADDED	MKE	20-11-24
C	PARTITION DETAIL REF.S ADDED	MKE	30-11-24
D	STAIR FLIGHT EXTENDED LIFT LANDING LEVEL REVISED	MKE	11-03-25
E	ADDITIONAL DIMS ADDED	MKE	24-03-25
F	BATHROOM DOOR DIMS REVISED	MKE	27-03-25

Rev.	Description	Initial	Date
G	BATHROOM 201 RELOCATED	MKE	04-04-25
H	BATHROOM 207 REVISED	MKE	10-04-25
J	BEDROOMS 201 /204 SWAPPED	MKE	24-06-25

DENNER ELLIS BODDINGTON
CHARTERED ARCHITECTS

Telephone: 020 7239 4903 Fax: 020 7841 2 7482
E-Mail: architects@denelbod.co.uk

Client
TRB PROPERTY HOLDINGS LTD

ROYAL BELL
HIGH STREET
BROMLEY

Drawn | Checked | Status PLANNING

Title
PROPOSED SECOND FLOOR PLAN

Date | Plot Date XX-11-22

Scale 1:200@A3

Drawing no. 23/463 / GA-003 | Revision J

Anglo-Overseas Consultants Limited. This drawing is copyright.