



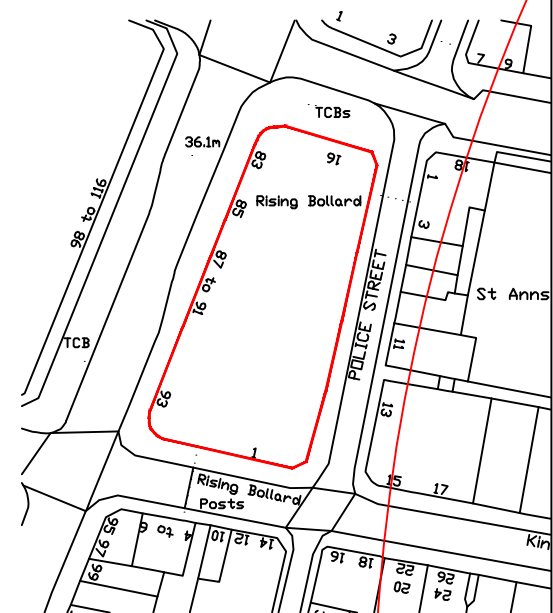

Site Location Plan 1:1250 scale.

GROUND FLOOR - 1 KING STREET, MANCHESTER.

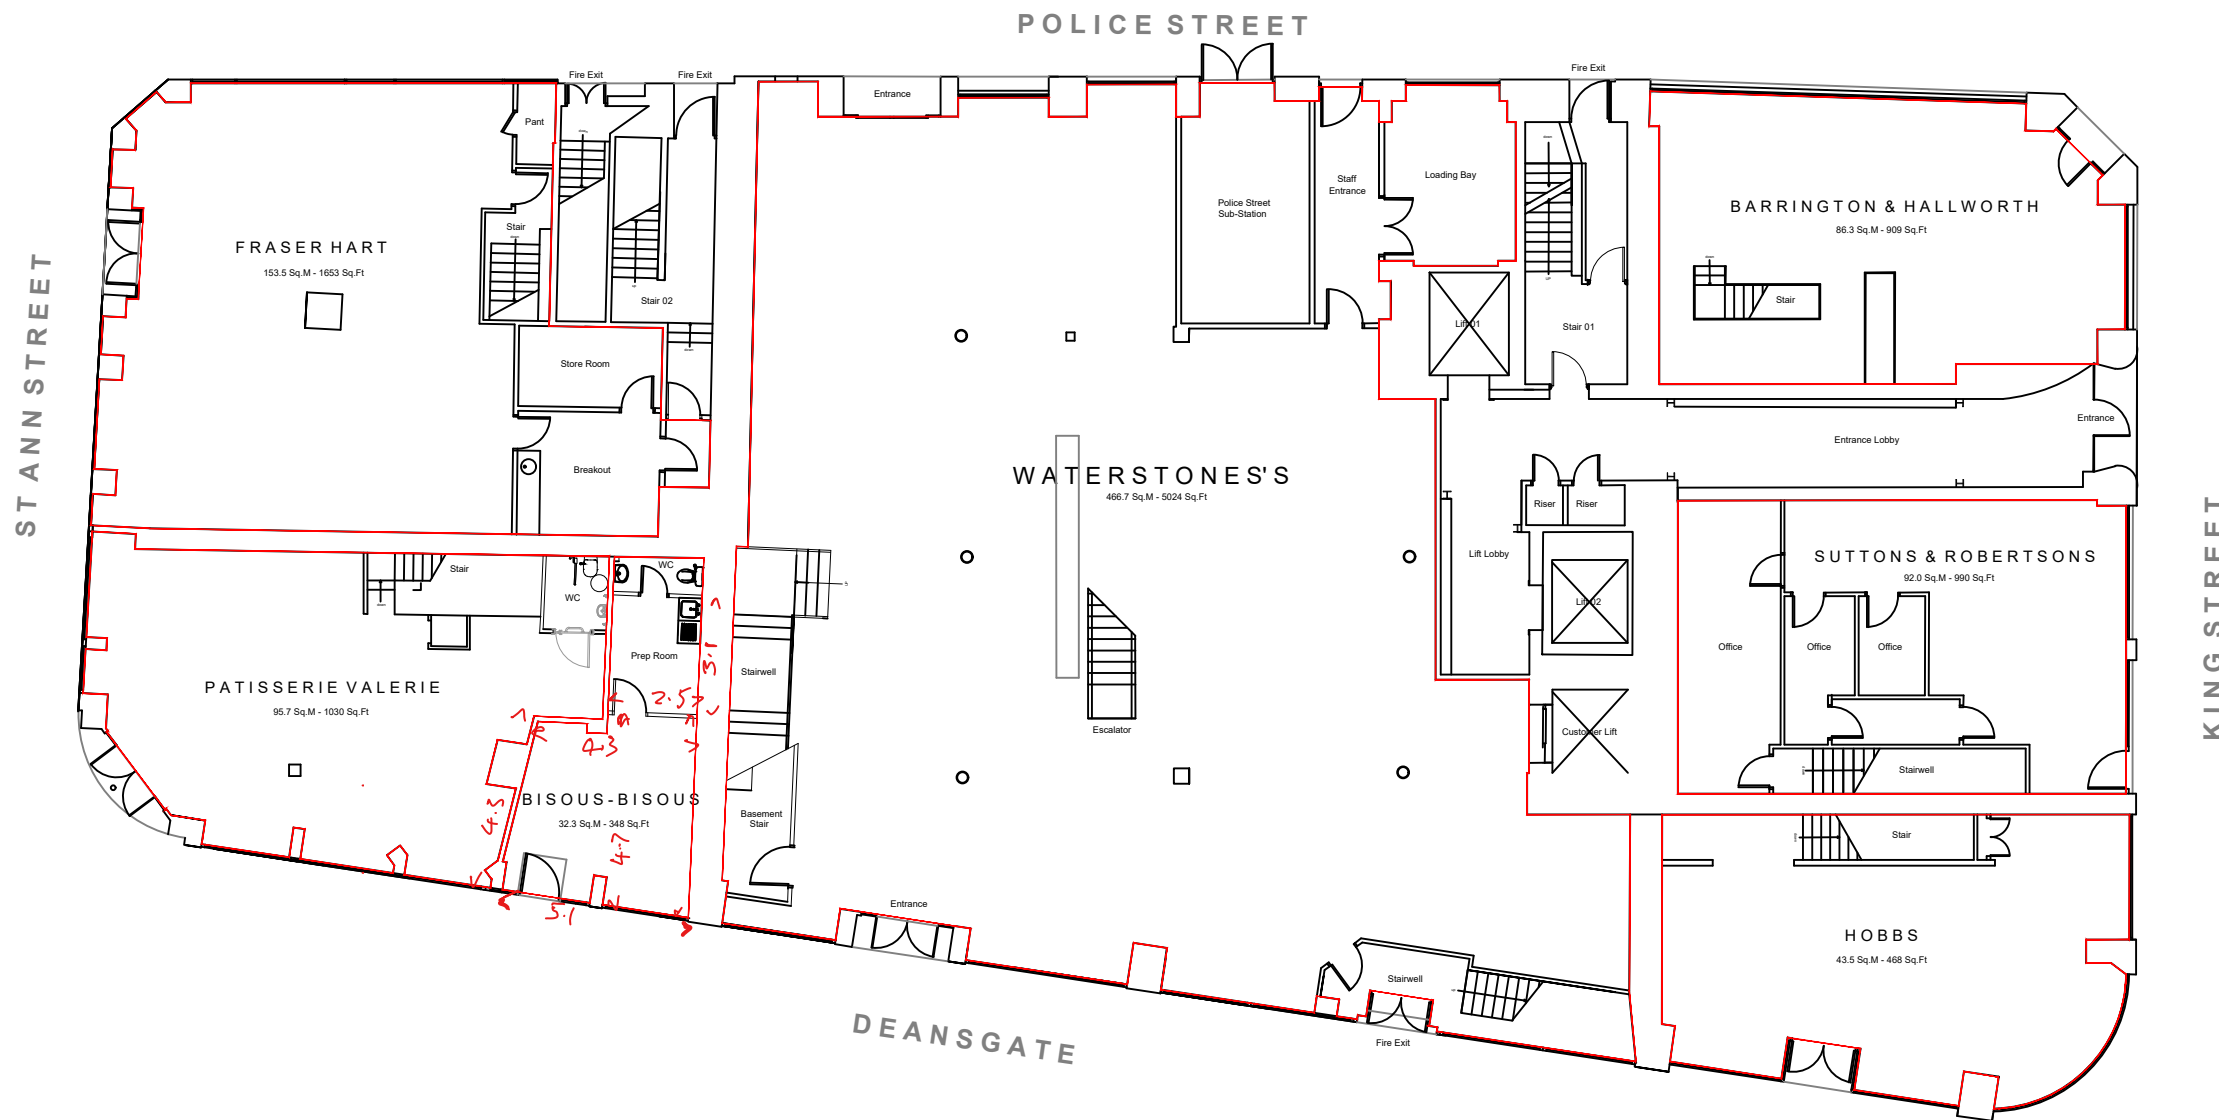

Revisions:	
Project Name:	
1 King Street, Manchester, M2 6AW.	
DWG Name:	
Ground Floor Plan.	
Project Number:	Date:
J.347	06.12.18
DWG No.:	REV:
J.347.02	
Scale:	Checked:
1:200 @ A3	SS.

SIMONSPARROWDESIGN

The Studio, Stocks House Farm,
392 Blackburn Road, Higher Wheelton, PR6 8HS
M 07446 977054
E simon@simonsparrowdesign.com
W simonsparrowdesign.com

This drawing is copyright and should not be reproduced
without written permission. Do not scale off this drawing, site
check all dimensions.