


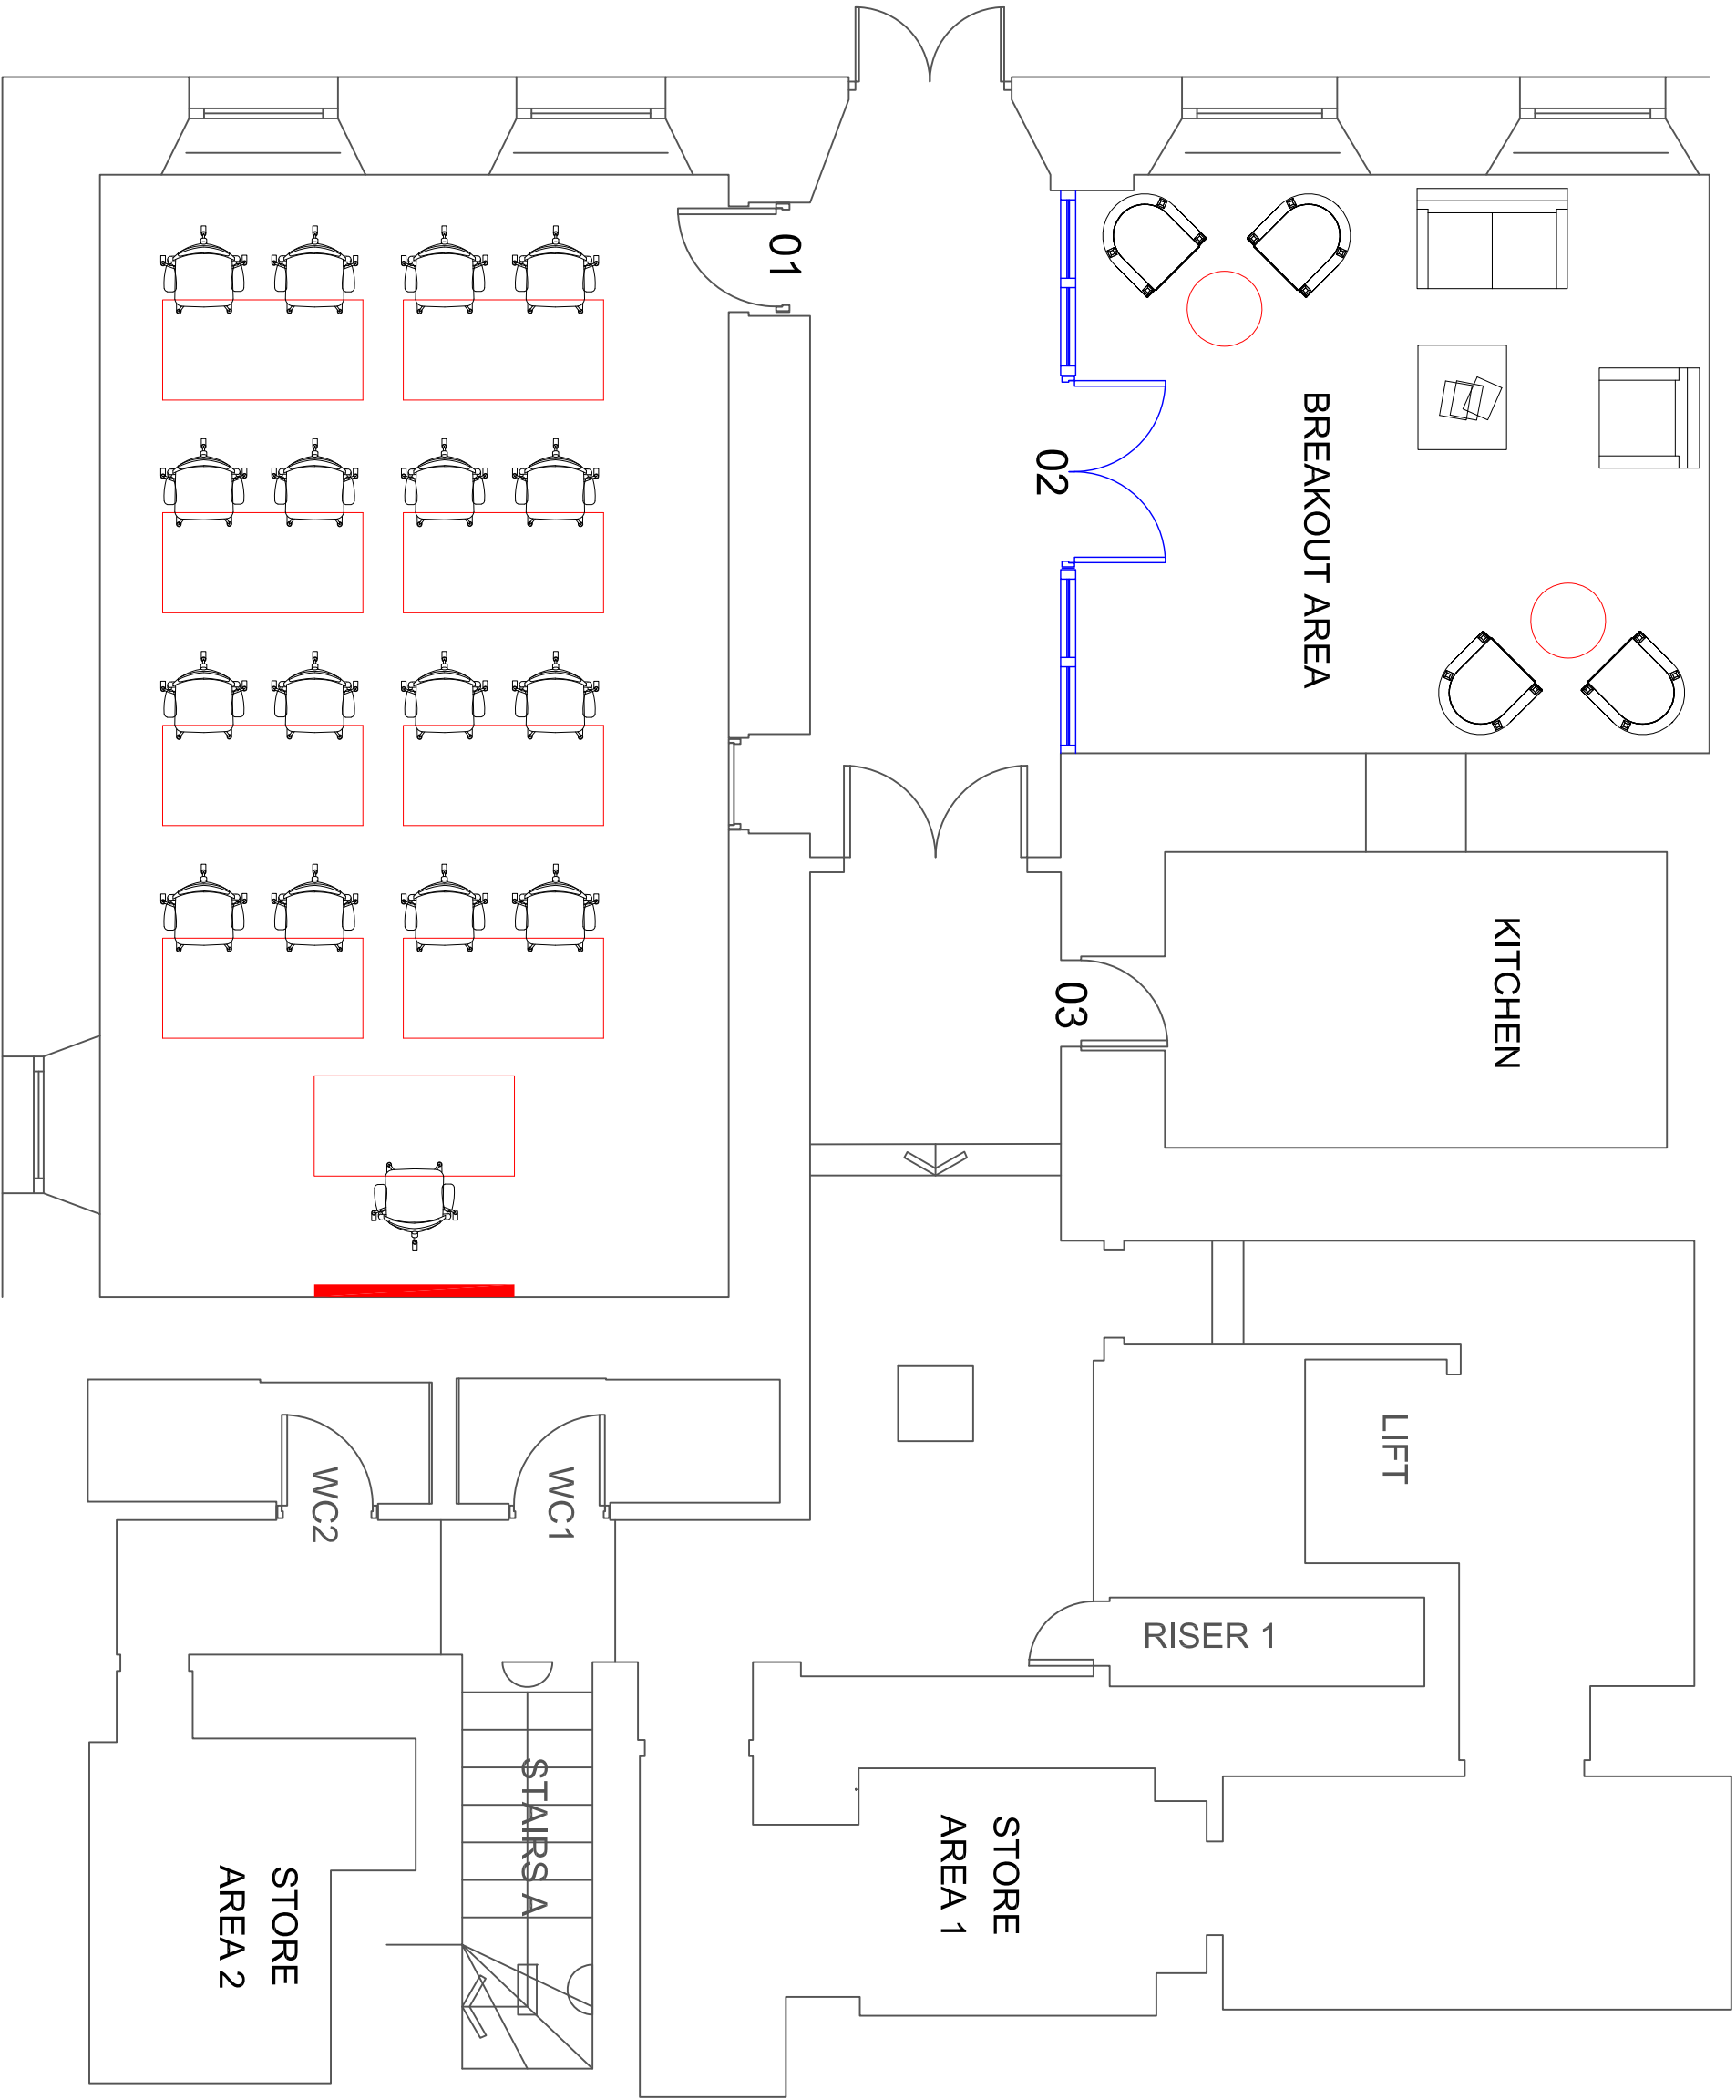

© Copyright


This drawing is the property of Abbey Business Interiors Ltd. Copyright and intellectual property for all information shown is reserved by them and the drawing should not be issued to a third party either wholly, or in part, without the consent in writing of Abbey Business Interiors Ltd.

NOTES:

Contractors must verify all dimensions on site before commencing any work or drawings and any discrepancies are to be reported. Figured dimensions are to be taken in preference to scaled dimensions and the drawing is to be read in conjunction with all relevant architects, consultants, contractors and specialist drawings. IF IN DOUBT ASK.

REVISION NOTES

DATE B'

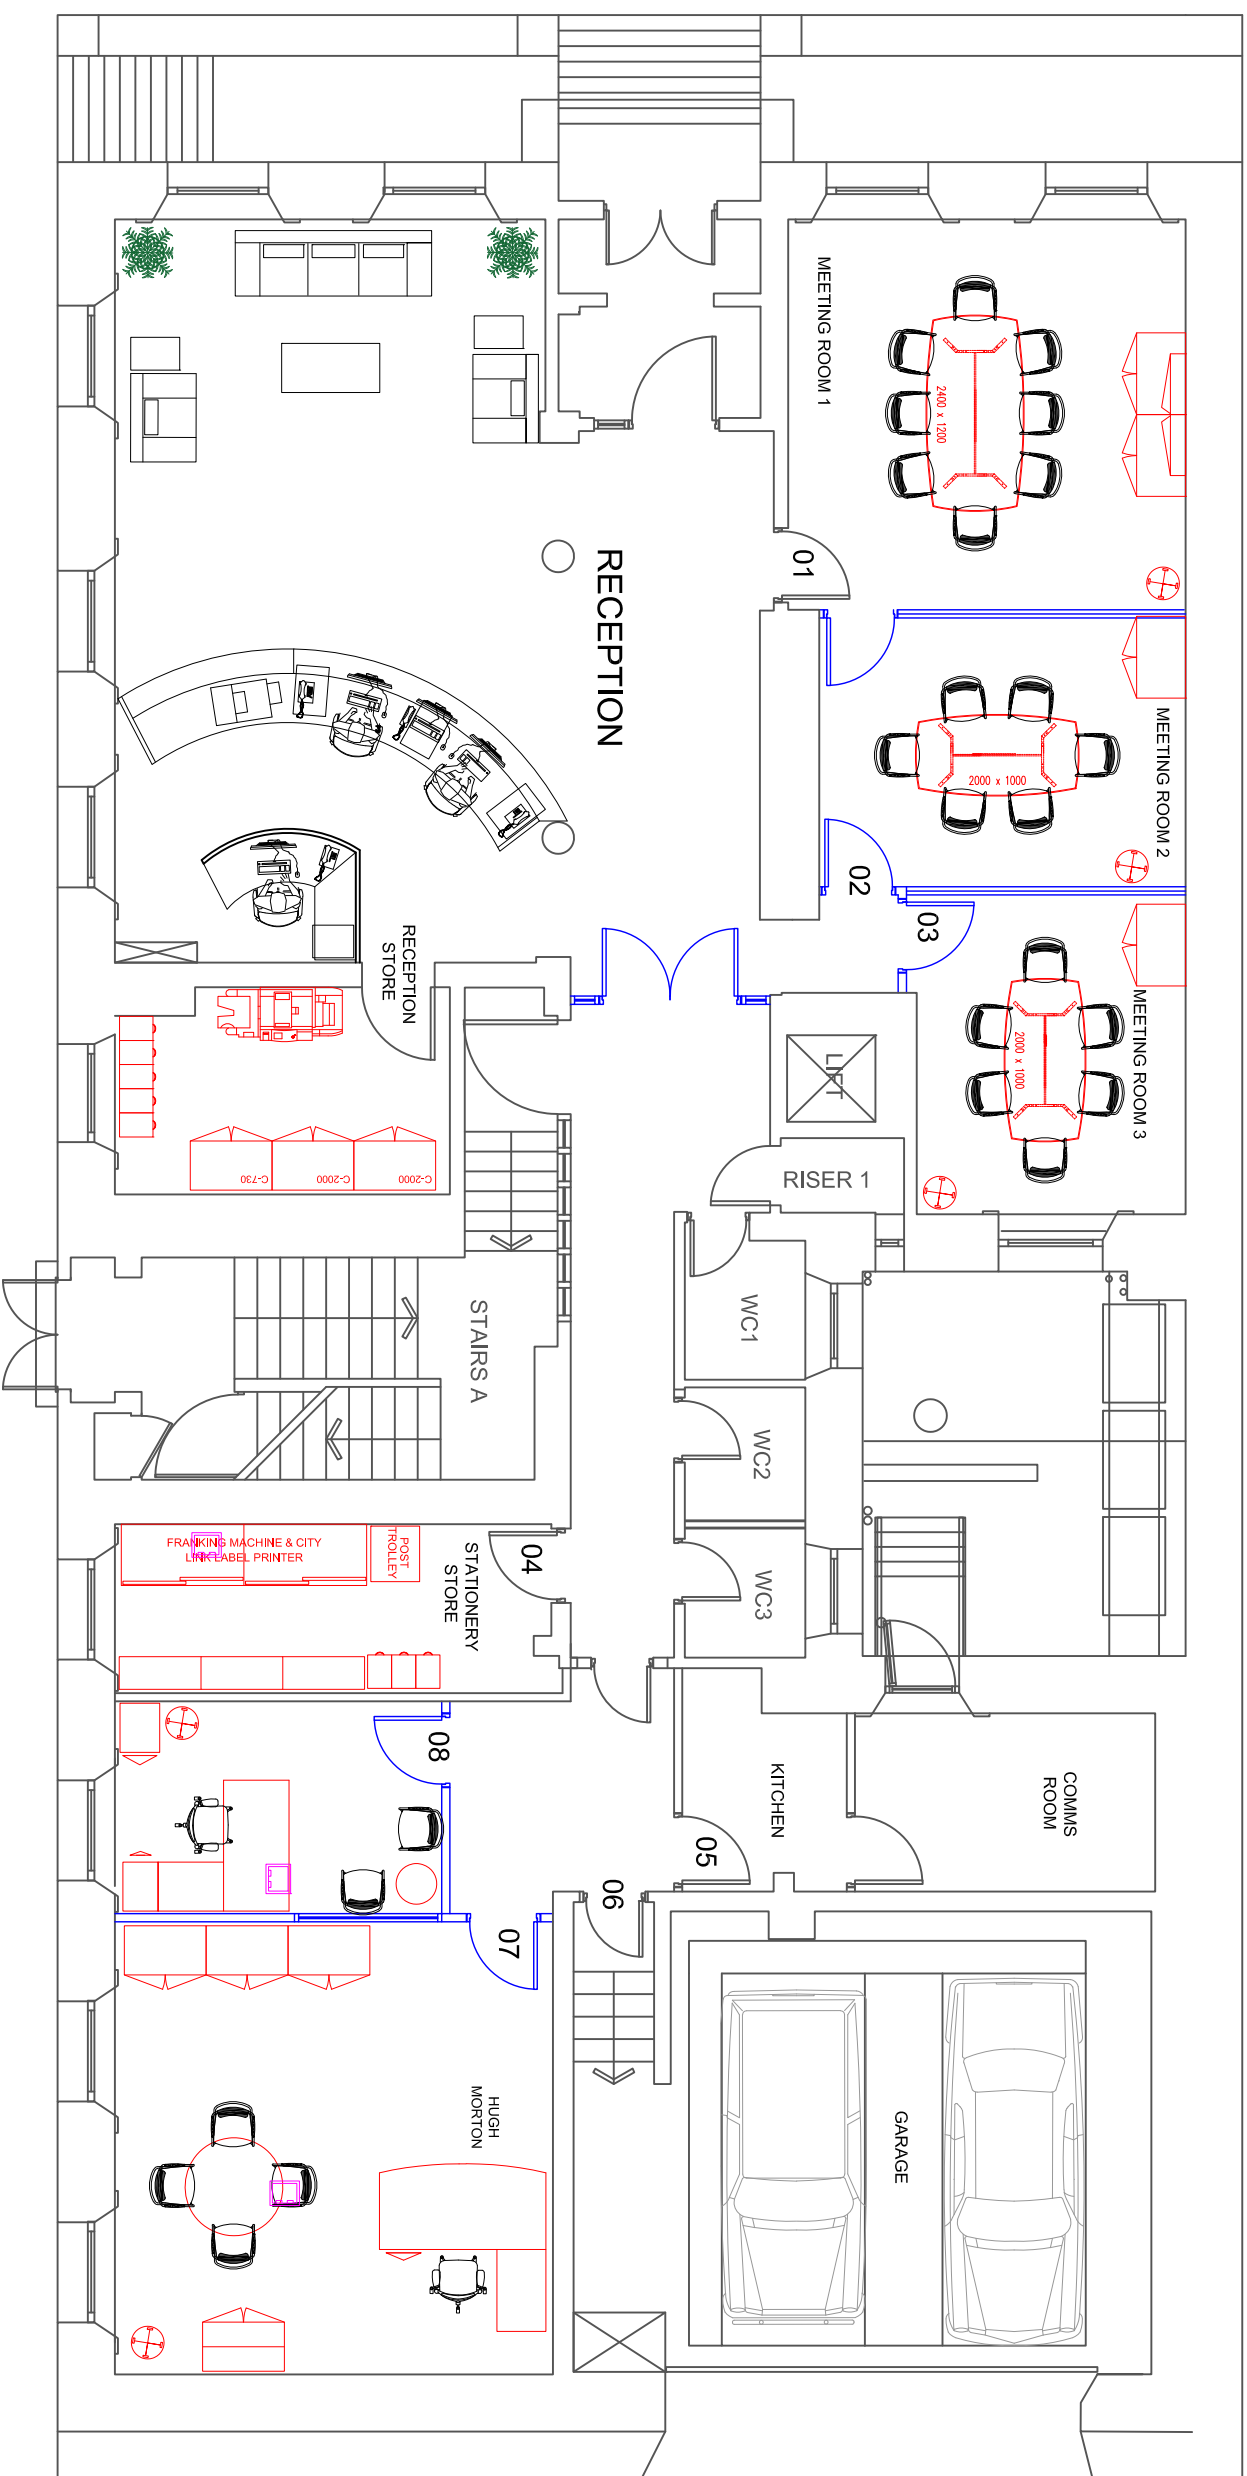

ABBEY
BUSINESS
INTERIORS

Abbey Business Interiors
23 Neptune Business Centre
Tewkesbury Road
Cheltenham
Gloucestershire
GL51 9FB
T: 01242 263 444
W: www.abbeybusinessinteriors.co.uk

T: 01242 263 444
W: www.abbeybusinessinteriors.co.uk

CLIENT

St James's Place Wealth Management

LOCATION

Glasgow

DRAWING TITLE	SCALE	DRAWN/
Ground - existing		RG
DRAWING NUMBER	REVISION	DATE

**GLASGOW
GROUND
DATED 3 MAY 2017**

© Copyright
This drawing is the property of Abbey Business Interiors Ltd. Copyright and intellectual property for all information shown is reserved by them and the drawing should not be issued to a third party either wholly, or in part, without the consent in writing of Abbey Business Interiors Ltd.

NOTES:
Contractor must verify all dimensions on site before commencing any work or drawings and any discrepancies are to be reported. Figured dimensions are to be taken in preference to scaled dimensions and the drawing is to be read in conjunction with all relevant architects, consultants, contractors and specialist drawings, if in doubt ASK.

REVISION NOTES DATE BY


ABBEY BUSINESS INTERIORS

Abbey Business Interiors
23 Neptune Business Centre
Tewkesbury Road
Cheltenham
Gloucestershire
GL51 9FB
T. 01242 763 444
W. www.abbeybusinessinteriors.co.uk

CLIENT
St James's Place Wealth Management
LOCATION
Glasgow

DRAWING TITLE	SCALE	DRAWN
First - existing		RG
DRAWING NUMBER	REVISION	DATE
	-	3.5.17


GLASGOW
FIRST
DATED 3 MAY 2017

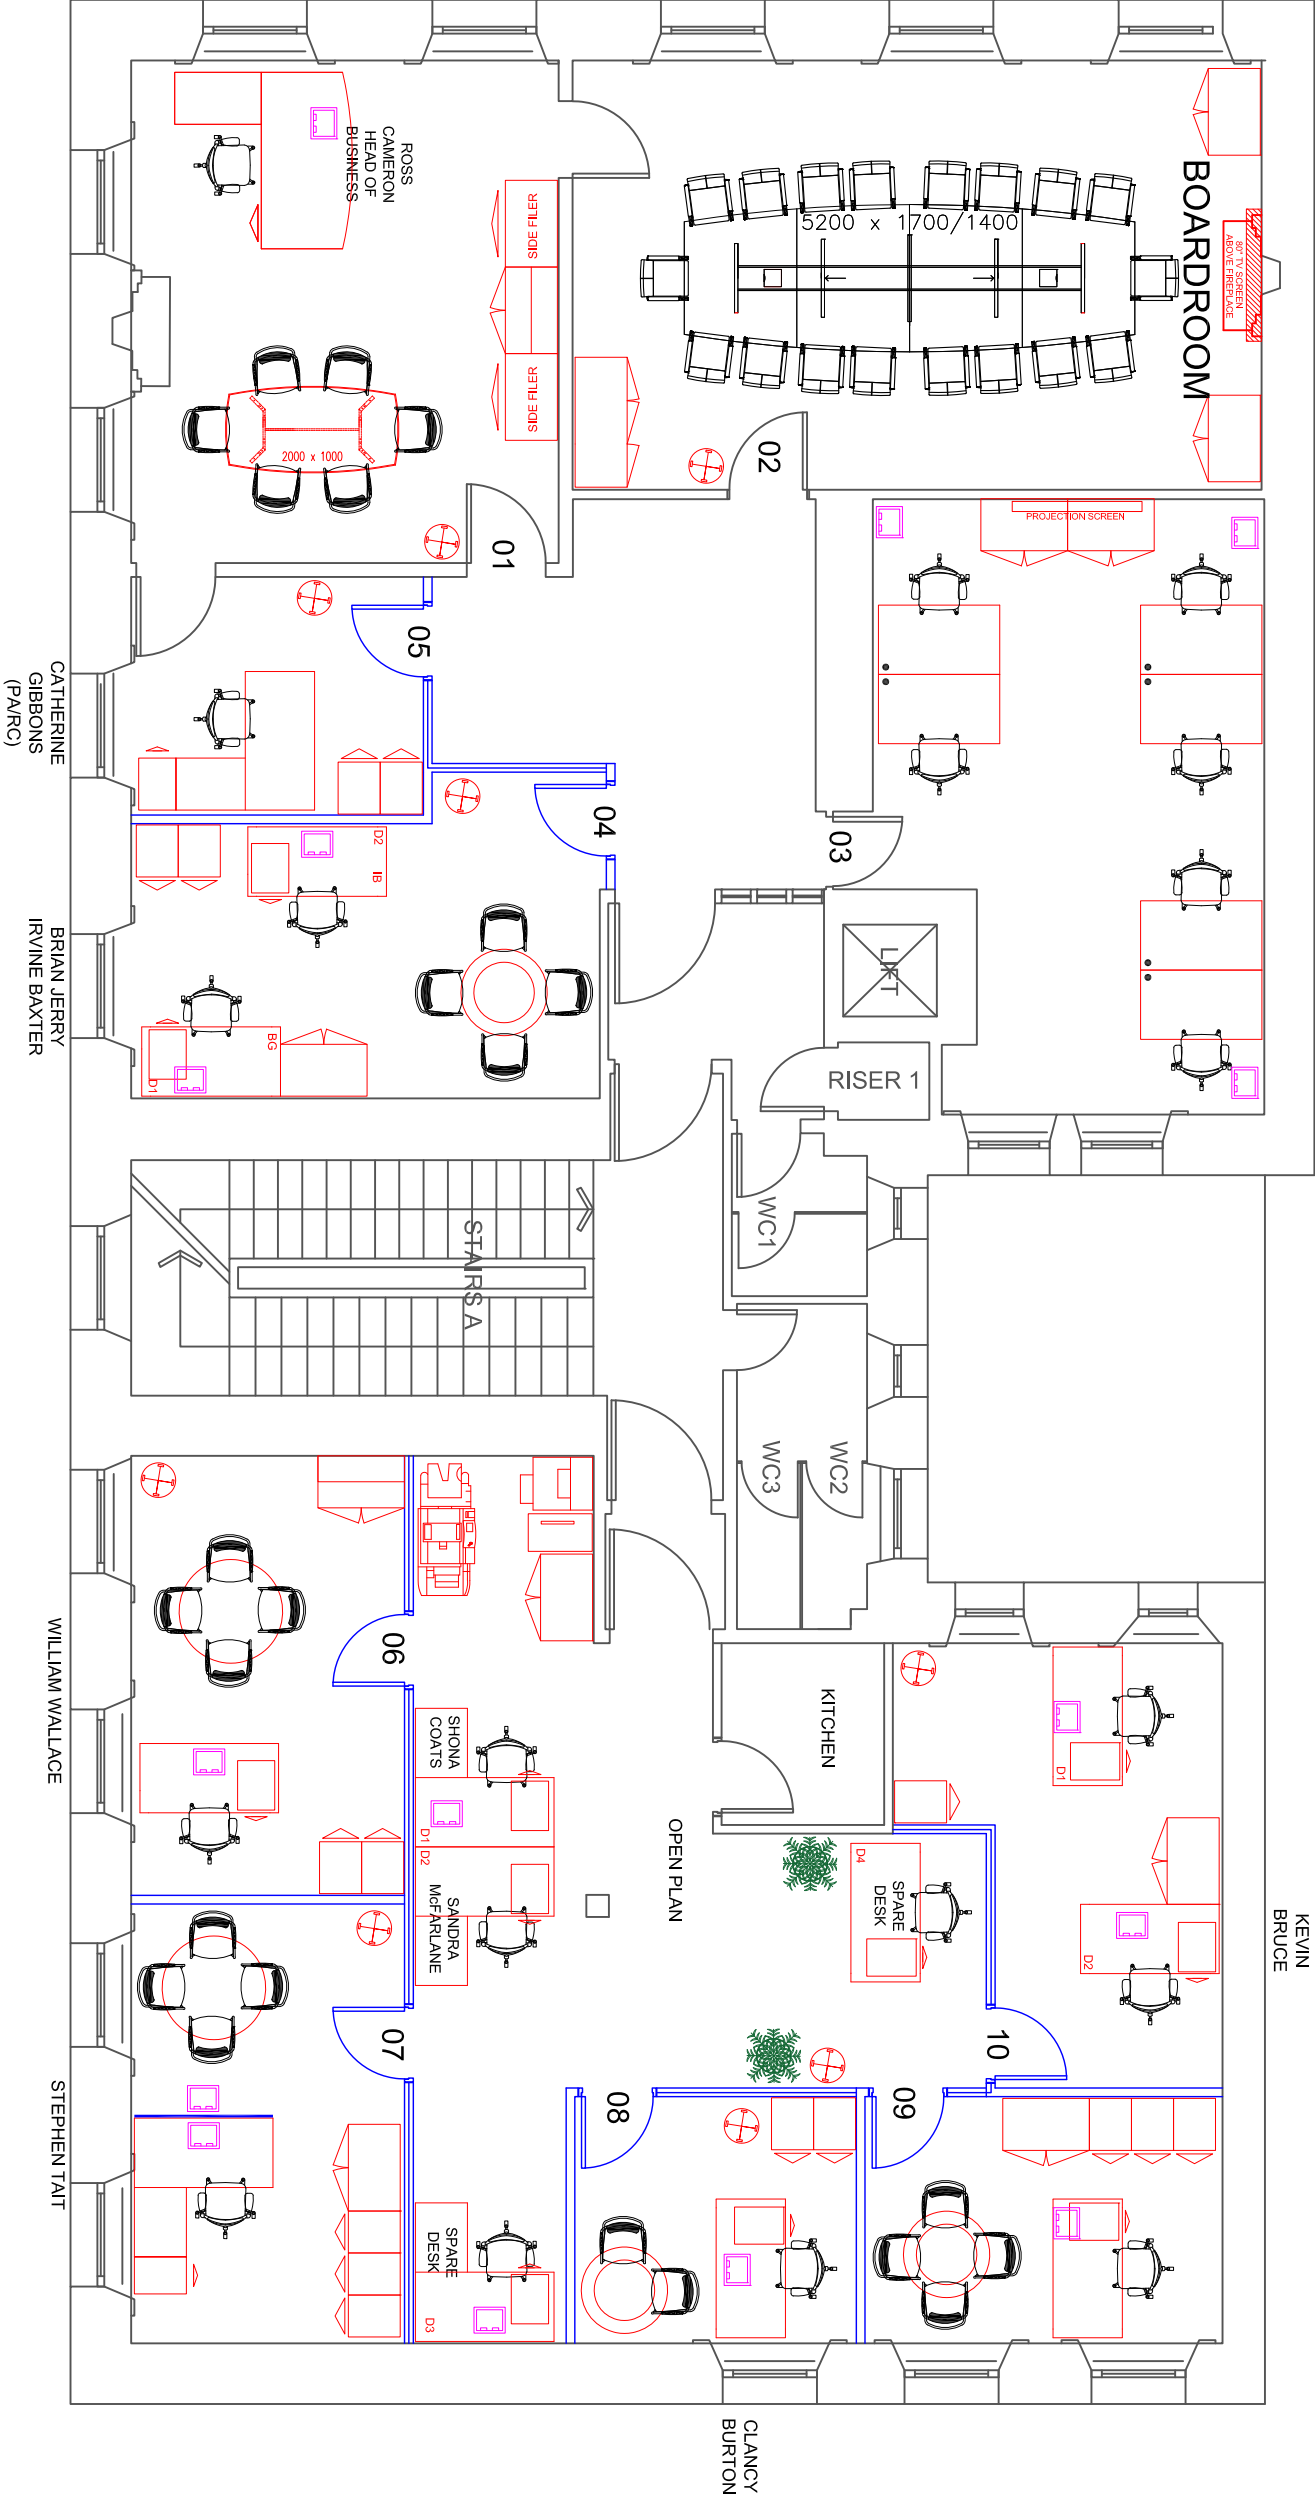

© Copyright
This drawing is the property of Abbey Business Interiors Ltd. Copyright and intellectual property for all information shown is reserved by them and the drawing should not be issued to a third party either wholly, or in part, without the consent in writing of Abbey Business Interiors Ltd.

NOTES:
Contractor must verify all dimensions on site before commencing any work or drawings and any discrepancies are to be reported. Figured dimensions are to be taken in preference to scaled dimensions and the drawing is to be read in conjunction with all relevant architects, consultants, contractors and specialist drawings, if in doubt ASK.

REVISION	NOTES	DATE	BY
-	-	-	-

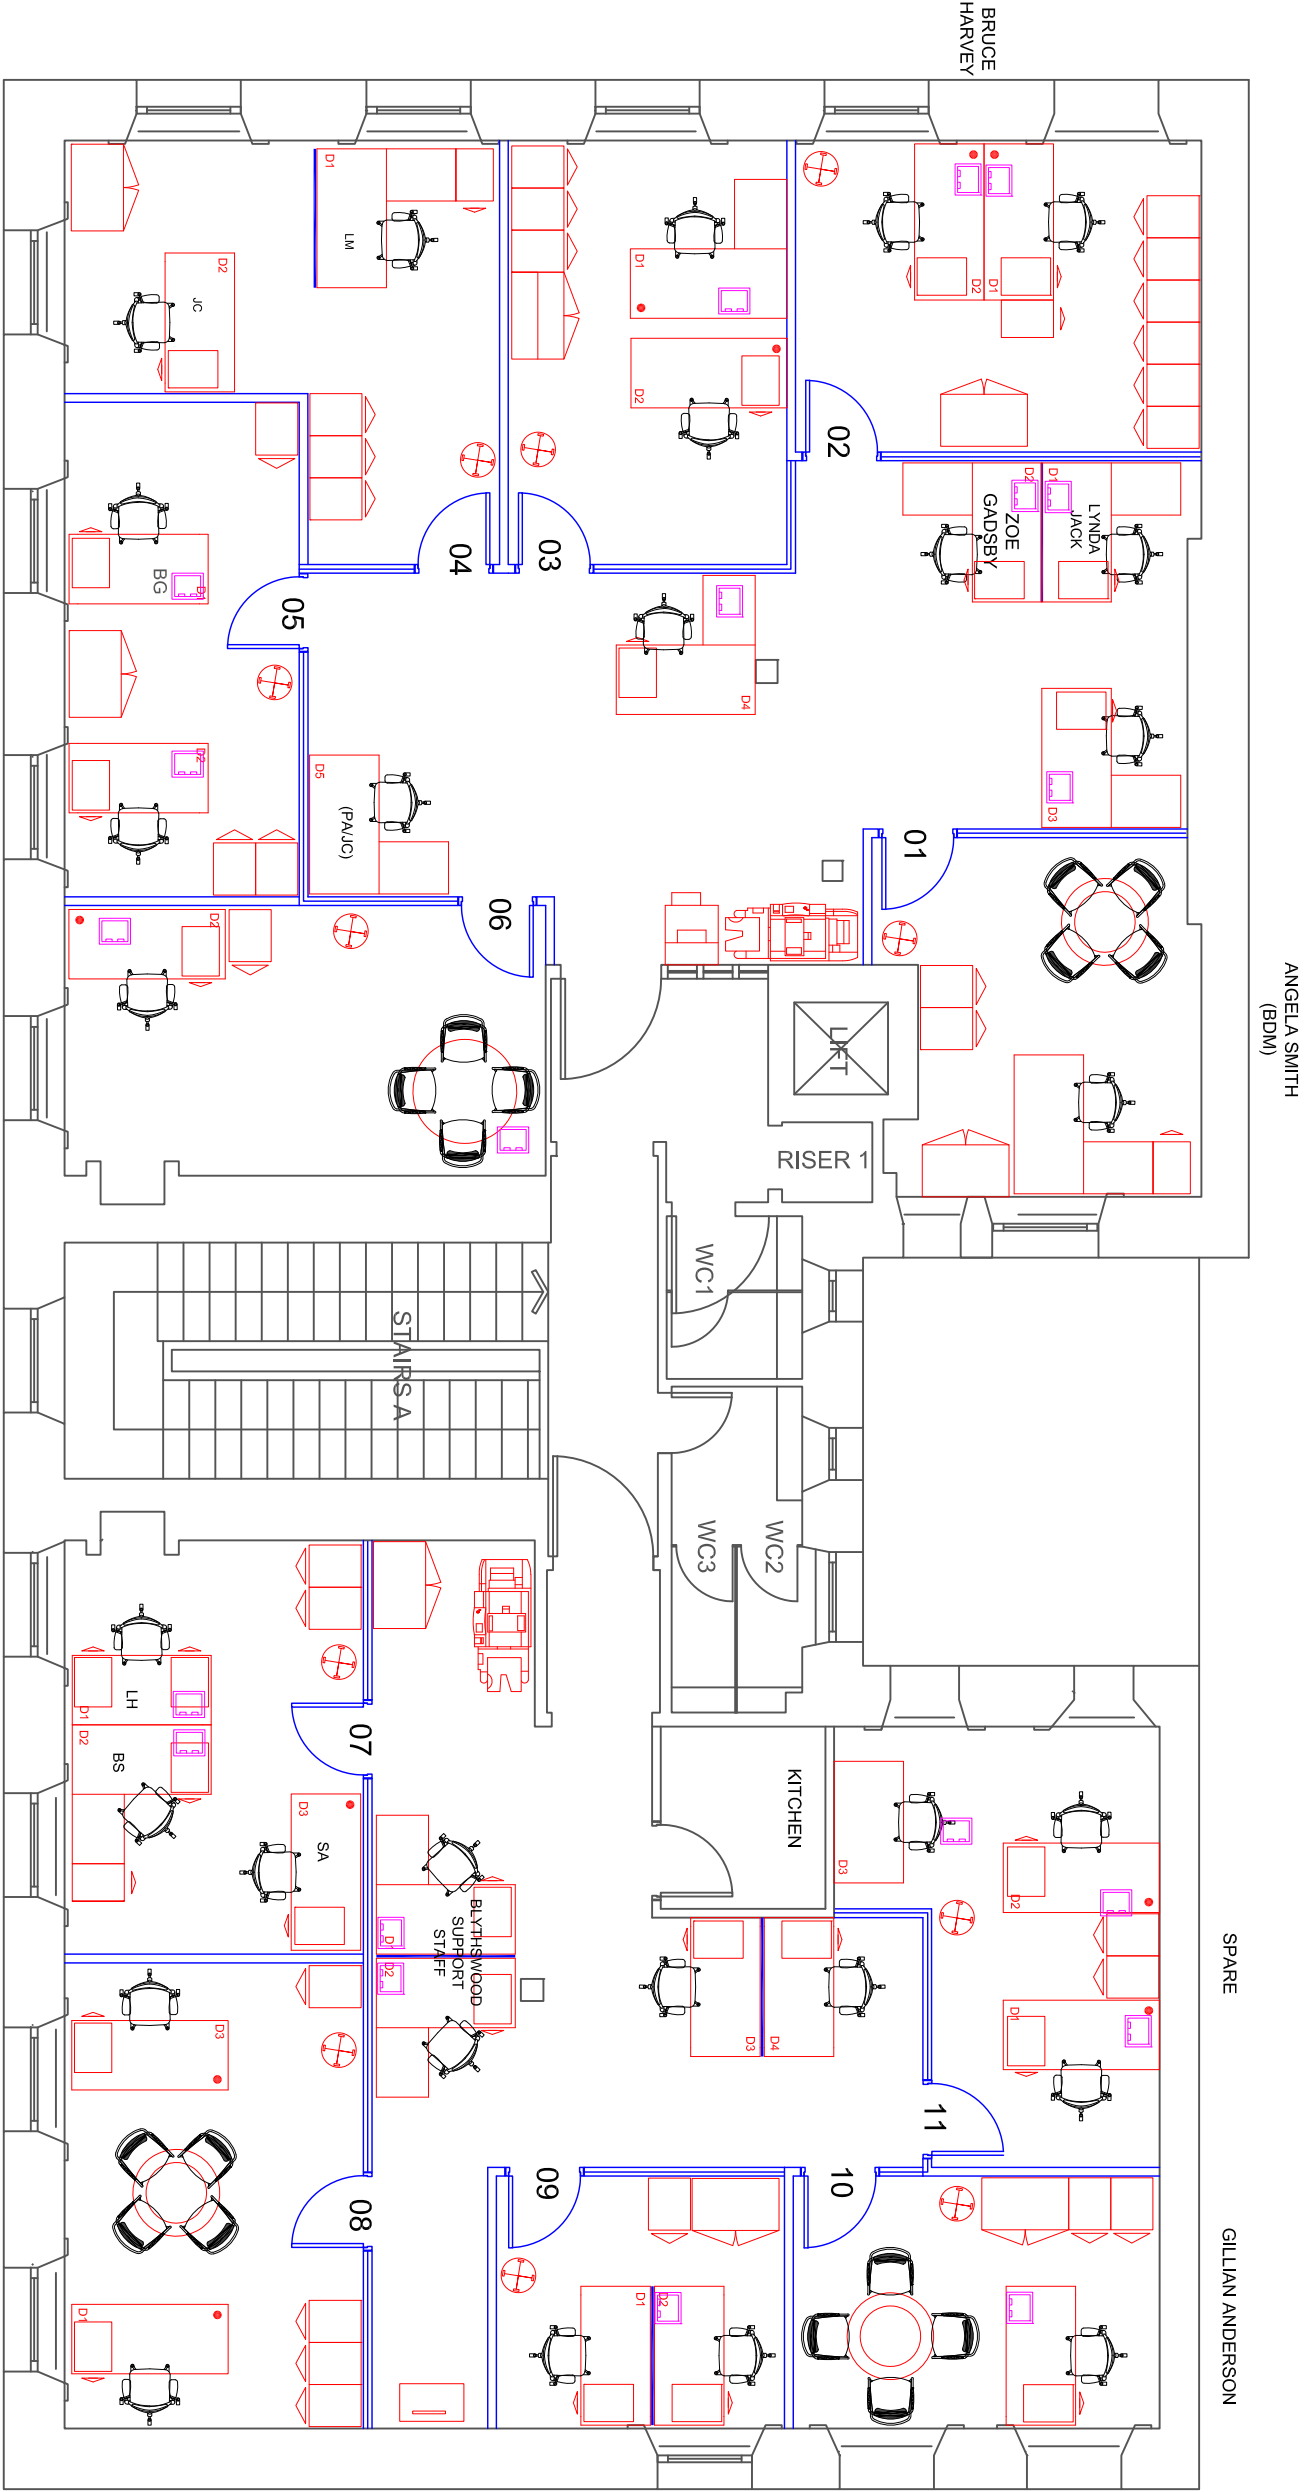

ABBEY BUSINESS INTERIORS

Abbey Business Interiors
23 Neptune Business Centre
Tewkesbury Road
Cheltenham
Gloucestershire
GL51 9FB
T: 01242 763 444
W: www.abbeybusinessinteriors.co.uk

CLIENT
St James's Place Wealth Management
LOCATION
Glasgow

DRAWING TITLE	SCALE	DRAWN
Second - existing	RG	
DRAWING NUMBER	REVISION	DATE
-	-	3.5.17

GLASGOW
SECOND
DATED 3 MAY 2017