



NOTES:
 Copyright Chetwoods (London) Limited. No implied licence exists.
 Contractors must verify all dimensions on site before commencing any work or shop drawings. This drawing is not to be scaled. Use figured dimensions only.
 Subject to statutory approvals and survey.
 Building areas are liable to adjustment over the course of the design process due to the ongoing construction detailing developments.
 Please note the information contained within this drawing is solely for the benefit of the employer and should not be relied upon by third parties.
 The CDM hazard management procedures for the Chetwoods aspects of the design of this project are to be found on the "Chetwoods - Hazard Analysis and Design Risk Assessment" and/or drawings. The full project design team's comprehensive set of hazard management procedures are available from the Principle Designer appointed for the project.

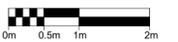

Note:
 Ordnance Survey (c) Crown Copyright 2021
 All rights reserved
 Licence Number 100022432

Structural Opening Heights:
 - Doors: 2100mm

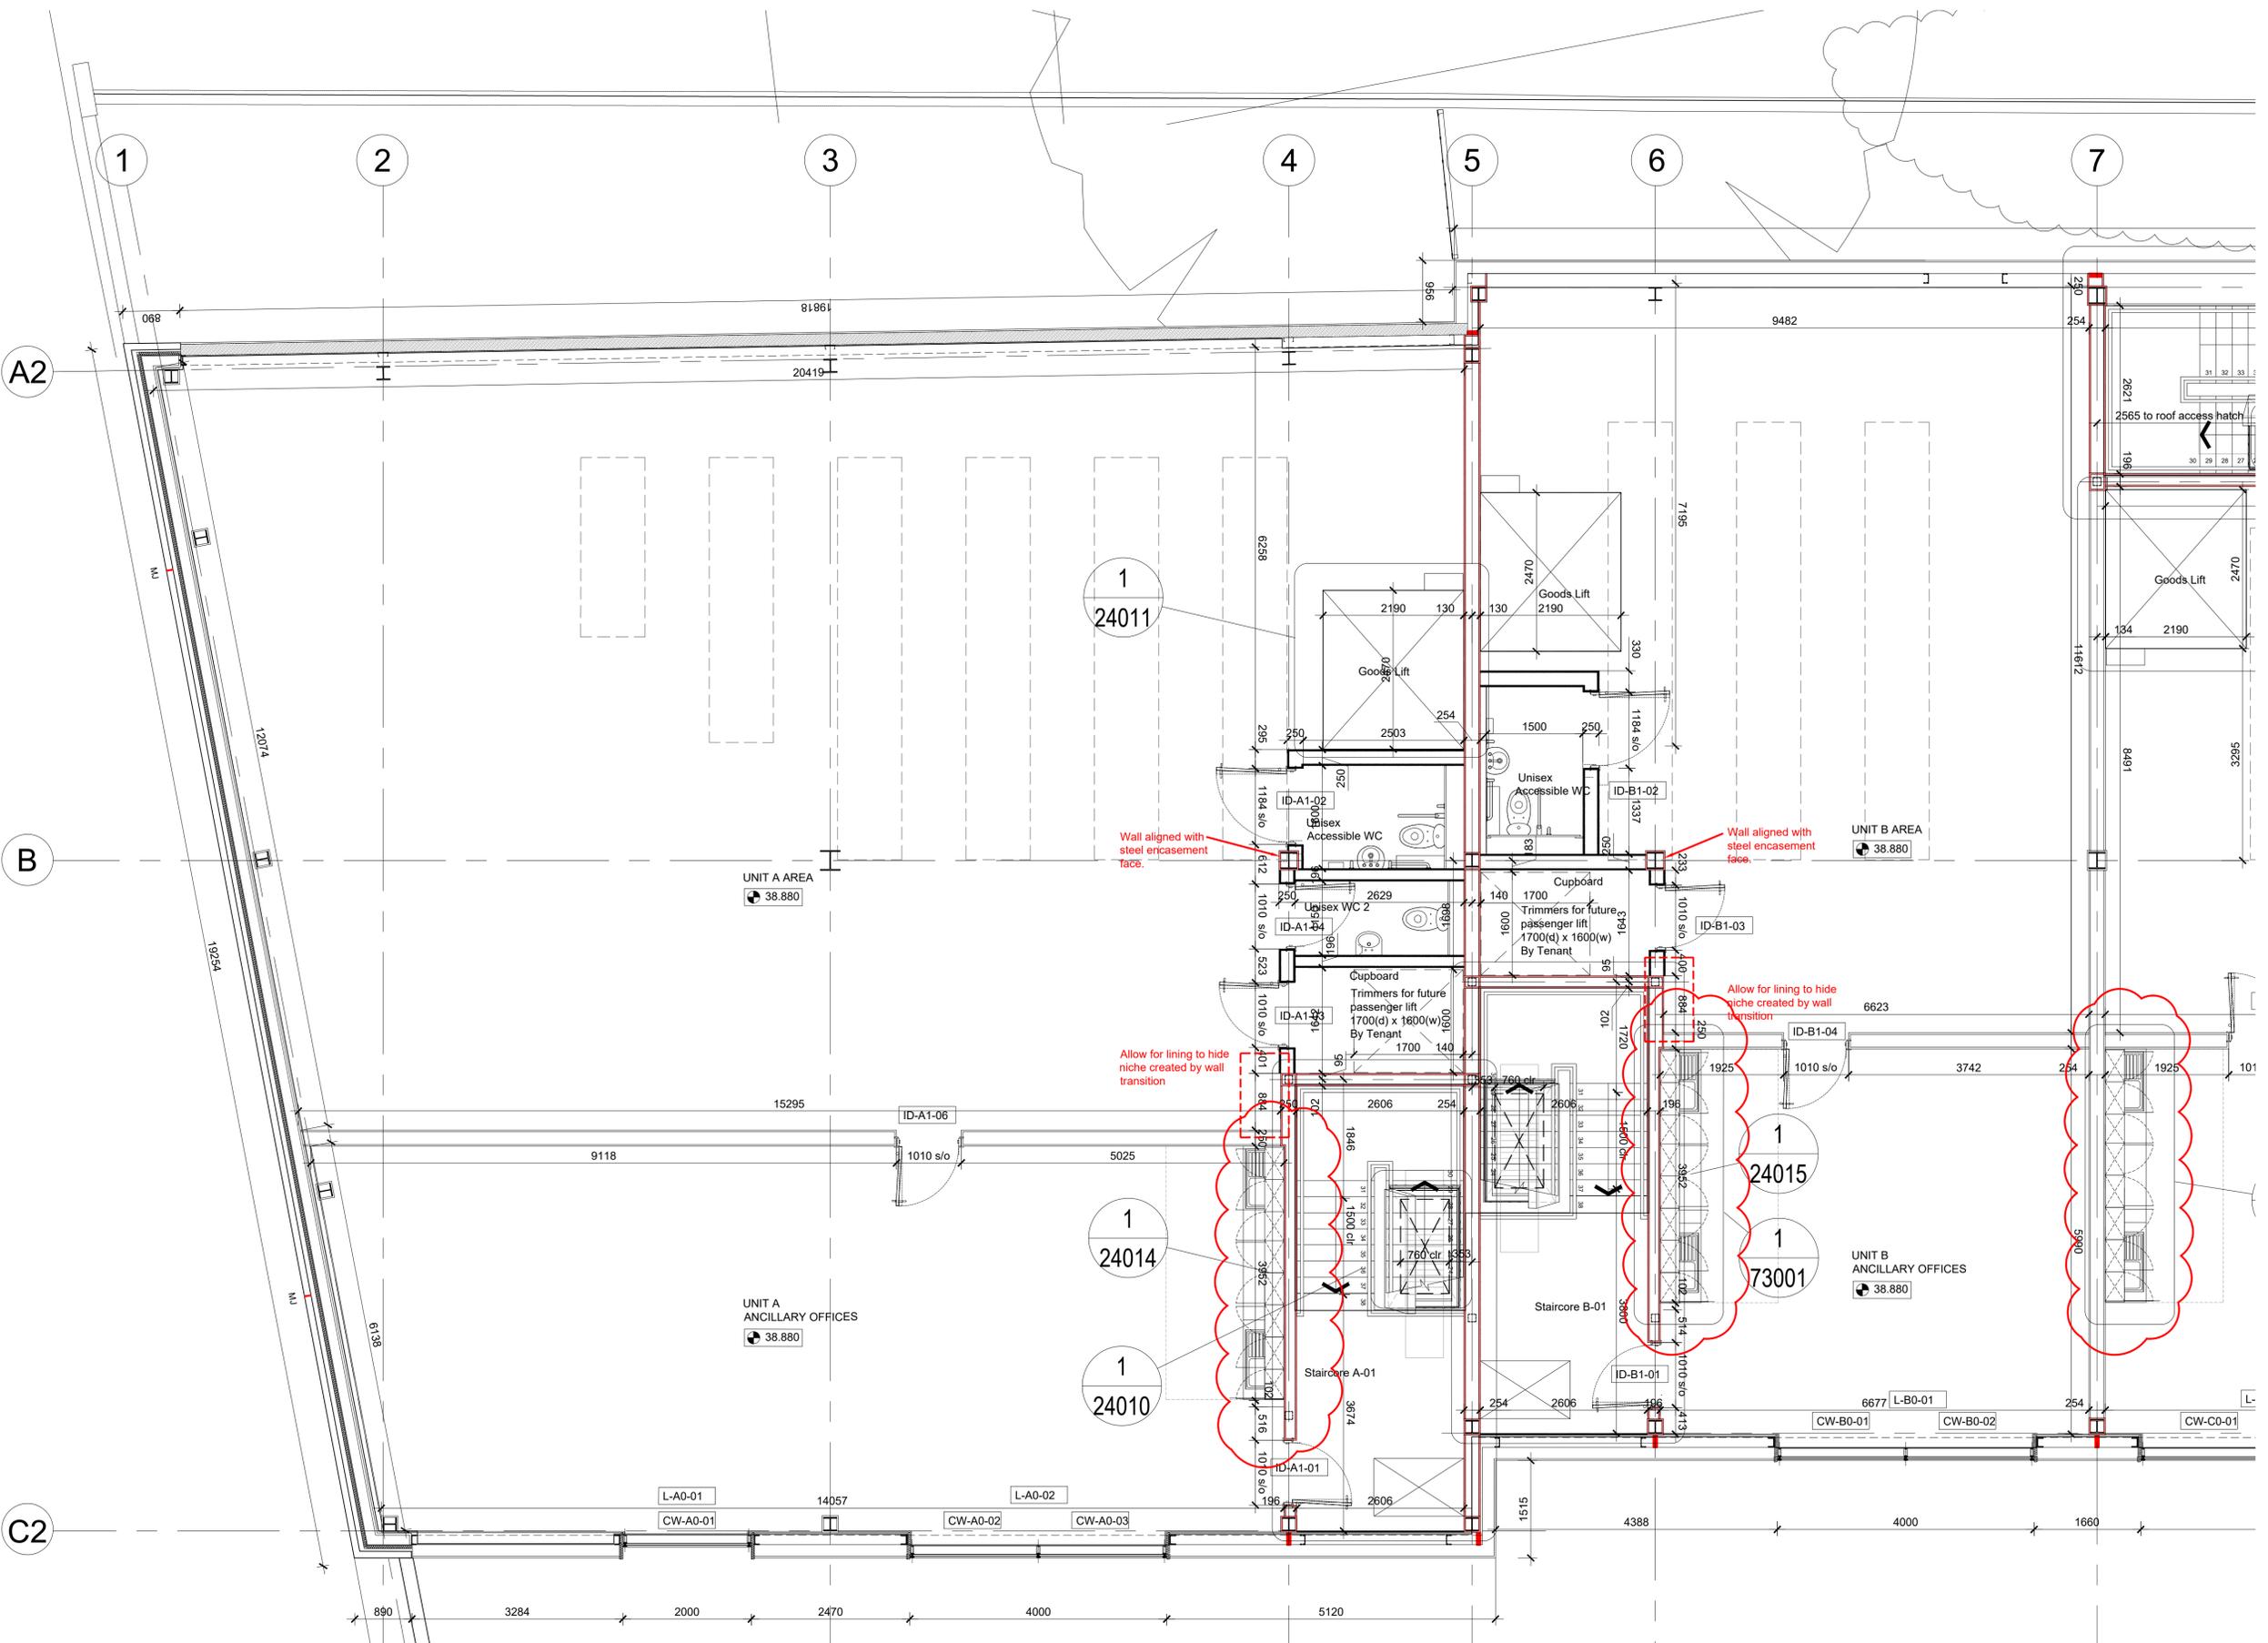

C5	Kitchenettes Updated	28.11.23	CBM/RH
C4	WC to Unit B Updated	15.09.23	CBM/RH
C3	S/O to Internal Doors Updated	06.09.23	CBM/RH
C2	Opening to Door ID-A1-06 Updated Note Added	23.08.23	CBM/RH
C1	Internal Partition Thickness Updated Unit A Toilet Lobby Omitted Toilets Sizes Adjusted Ship Ladder Location Updated in line with Latest Design	13.04.23	MN/RH
P2	Drawing Updated to Reflect Latest GA Layouts and Issued for Construction	31.03.22	CH/RH
P1	Grid Lines Updated First Issue DRAFT	18.03.22	CH/RH

Rev	Revision Description	Date	Author	Reviewer

FOR CONSTRUCTION

12-13 Clarendonwell Green +44 (0)20 7490 2400
 London EC1R 9JY www.chetwoods.com



Project
**BRIXTON HILL, WATERWORKS ROAD
 BRIXTON**
 Client
BLOOM, BRIXTON
 Drawing Title
**Ancillary Offices & Unit Area First Floor Plan
 Units A & B**

Scale	Size	Drawn	Checked	Date
1:50	A1	CH	RH	10/03/2022

Project	Original	Zone	Level	Type	Rev	Number	Rev
5081	CA	00	01	DR	A	01155	C5