




GENERAL ARRANGEMENT PLAN


74 ROUPELL STREET

LONDON, SE1

Third Floor

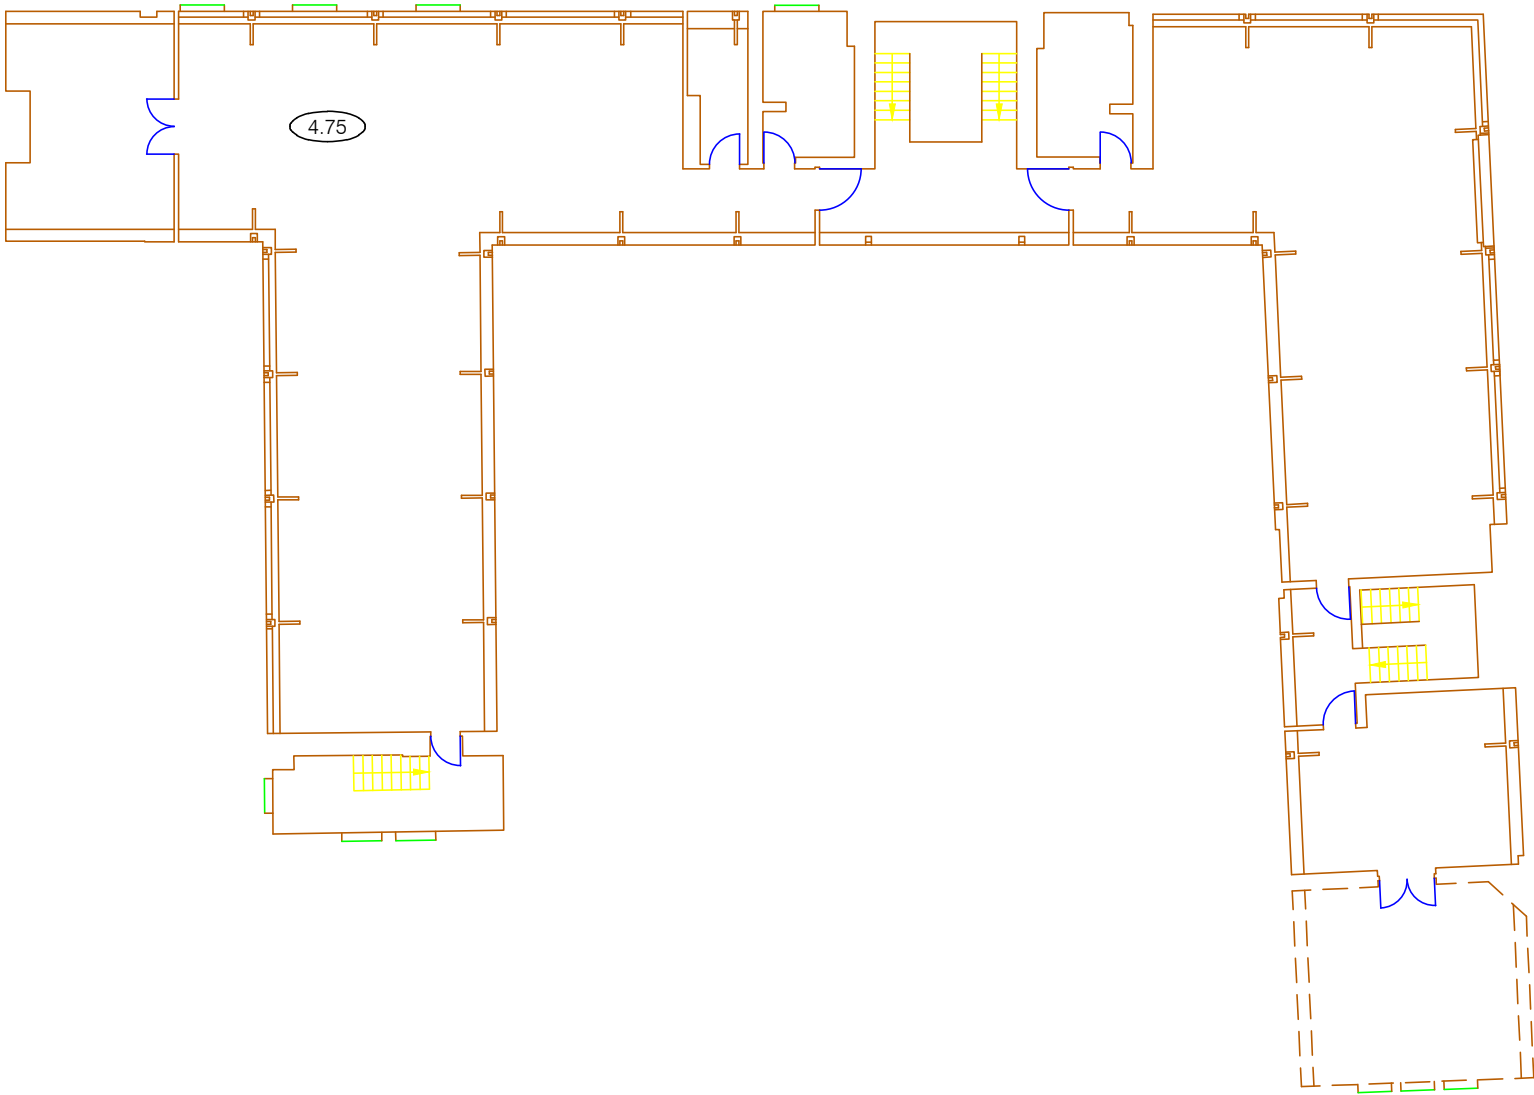

ROUPELL STREET

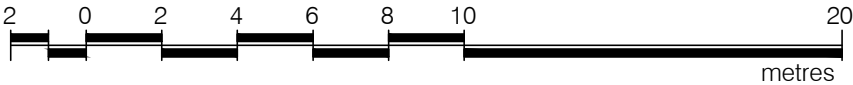

LEGEND

0.00 FLOOR TO CEILING HEIGHT (METRES)

Notes:

Dashed line denotes assumed wall line inaccessible at the time of survey.

This drawing has been produced for area referencing and space planning purposes only. It must not be used for any architectural or construction/engineering purpose or for any other purpose other than that for which it was originally intended.

Care should be taken when drawings are printed to avoid image distortion.

REVISIONS		
Revision	Details	Date
A	Original Issue	December 2025

PRESENTATION SCALE 1:200 @ A3

ISSUE DATE: December 2025

PC PROJECT No. 51050 REVISION

A

DRAWING No.

51050-GA3

Plowman Craven

Plowman Craven House
2 Lea Business Park
Lower Luton Road
Harpenden
Hertfordshire
AL5 5EQ

115 Southwark Bridge Road
London
SE1 0AX

Tel: +44 (0)1582 765566
Email: post@plowmancraven.co.uk
Web: www.plowmancraven.co.uk

Tel: +44 (0)20 7490 7700