



REFERENCES

Net Internal Area

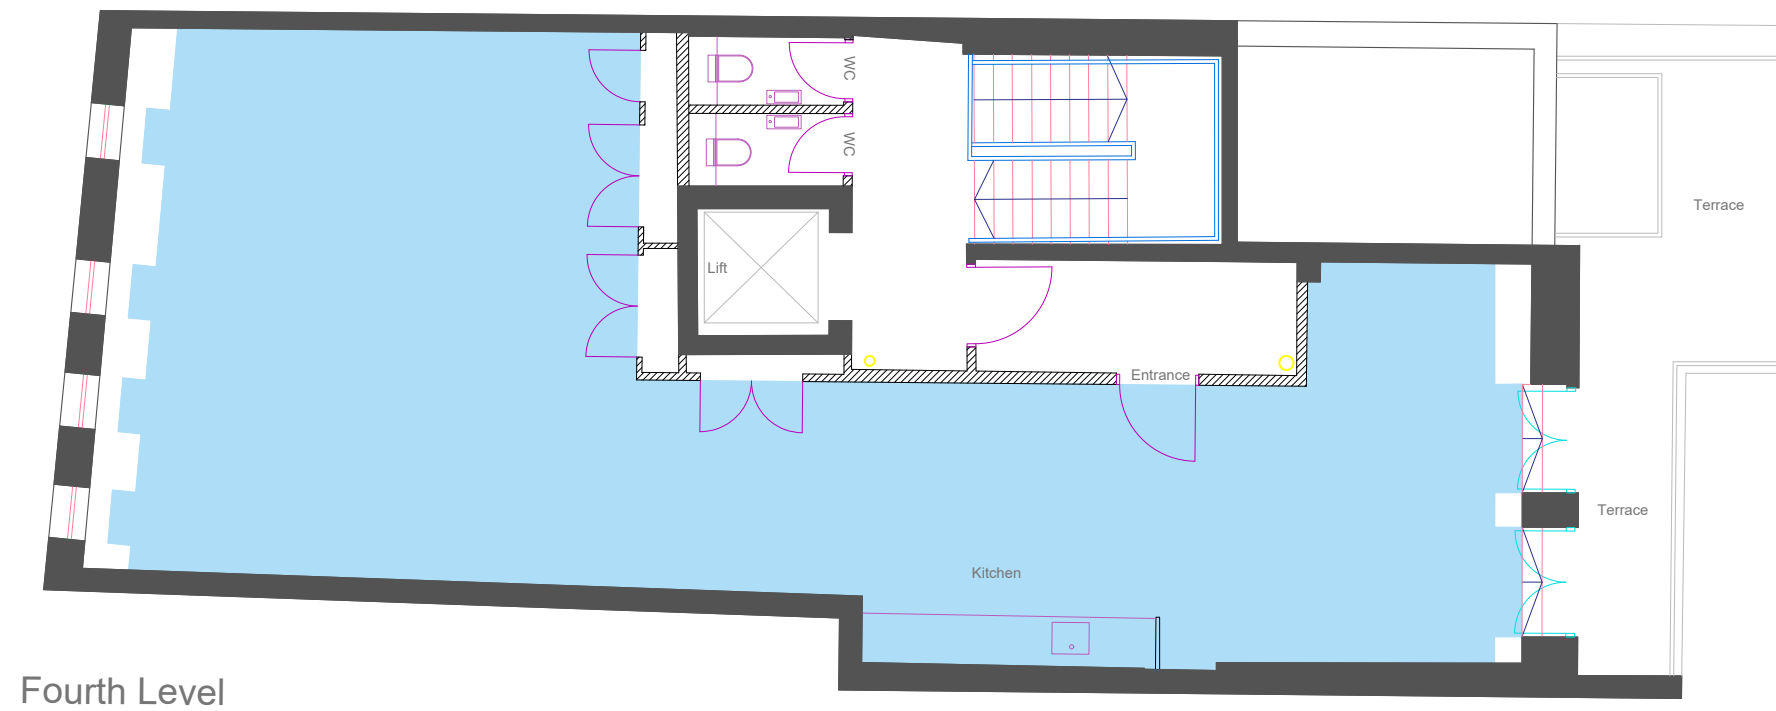

Fourth Level

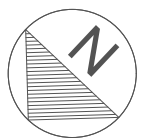

# Clerkenwell Close

18 Clerkenwell Close  
London  
EC1R 0QN

Drawing Name  
Fourth Level Floor Plan

Date	Revision	Project Number	Description	Rev
31/01/2025	00	25.01.3192	Property Survey	0/0

REFERENCE KEY

sterlingtemple

0203 4639225  
www.sterlingtemple.com