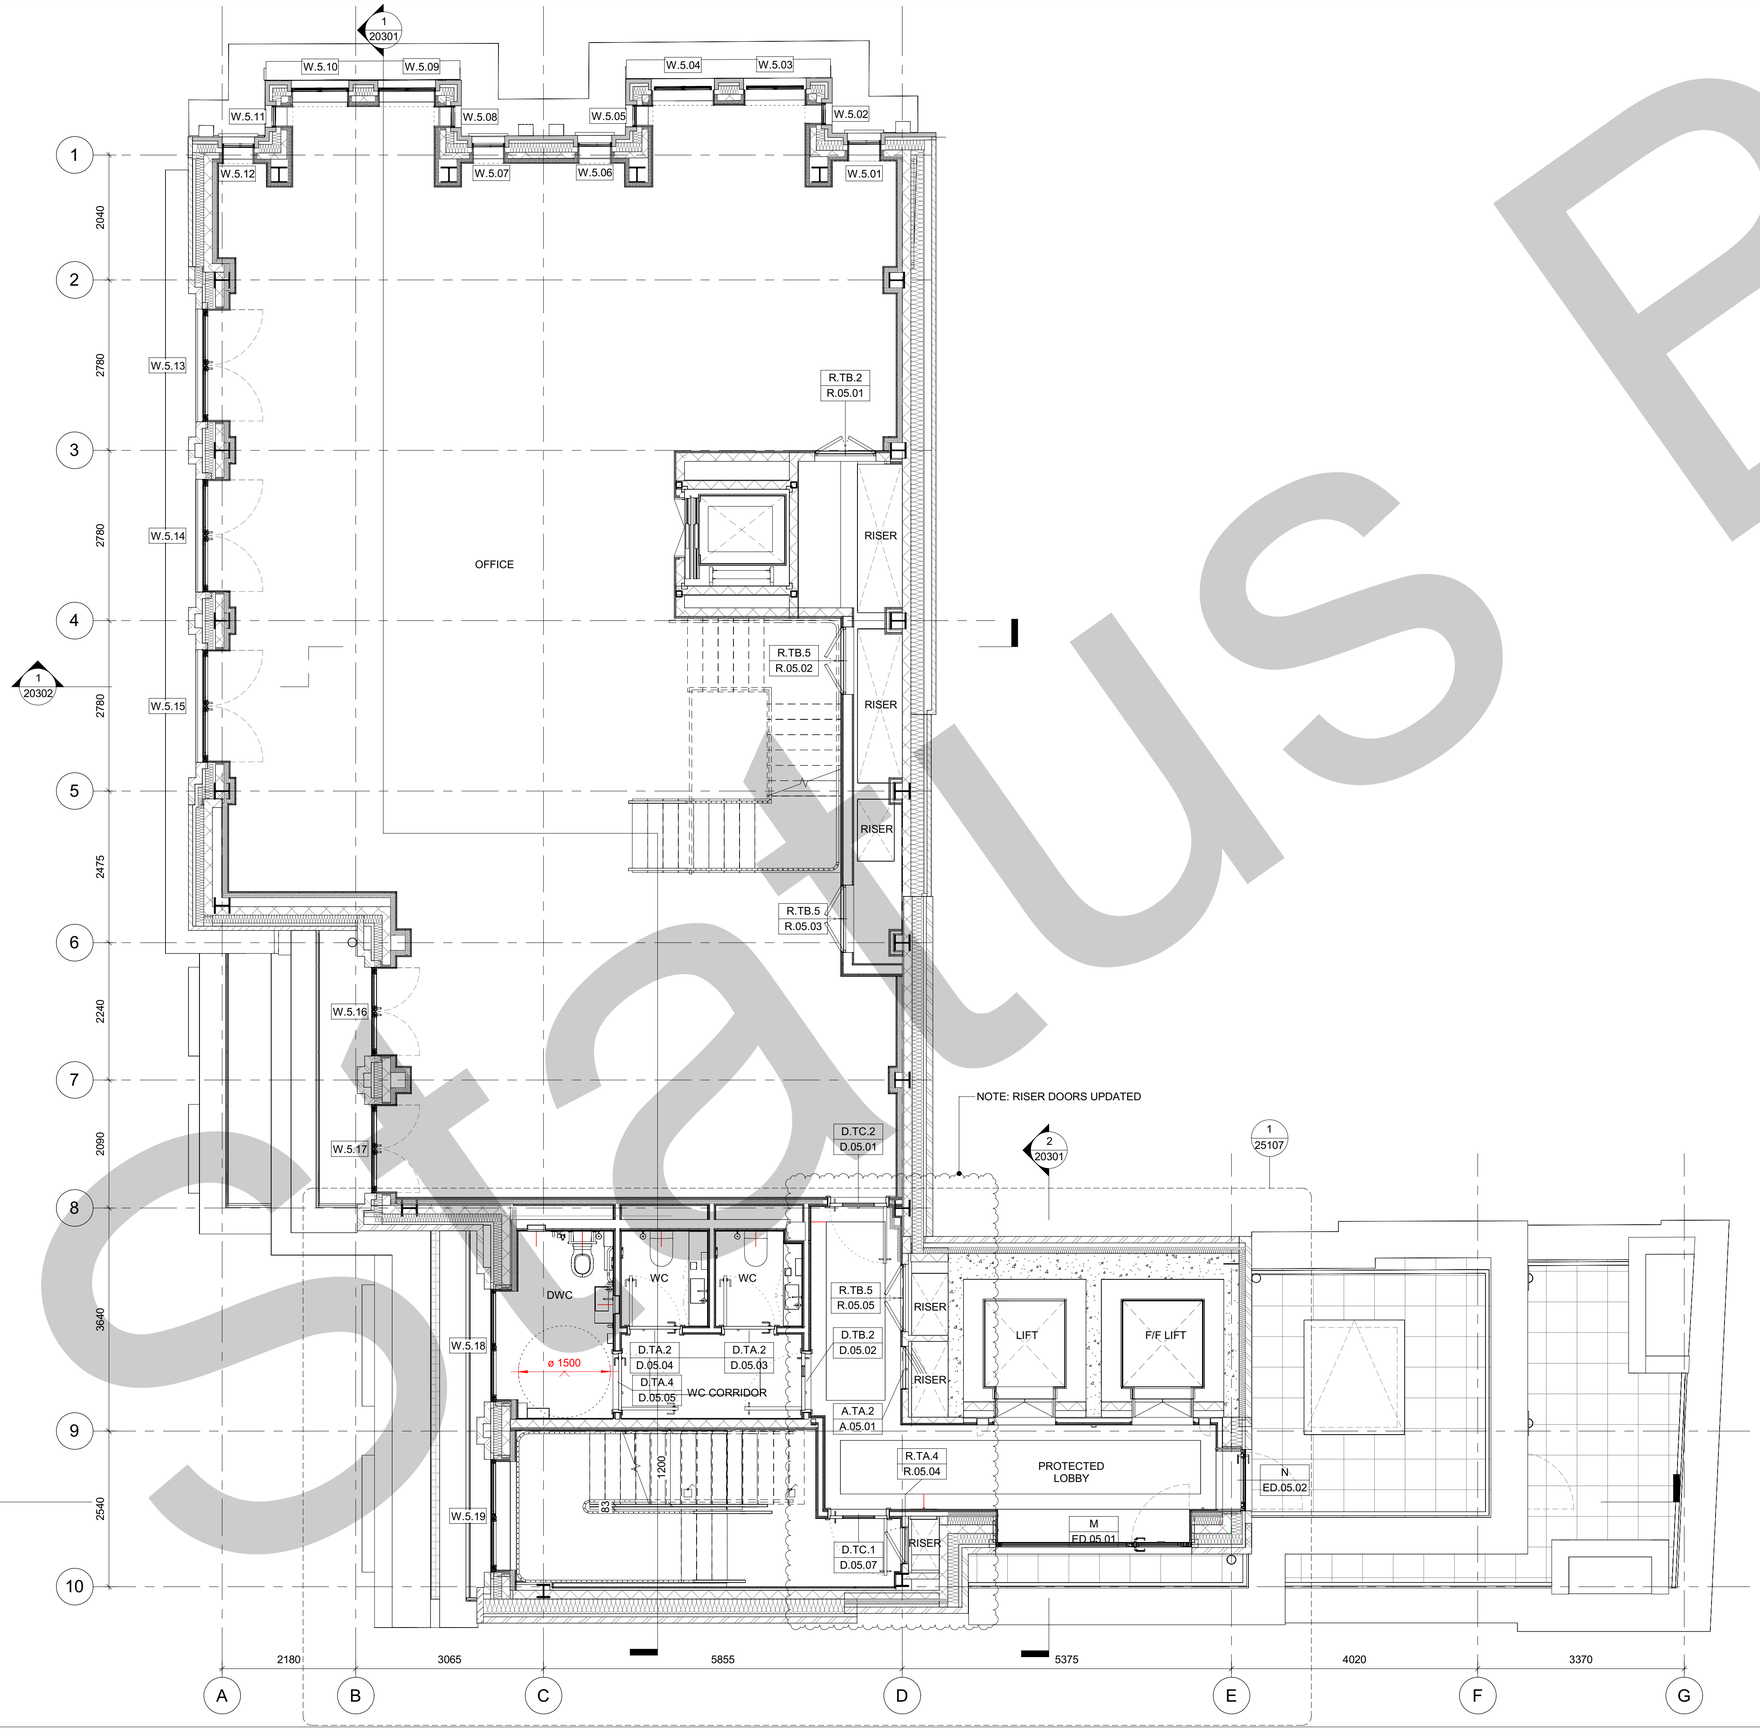

Do not scale from this drawing. All dimensions to be checked on site. All omissions and discrepancies to be reported to the Architect immediately

This work is copyright and shall not be reproduced or used for any other purpose without the written permission of Squire and Partners.

Existing Wall Legend

Existing hatched in grey

Description	Date	Dm/Chk	Rev
Issued for Construction	31/03/25	ADe	C10
Issued for Construction	20/02/25	MGr	C9
Issued for Construction	20/09/24	TK	C8
Construction Issue - Internal Doors, Riser Doors, AOV's Revised	08/07/24	TK	C7
Construction Issue - Internal Doors, Riser Doors, AOV's Revised	28/06/24	TK	C6
Construction Issue - For Review and Comment	07/05/24		C5
Issued For Construction	13/09/23	CBI	C4
Construction Issue	21/04/23	ST	C3
Construction Issue	22/03/23	ST	C2
Construction Issue	03/02/22	ST	C1
Issued for Main Works Tender	04/10/21	ST	T1

SQUIRE & PARTNERS

Squire and Partners LLP
The Department Store
248 Ferndale Road, London SW9 8FR
T: 020 7278 5555

info@squireandpartners.com
www.squireandpartners.com

Project

13-14 Hanover Street
Mayfair, London W1S1YH

Title

General Arrangement
Fifth Floor Plan

Suitability	Status	
S4	For Stage Approval	
Date	Scale @ ISO A1	Job Number
30/06/2020	1 : 50	18103
Drawing Number		Revision
18103-SQP-ZZ-05-DR-A-20118		C10

Status B