



- Notes:
1. Drawing to be read in conjunction with a full set of drawings, schedules, specifications and information from Structural Engineer & other Consultants.
 2. Contractor to refer all discrepancies to Architect.
 3. Pre-construction documentation for costing/contract purposes only. Unless marked 'For Construction' drawings are not to be used for Construction.
 4. Contractor to check all dimensions on site before production of any Shop Drawings, fabrication and commencement on site.


ANIKO.architect

Existing staircase retained.
Staircase to be REI30 protected.

Existing lift retained.
Lift to be checked on site.

SVP from FLAT 4 and FLAT 5
above to be boxed out near the
existing column.

New door to the front to access
Flats above.

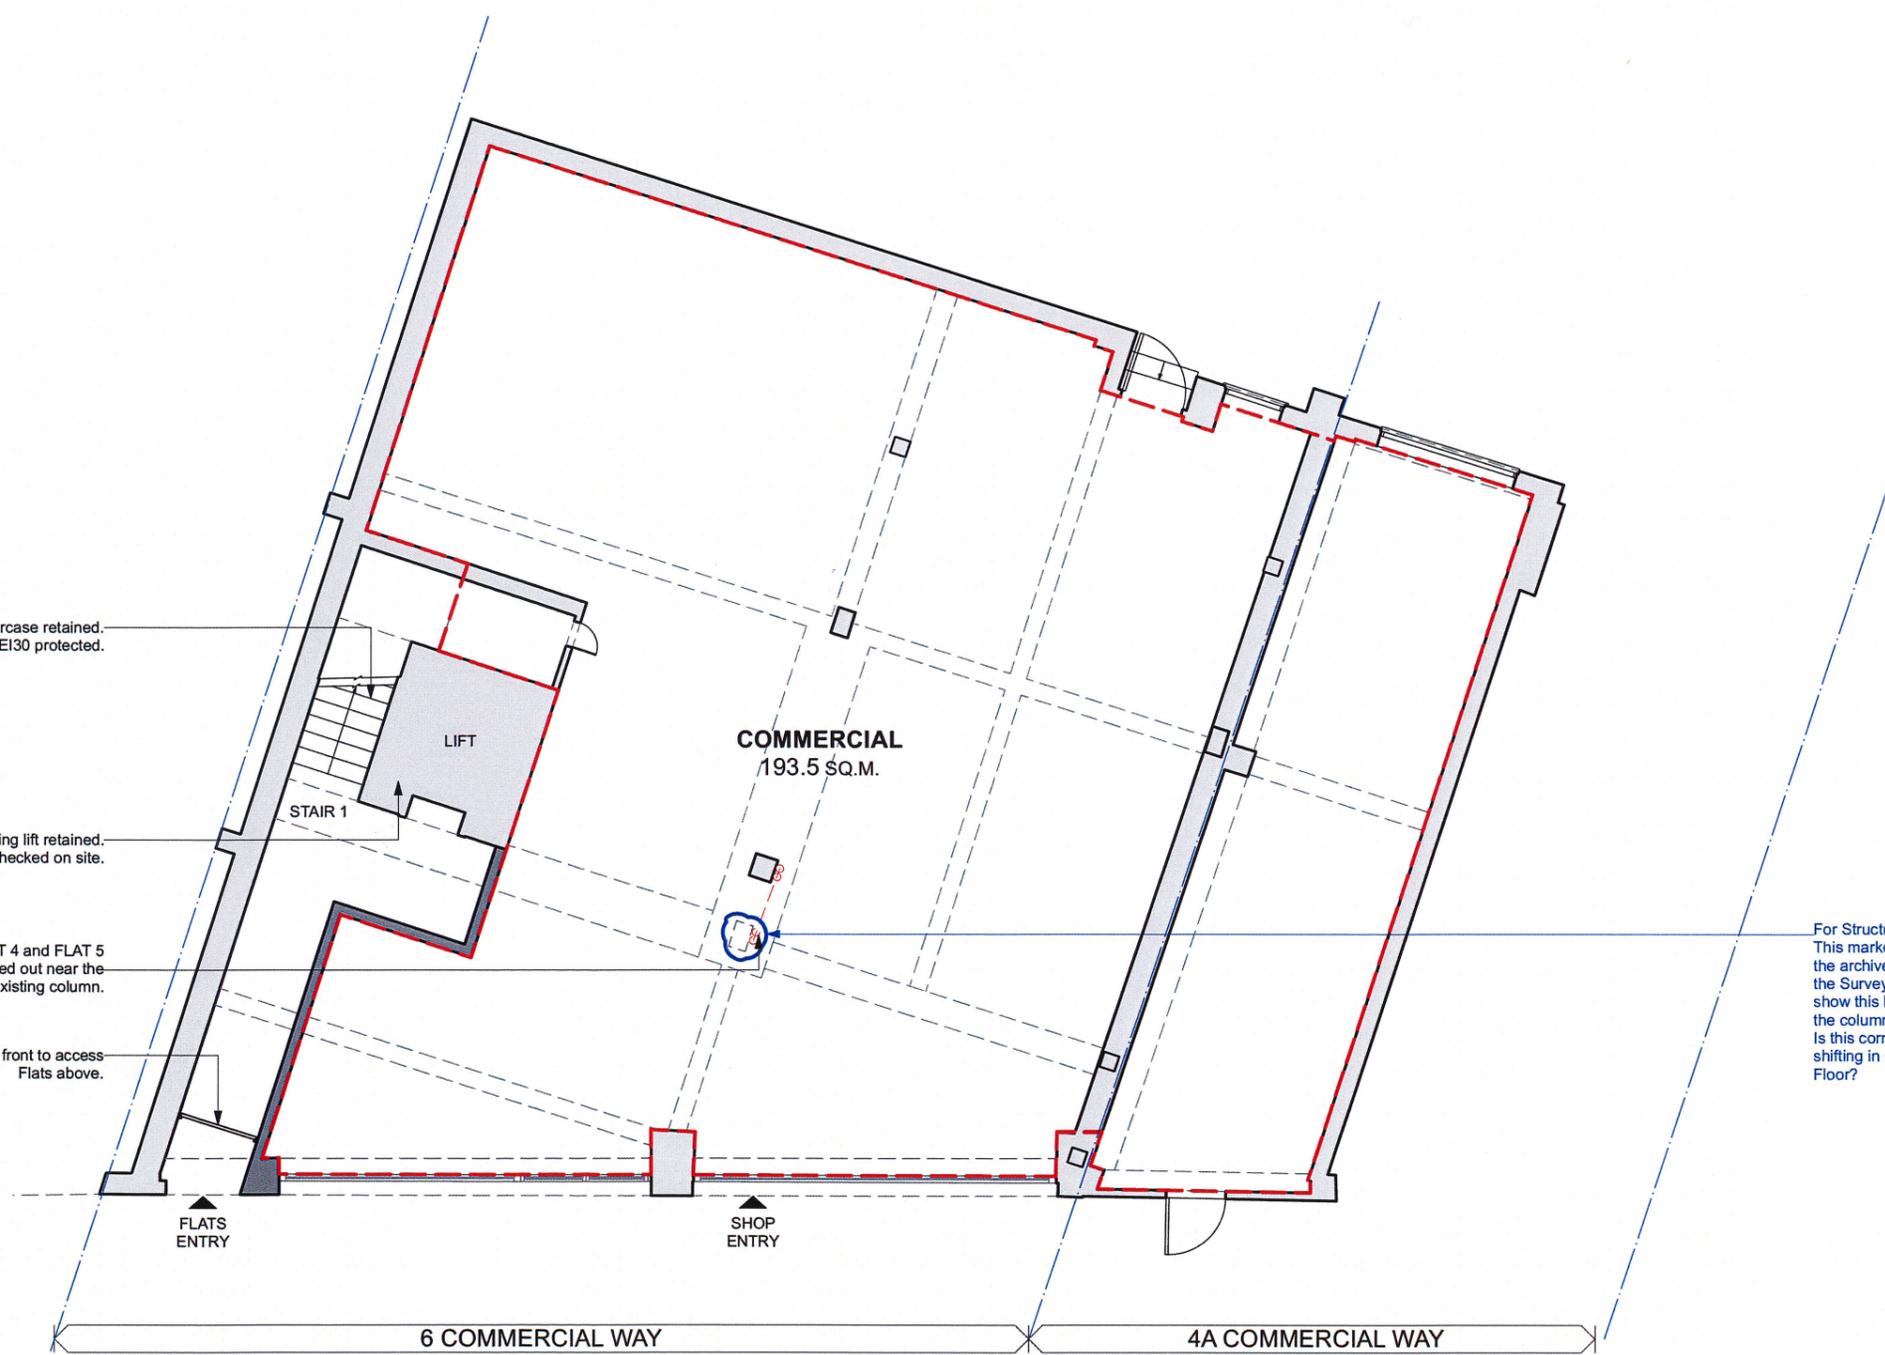

For Structure Engineer:
This marked column is shown in
the archive and in First Floor. But
the Survey drawing does not
show this here. It is replaced by
the column above this.
Is this correct/possible? Column
shifting in Ground and First
Floor?

1 PROPOSED GROUND FLOOR PLAN - OPTION B
Scale: 1:100

No.	Date	Issue Notes
Project ID		2502
Project Title		COMMERCIAL WAY, WOKING
Sheet Title		PROPOSED GROUND FLOOR PLAN
Date		25/01/2026
Scale		1:1
Sheet No.	Rev. No.	
020 B		