


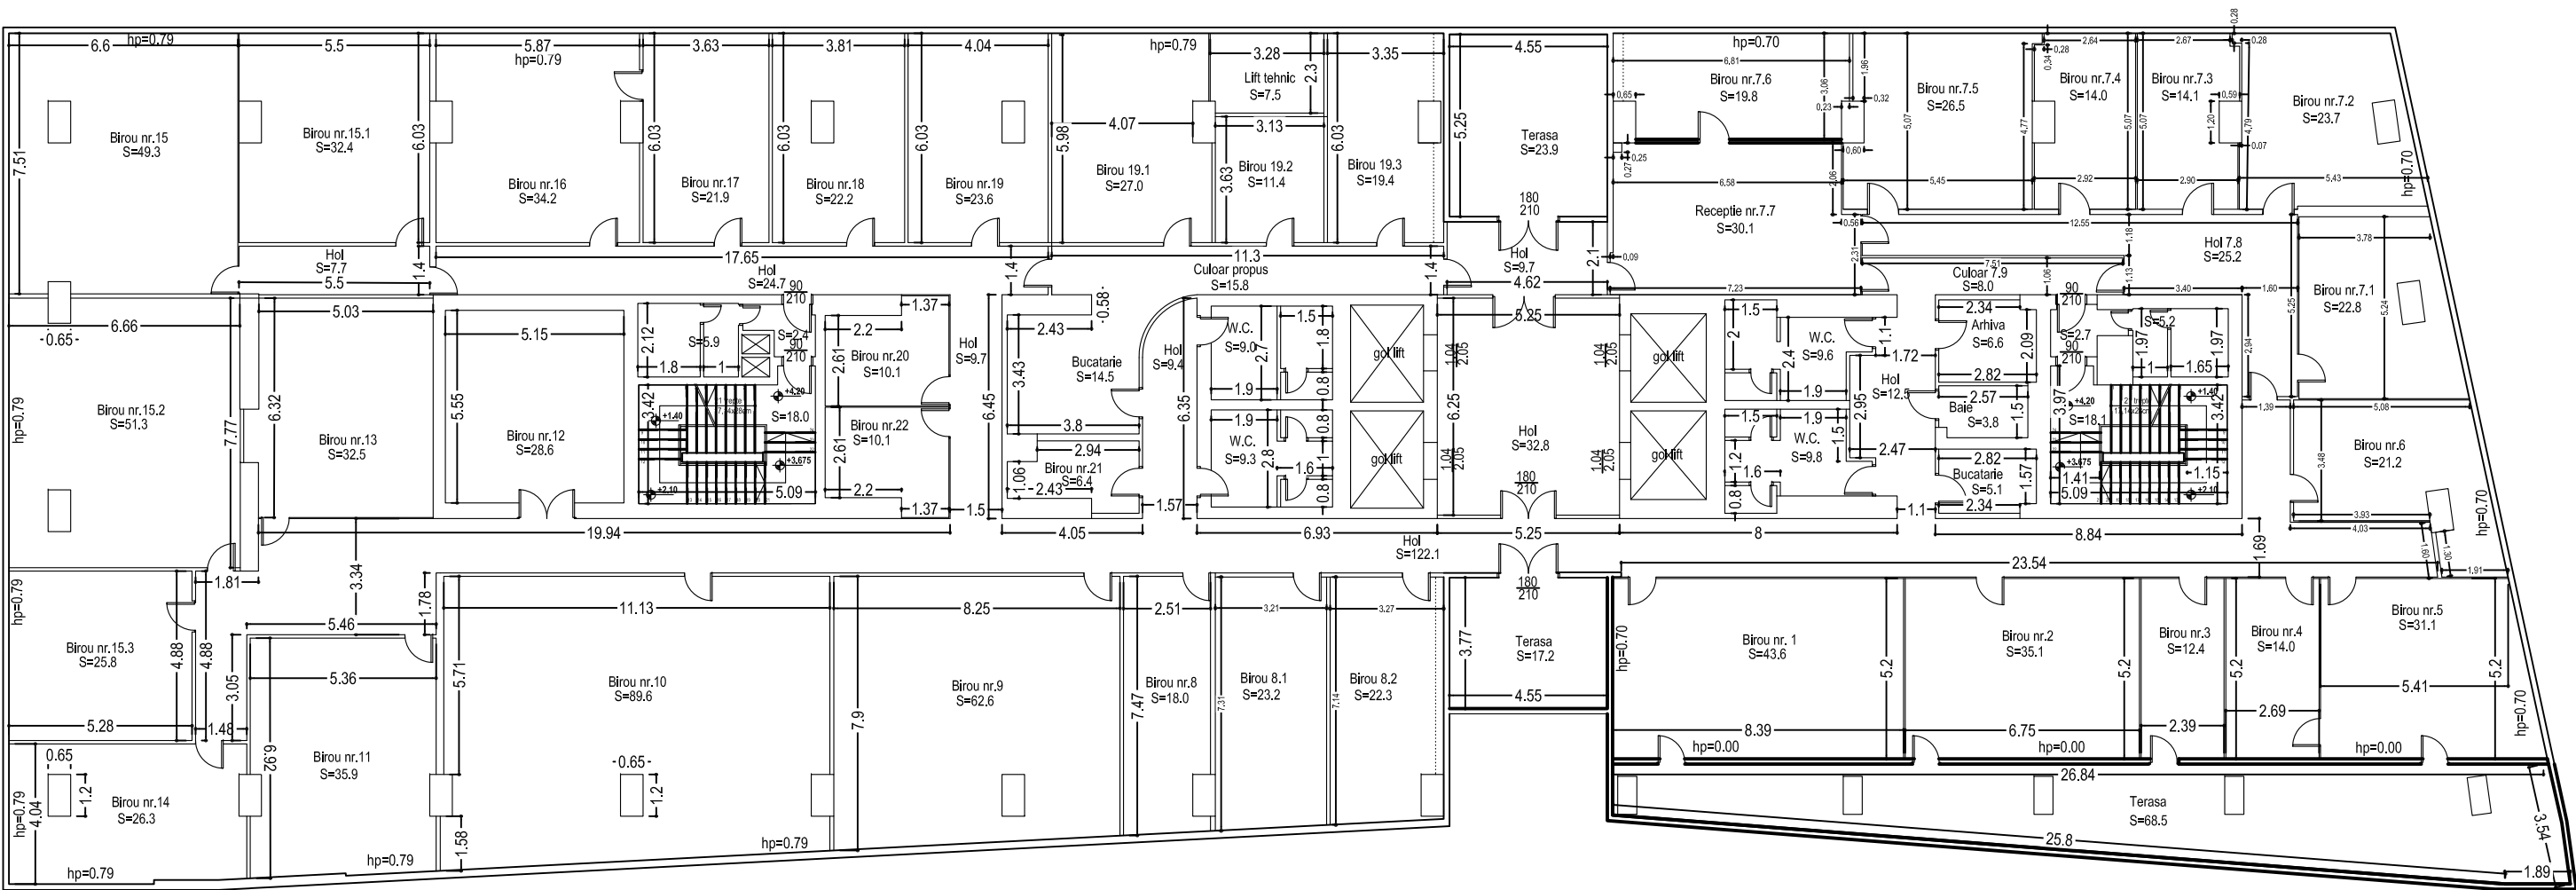

	DESENAT	Ing. Doru Sarchis		
	VERIFICAT	Ing. Doru Sarchis		
	SEF COLECTIV	Ing. Doru Sarchis		
APROBAT	Ing. Doru Sarchis		DATA Noiembrie 2023	

PLANSA

2

COMANDA

101