




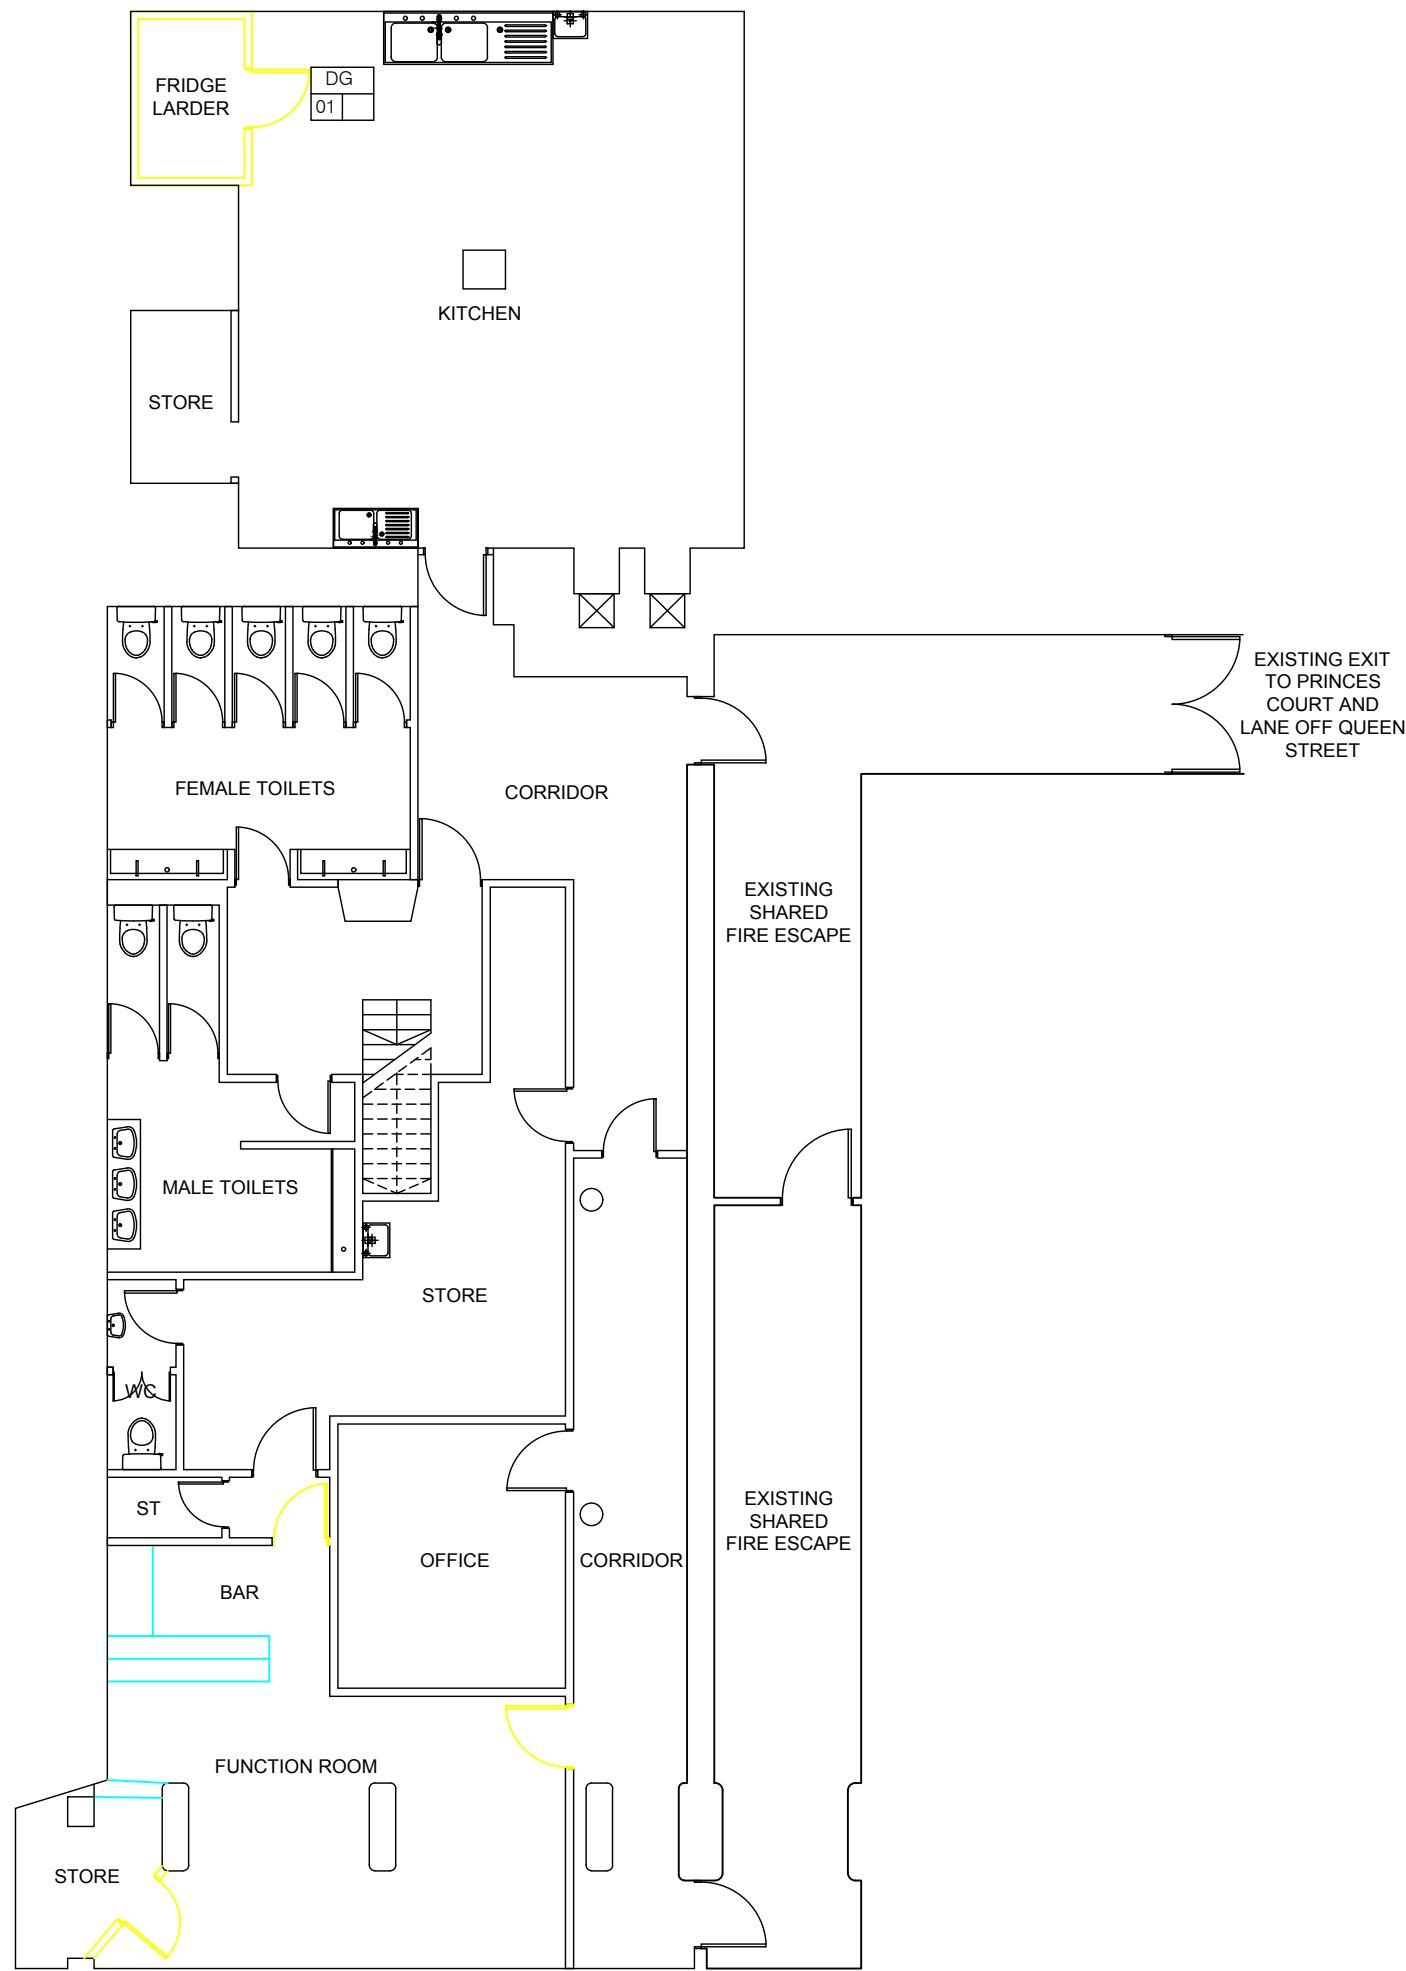

BASEMENT LAYOUT AS PROPOSED

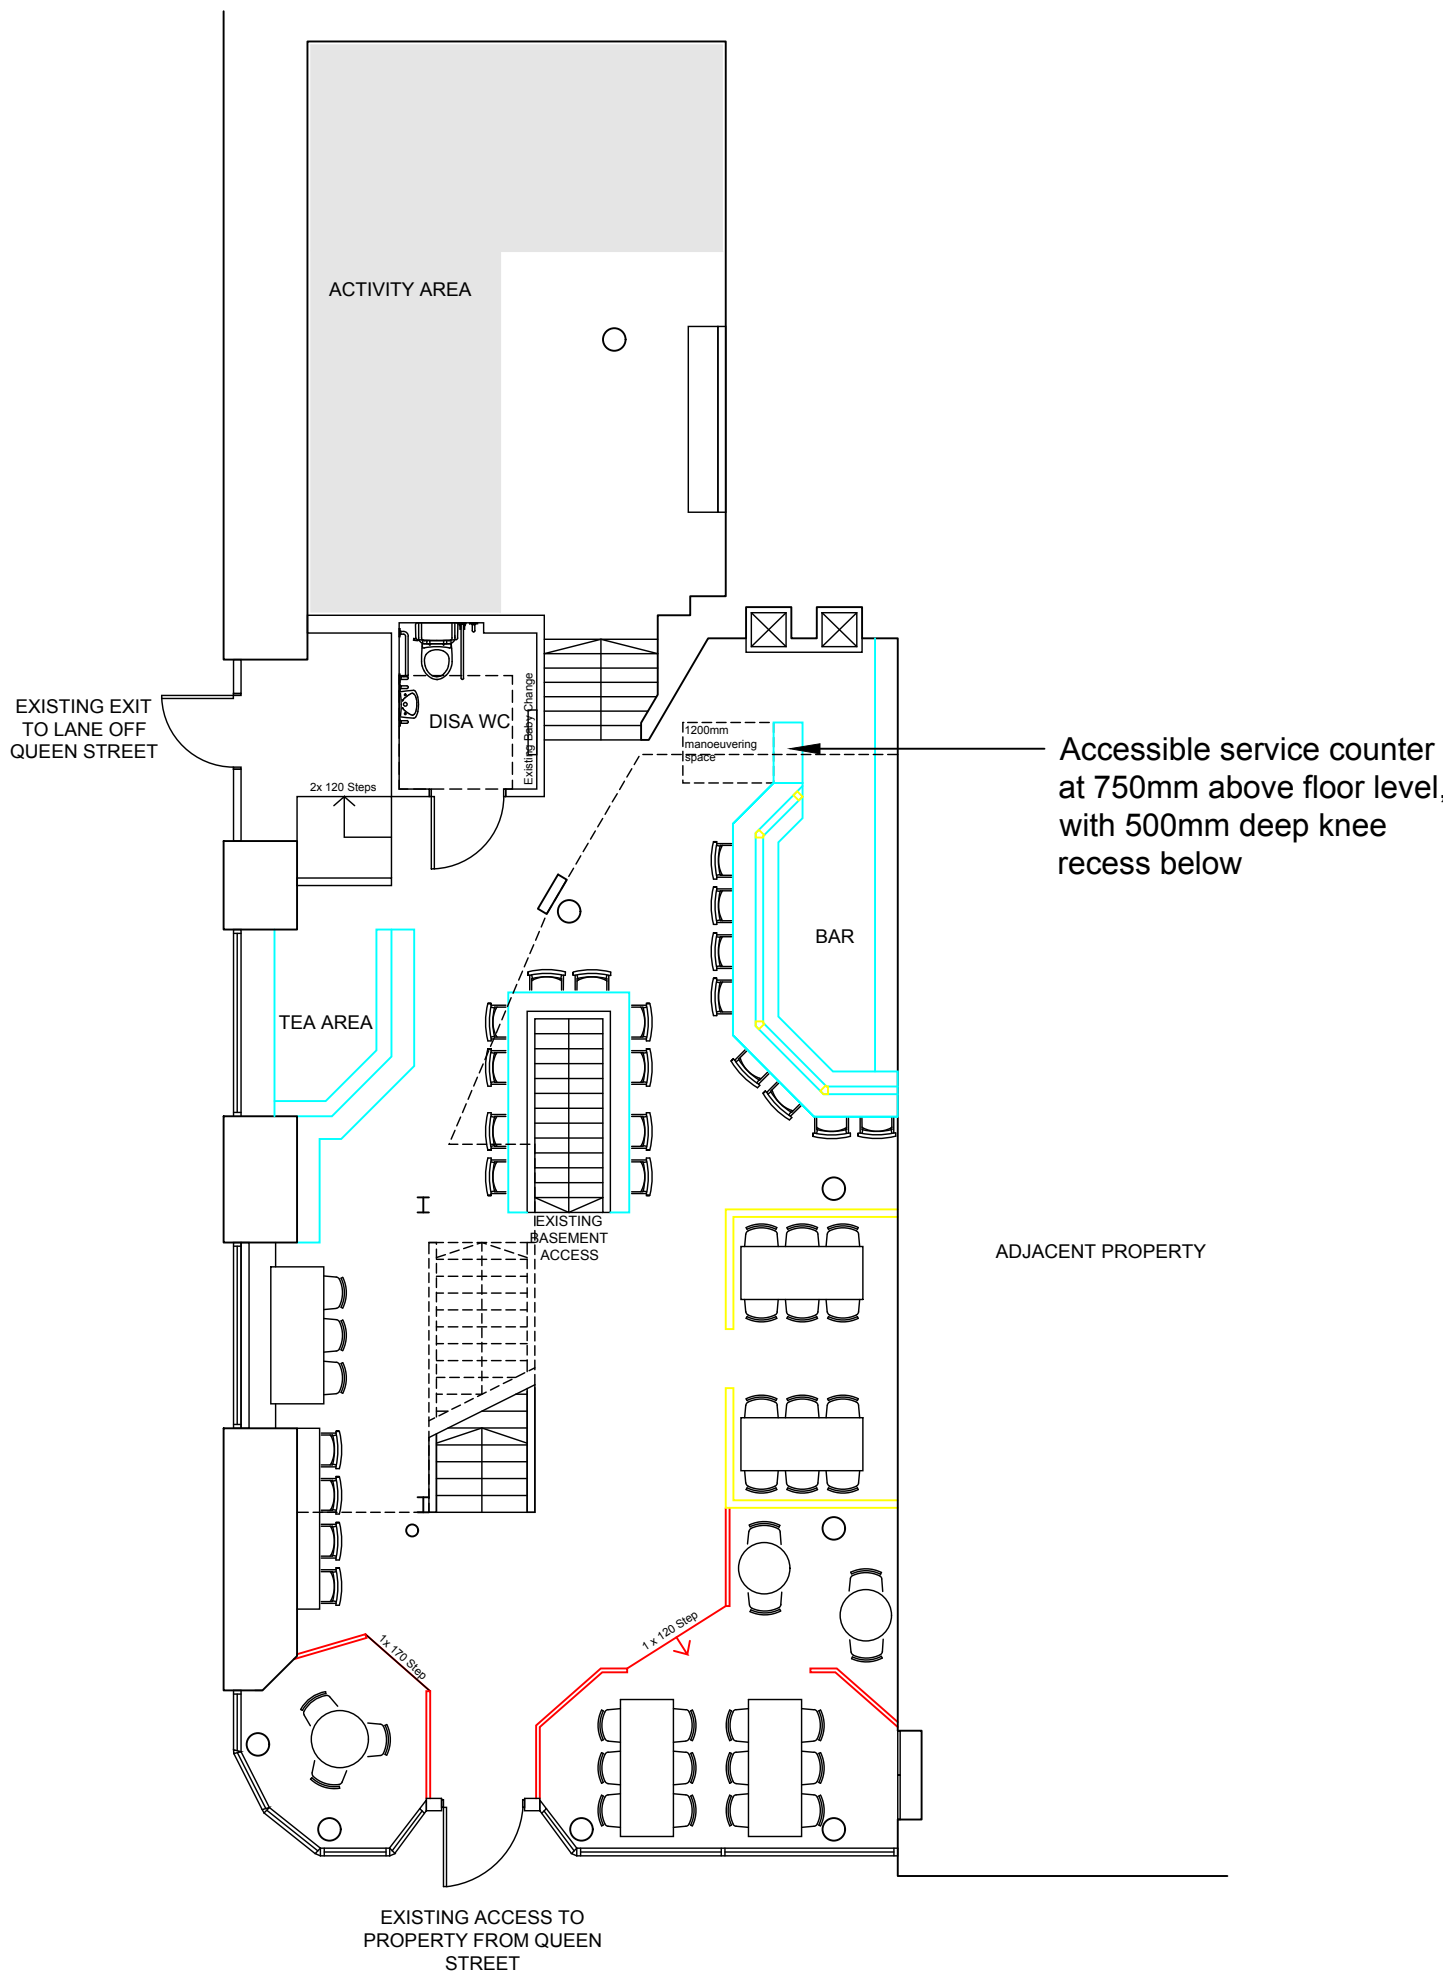

GROUND FLOOR LAYOUT AS PROPOSED

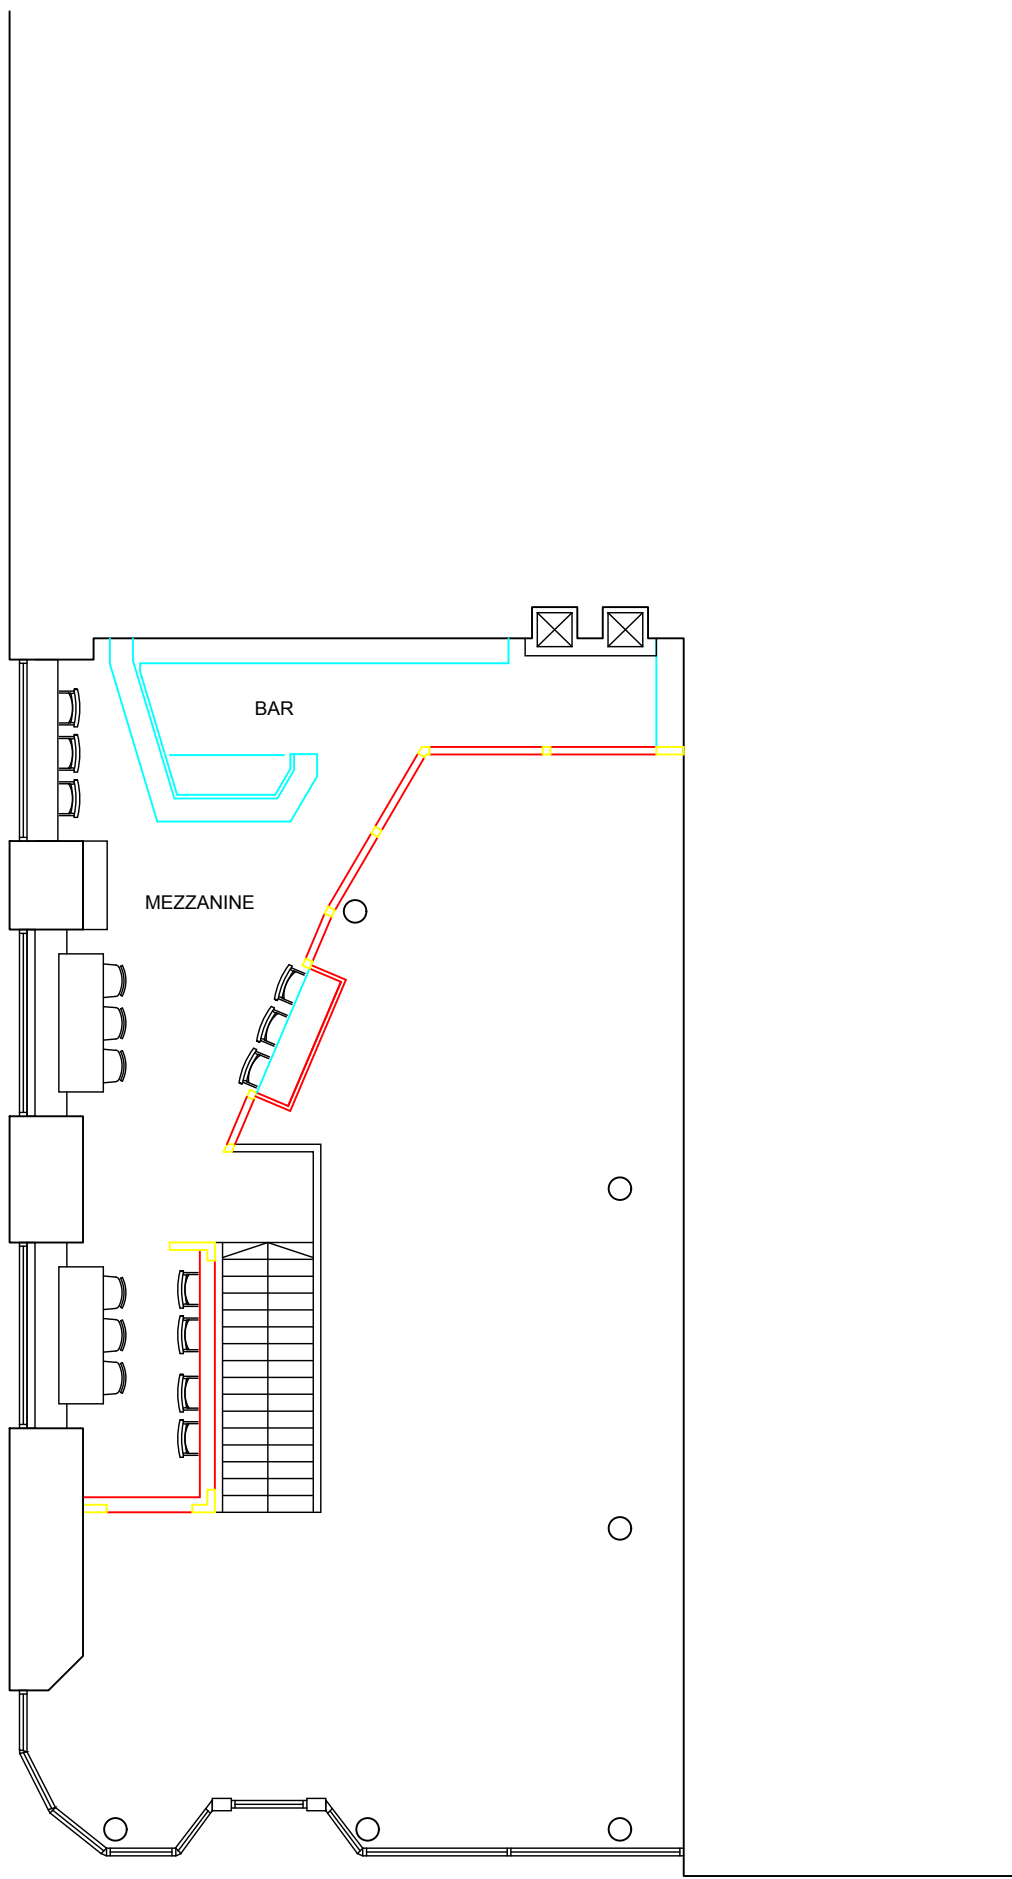

FIRST FLOOR LAYOUT AS PROPOSED

ALL DIMENSIONS TO BE CHECKED ON SITE
DO NOT SCALE FROM THIS DRAWING.
USE FIGURED DIMENSIONS ONLY.
IF IN DOUBT ASK.
THIS DRAWING IS THE COPYRIGHT OF CRGP LTD. AND SHOULD NOT BE
REPRODUCED IN ANY FORMAT WITHOUT PRIOR APPROVAL.

Key:
New non-load bearing internal wall
New balustrade/step
New bar/counter

Note:
All new balustrades to be 1100mm high

A	210111	All proposed works shown in colour, function area added to basement	RG	GS
REV	DATE	DESCRIPTION	BY	CHKD

crgp limited

26 Herbert Street

Glasgow

G20 6NB

also in Inverness

t : 0141 3372255

w: www.crgp.co.uk

crgp

Architecture Building Surveying Project Management Quantity Surveying

CLIENT

DARIO BERNARDI

PROJECT

MIKAKU, QUEEN STREET

DRG. TITLE

PROPOSED FLOOR PLANS

STATUS

BUILDING WARRANT

DRAWN **SM**

CHECKED **RG**

JOB NO. **101 0083**

SCALE **1:100**

ORIGINAL **A1**

DATE **Sept' 20**

DRG. NO.-REV.

101 0083-L(20)001-A