


This drawing must not be scaled. Discrepancies are to be reported to the Architect immediately. All dimensions are approximate and are to be checked on site. All information to be subject to site surveys. This drawing, or any portion of it must not be reproduced without prior consent from the Architect.

C	Joseph	Boniface	Architects	Lto

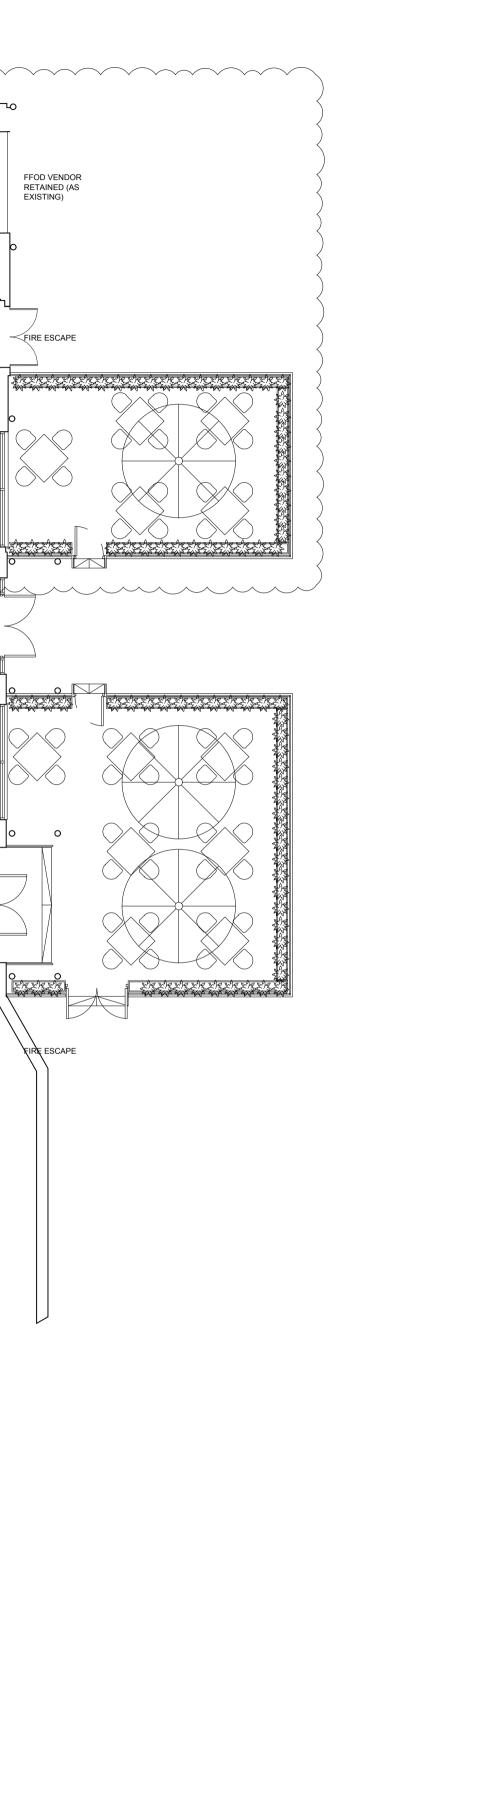

3	- Terrace amended.	23/05/25	JB			
4	- Food vendor reinstated. Terrace illustrated and fire	04/09/23	LS/JB			
	escape re routed - Initial issue.	02/06/23	LS/JB			
Rev.	Amendment	Date	By/Chk			
Boniface Architects						
RIB	eph Boniface Architects A Chartered Practice	Ltd				
RIB 012 001		co.uk	LA.			
CIB 2012 2001 2001 2001 2001 2001 2001 200	A Chartered Practice 53 280 485 ifacearchitects.co.uk e@bonifacearchitects.co Caunce Street, Blackpoo ect rrie England Internal furbishment,	co.uk ol, FY1 3				
