

Sources:


Levels are related to Ordnance Survey Datum via GPS Observations

Survey location is related to Ordnance Survey Grid via GPS Observations.

All information contained in this drawing (including digital data) should be checked and verified prior to any fabrication or construction.

Key:

- WS Floor to Window Sill Height
- WH Window Sill to Head Height
- 2.30 Floor to Finished Ceiling Height
- 10.00 Finished Floor Level
- FC False Ceiling
- G Gully
- IC Inspection Cover
- V Vent
- A/C Air Conditioning Unit
- H Height

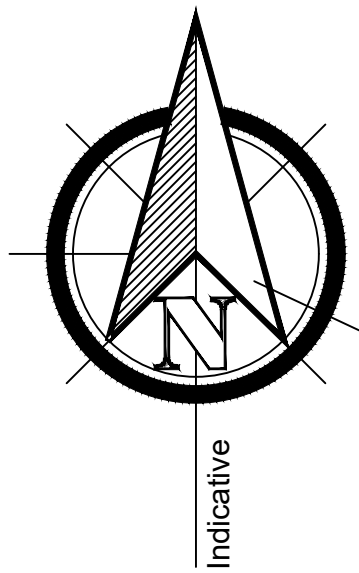

Project: 47 Fleet Street, London

Title: Third Floor Plan

Point 2 Surveyors Ltd,
3rd Floor,
17 Slingsby Place,
London WC2E 9AB,
0207 836 5828
www.point2surveyors.com



Drawn By: ST

Scale: 1:50 @ A0

Date: November 2017

Dwg No: P1570/3/01