



Notes

ALL LEVELS ARE IN METRES DERIVED FROM GPS TRANSFORMATION OSGM15
THE CO-ORDINATES ARE DERIVED FROM THE ORDNANCE SURVEY

- sh sill to head height
- fs floor to sill height
- u/s underside height
- t/s topside height
- fb floorboard direction
- conc concrete
- rl roof light
- cup'd cupboard
- fp fireplace
- sd sliding door
- s/vp soil and vent pipe
- rwp rain water pipe
- carpet carpet
- ⊙ room height
- roof slope
- ▬ radiator

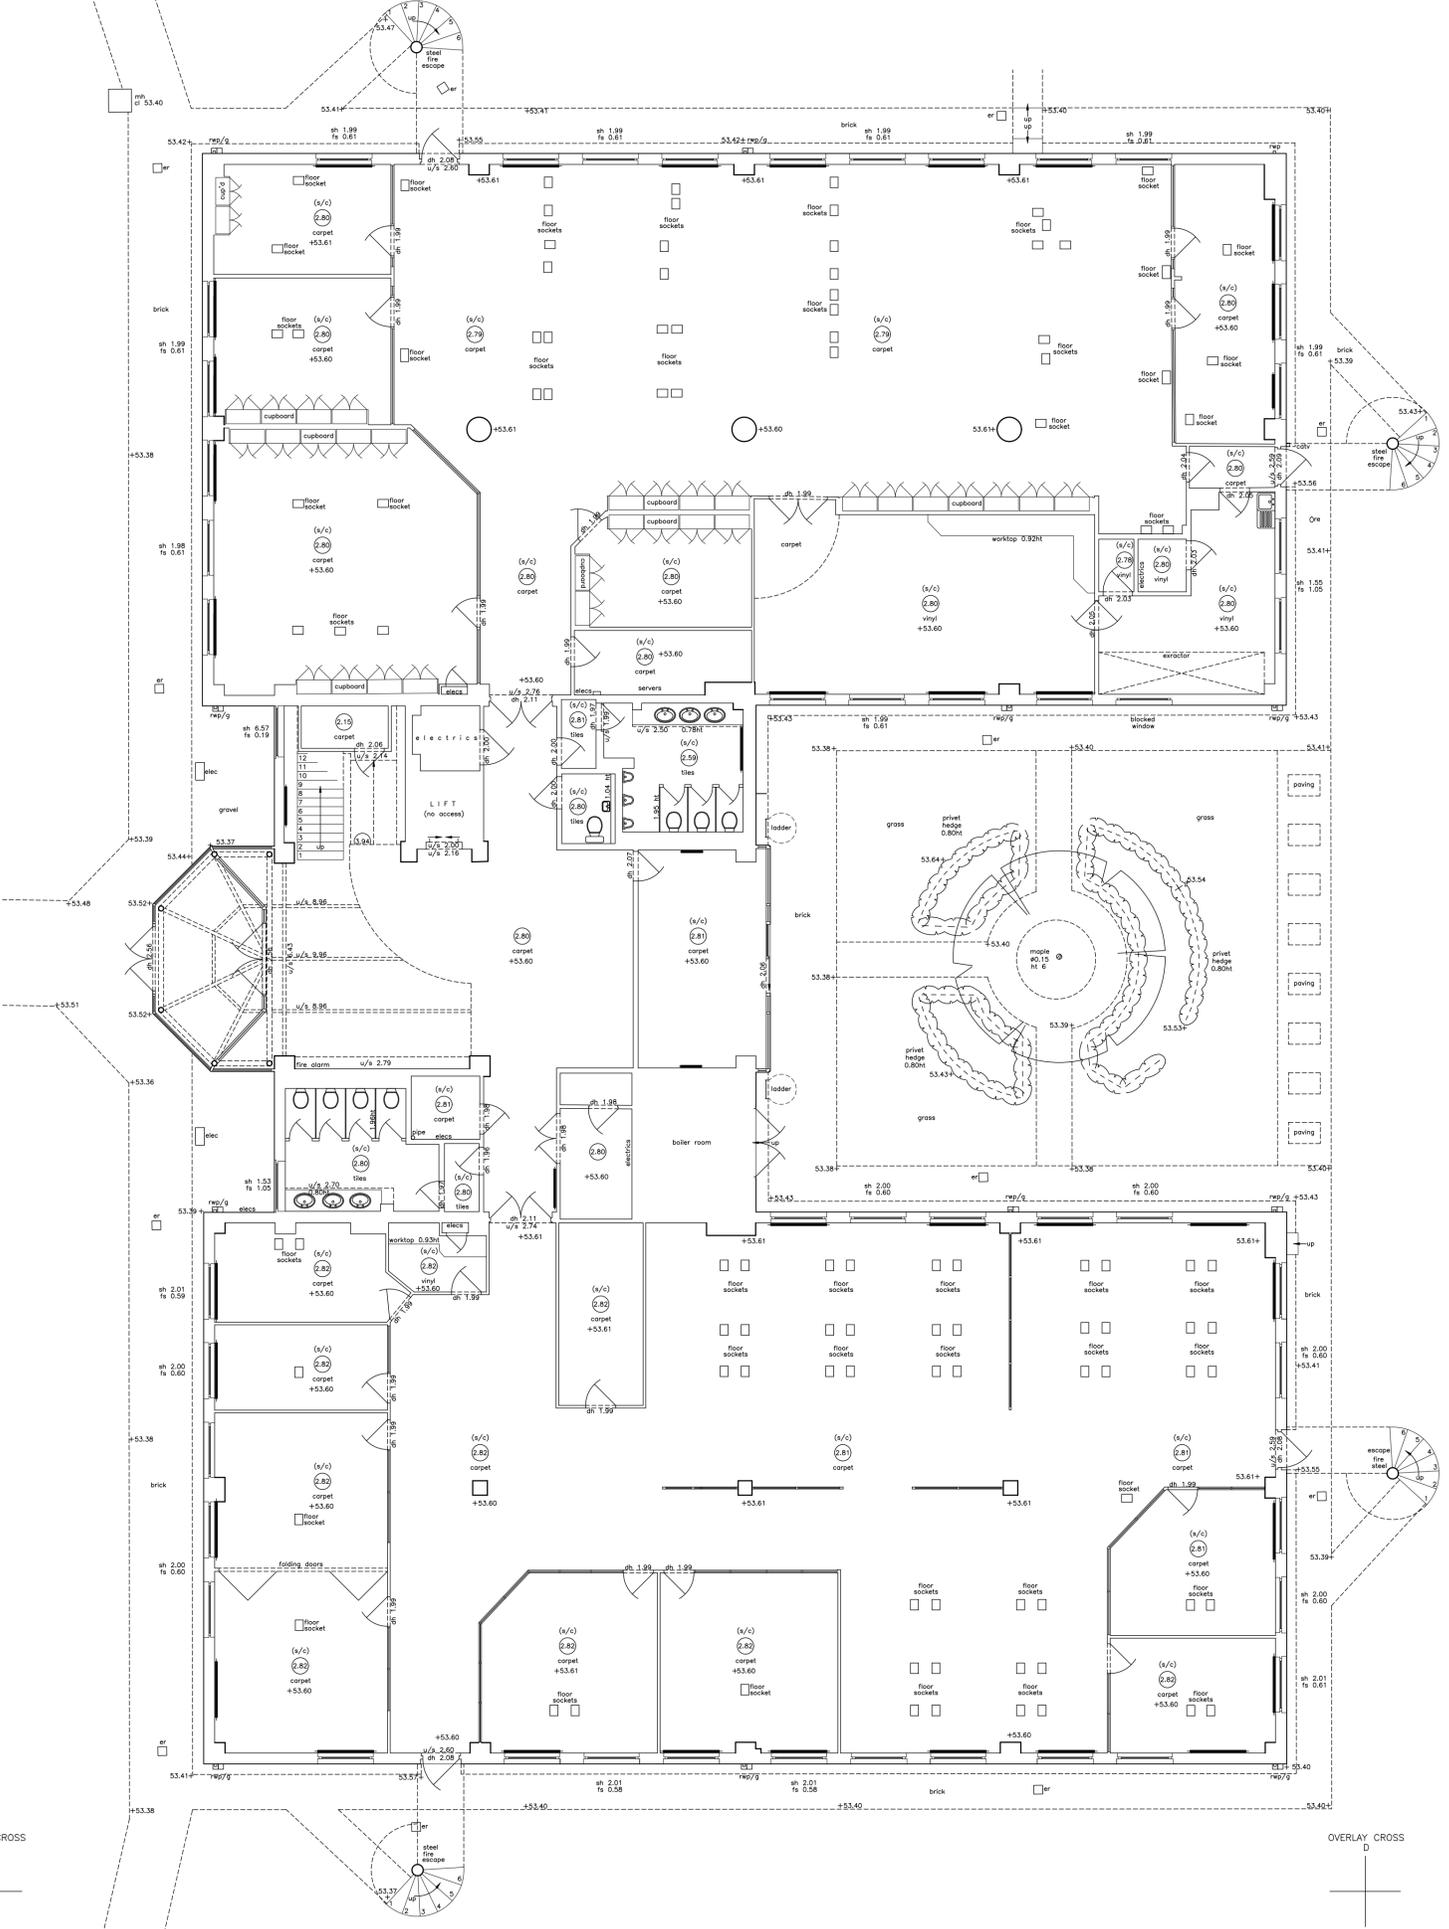

GROUND FLOOR PLAN

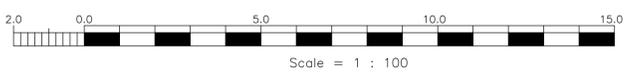

Scale = 1 : 100

RW/RRJ © ON CENTRE SURVEYS LTD. 2025	
job SETON HOUSE WARWICK TECHNOLOGY PARK GALLOWES HILL WARWICK CV34 4DA	
client WAREING & COMPANY on behalf of SCHROEDERS	
title GROUND FLOOR PLAN	dwg no. 24052B-1
scale 1/100	date NOVEMBER 2025
 ON-CENTRE SURVEYS LTD. LAND & BUILDING SURVEYORS GEODETIC ENGINEERS 2 CHARLES COURT, BUDBROOKE ROAD, WARWICK CV34 5LZ TEL: 01925 494294 E-MAIL: info@oncentre.co.uk A member of The Survey Association	