


THIRD FLOOR
1 : 100

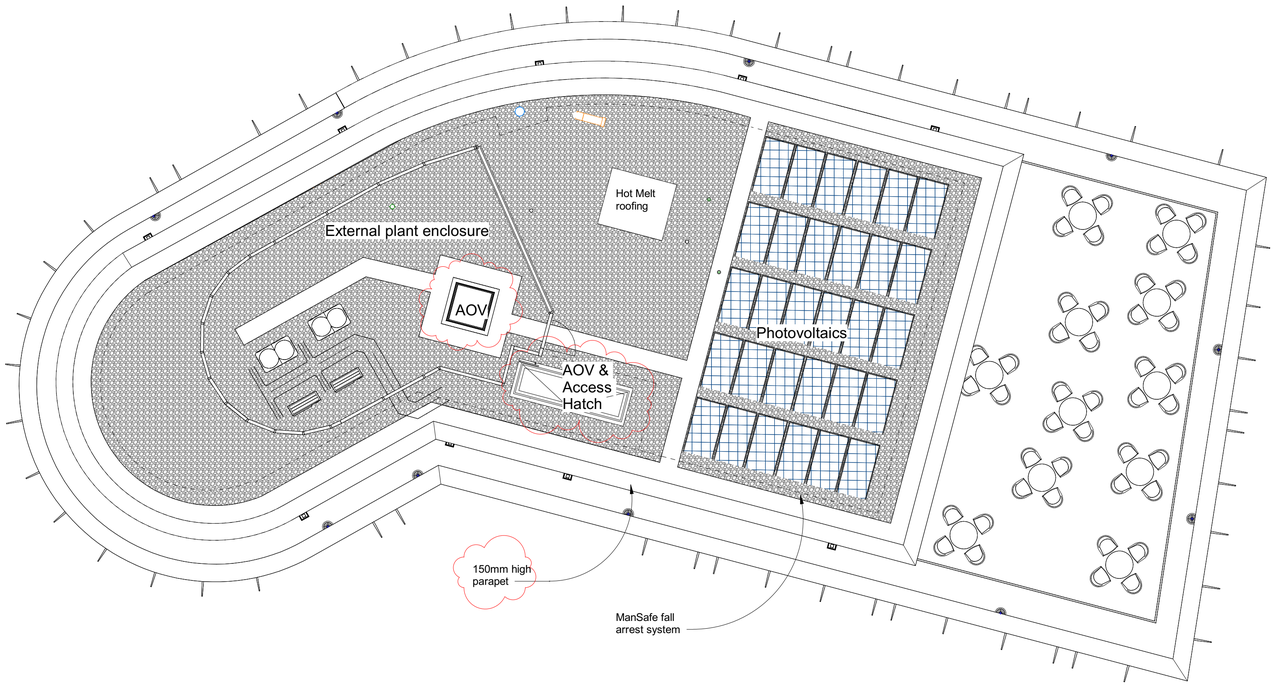

FOURTH FLOOR
1 : 100

• This drawing must not be scaled. All site dimensions must be physically checked on site prior to construction and fabrication.
• This drawing must not be reproduced without full written consent of ONE Creative environments.

REV	DESCRIPTION	DATE	BY
P07	S3 - UPDATED STAGE 4 ISSUE	18.09.24	MS
P06	PLANNING ISSUE - FINS AMENDMENT S3	14.08.24	DS
P05	PLANNING ISSUE - AMENDMENT S3	24.06.24	DS
P04	STAIRCASE AMENDMENT	12.06.24	DS
P03	VE DRAWING REVISION	10.06.24	DS
P02	REVISION TO SUIT CLIENT COMMENTS, DRAWING NAMING CONVENTION UPDATED TO SUIT CONTRACTOR'S EIR	28.05.24	DS
P01	FIRST ISSUE	28.03.24	DS

DESIGNER

ONE Creative environments

Worcester 01905 362 300 | Birmingham 0121 312 3876 | London 0208 059 6526 | Cardiff 029 20027983

oneltd.com

CLIENT

KIER

PROJECT NUMBER
P1479

PROJECT TITLE
FORMER MARKET HALL, BROMSGROVE

DRAWN BY :	POSITION :	DATE
JT	ARCHITECT	12/08/2024
CHECKED BY: Becki Smith	POSITION: Associate Architect	DATE: 19/09/2024
APPROVED FOR ISSUE BY: Becki Smith	POSITION: Associate Architect	DATE: 19/09/2024

North

DRAWING TITLE
OFFICE BUILDING
FLOOR PLANS
THIRD AND FOURTH FLOOR

DRAWING STATUS
S3 - SUITABLE FOR REVIEW AND COMMENT

SCALE 1 : 100
DRAWING SIZE A1

0m 2m 4m 6m 8m 10m
SCALE 1:100

DRAWING NUMBER
FMH-ONE-OF-XX- D-A-0021

REVISION
P07

© Copyright of ONE Creative environments. No reproduction without written consent from ONE Creative environments.