




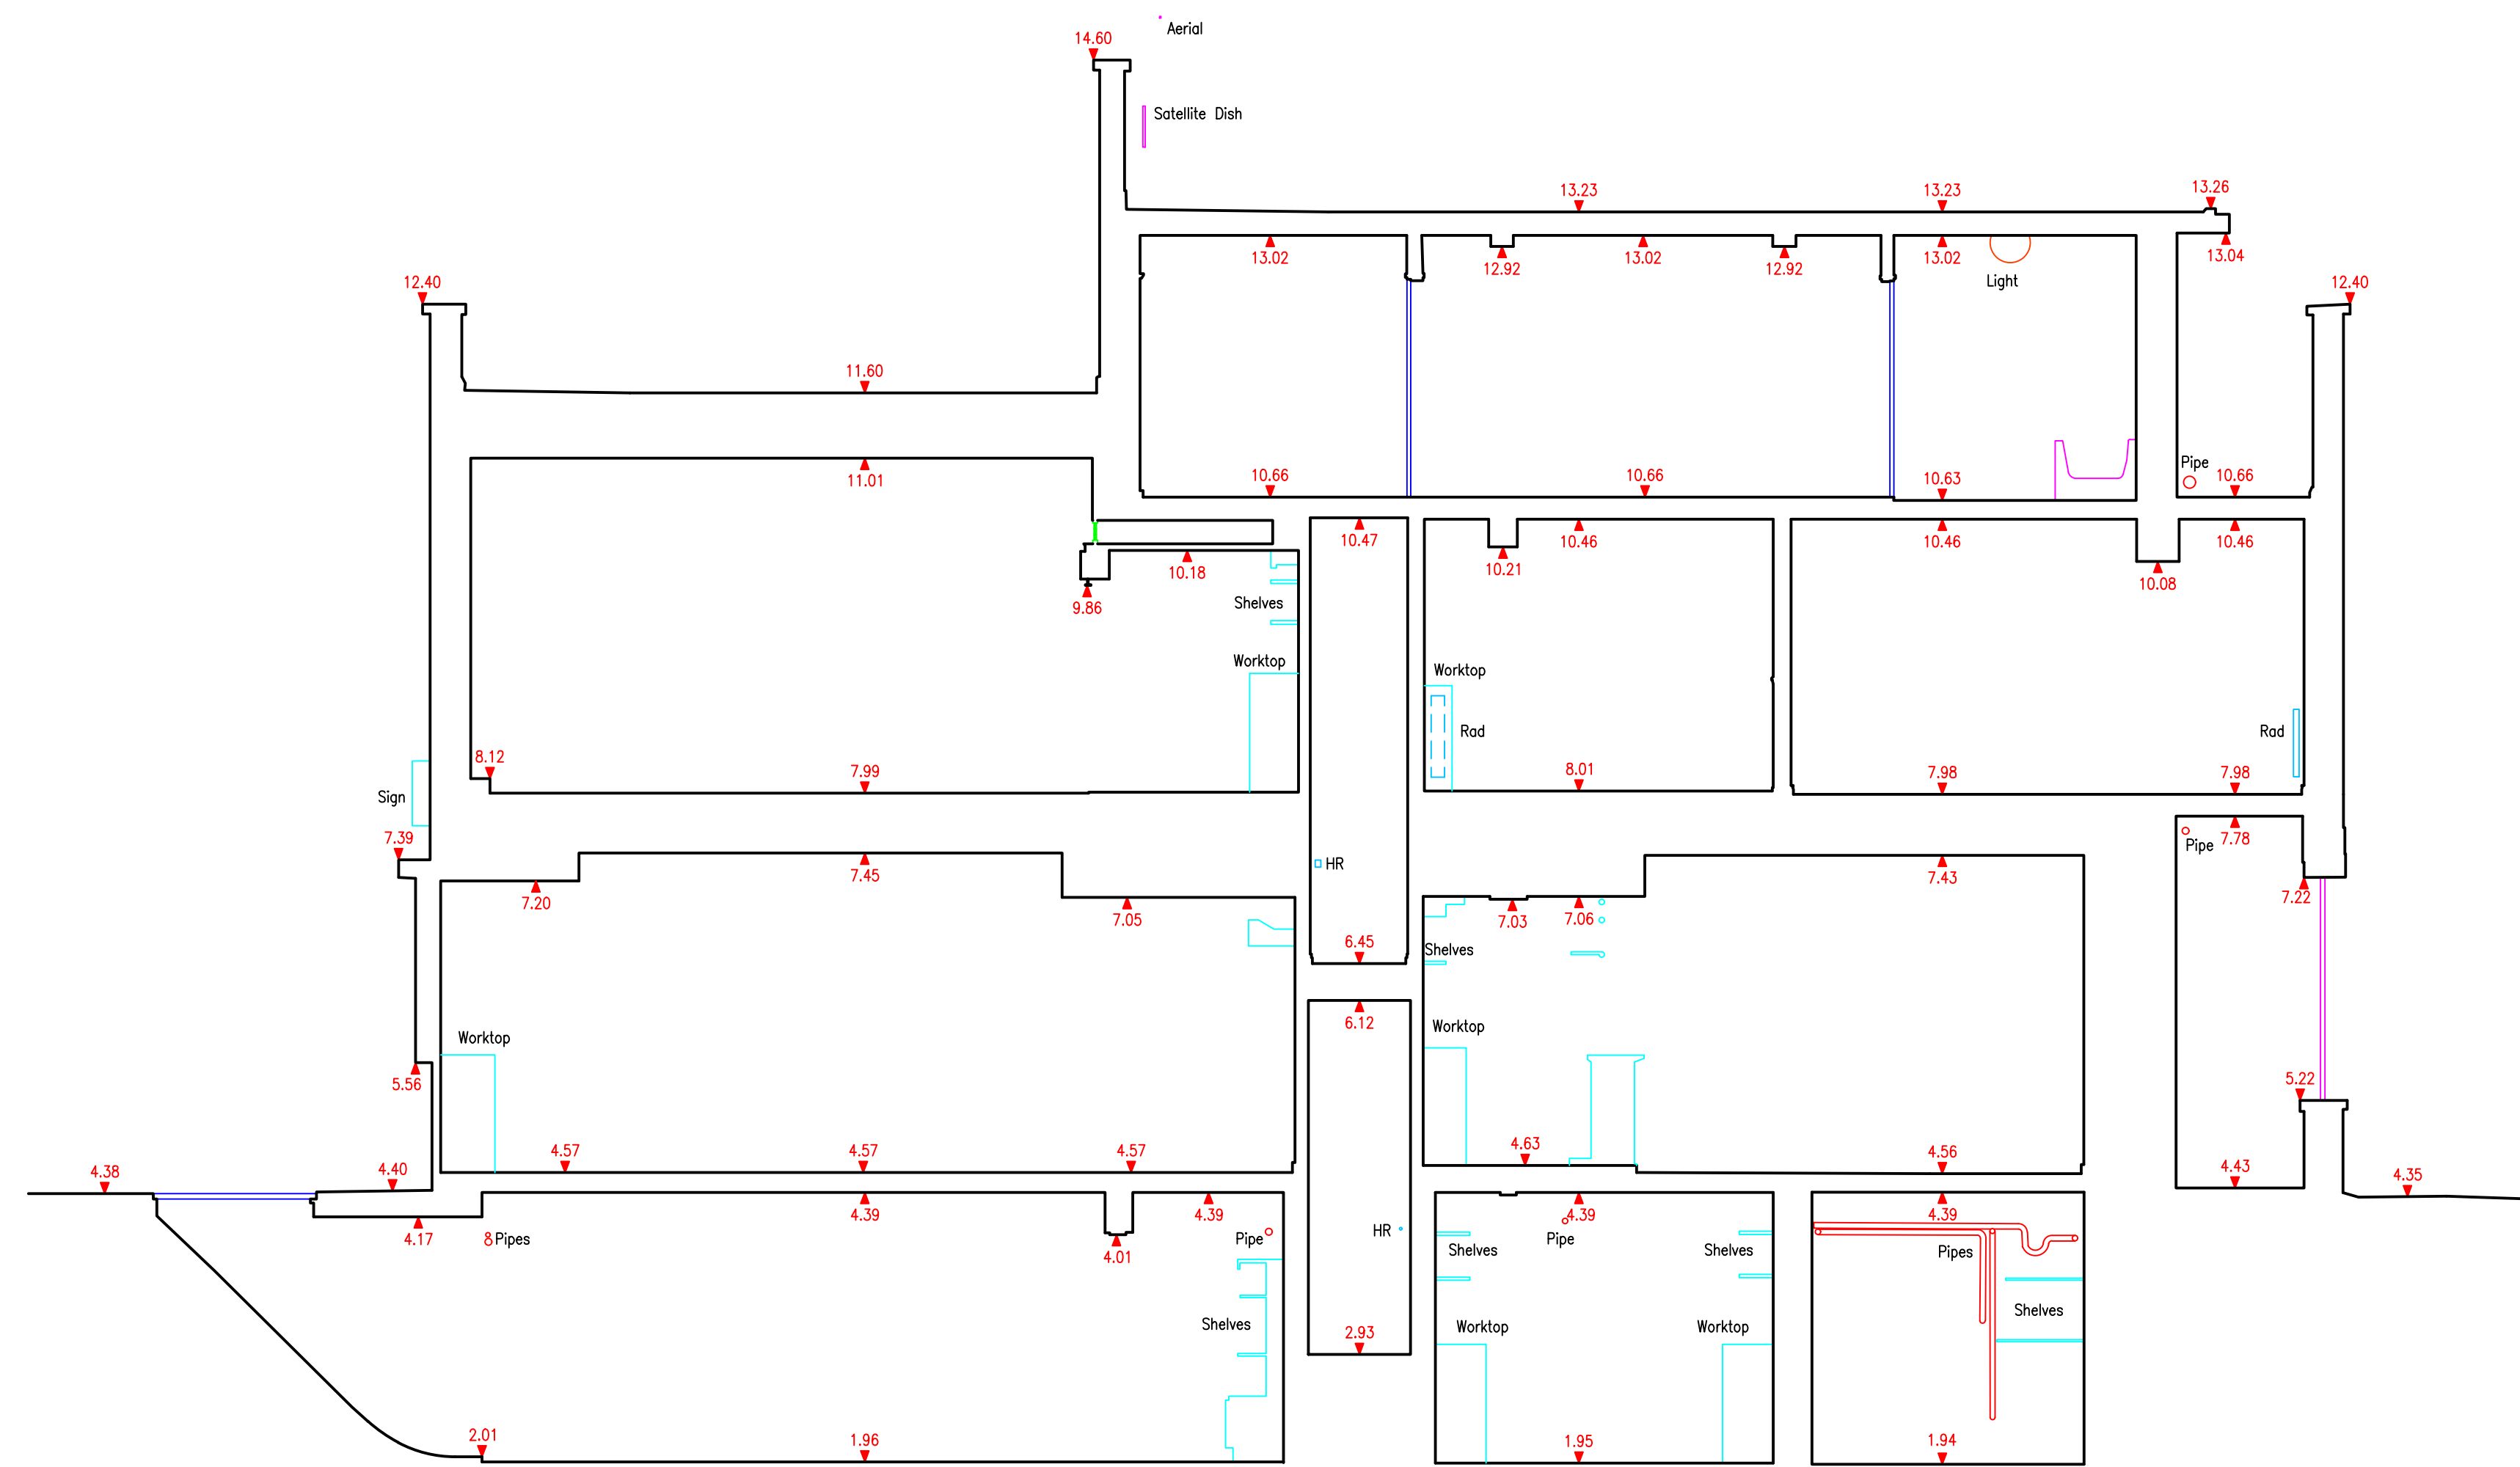


SECTION 1

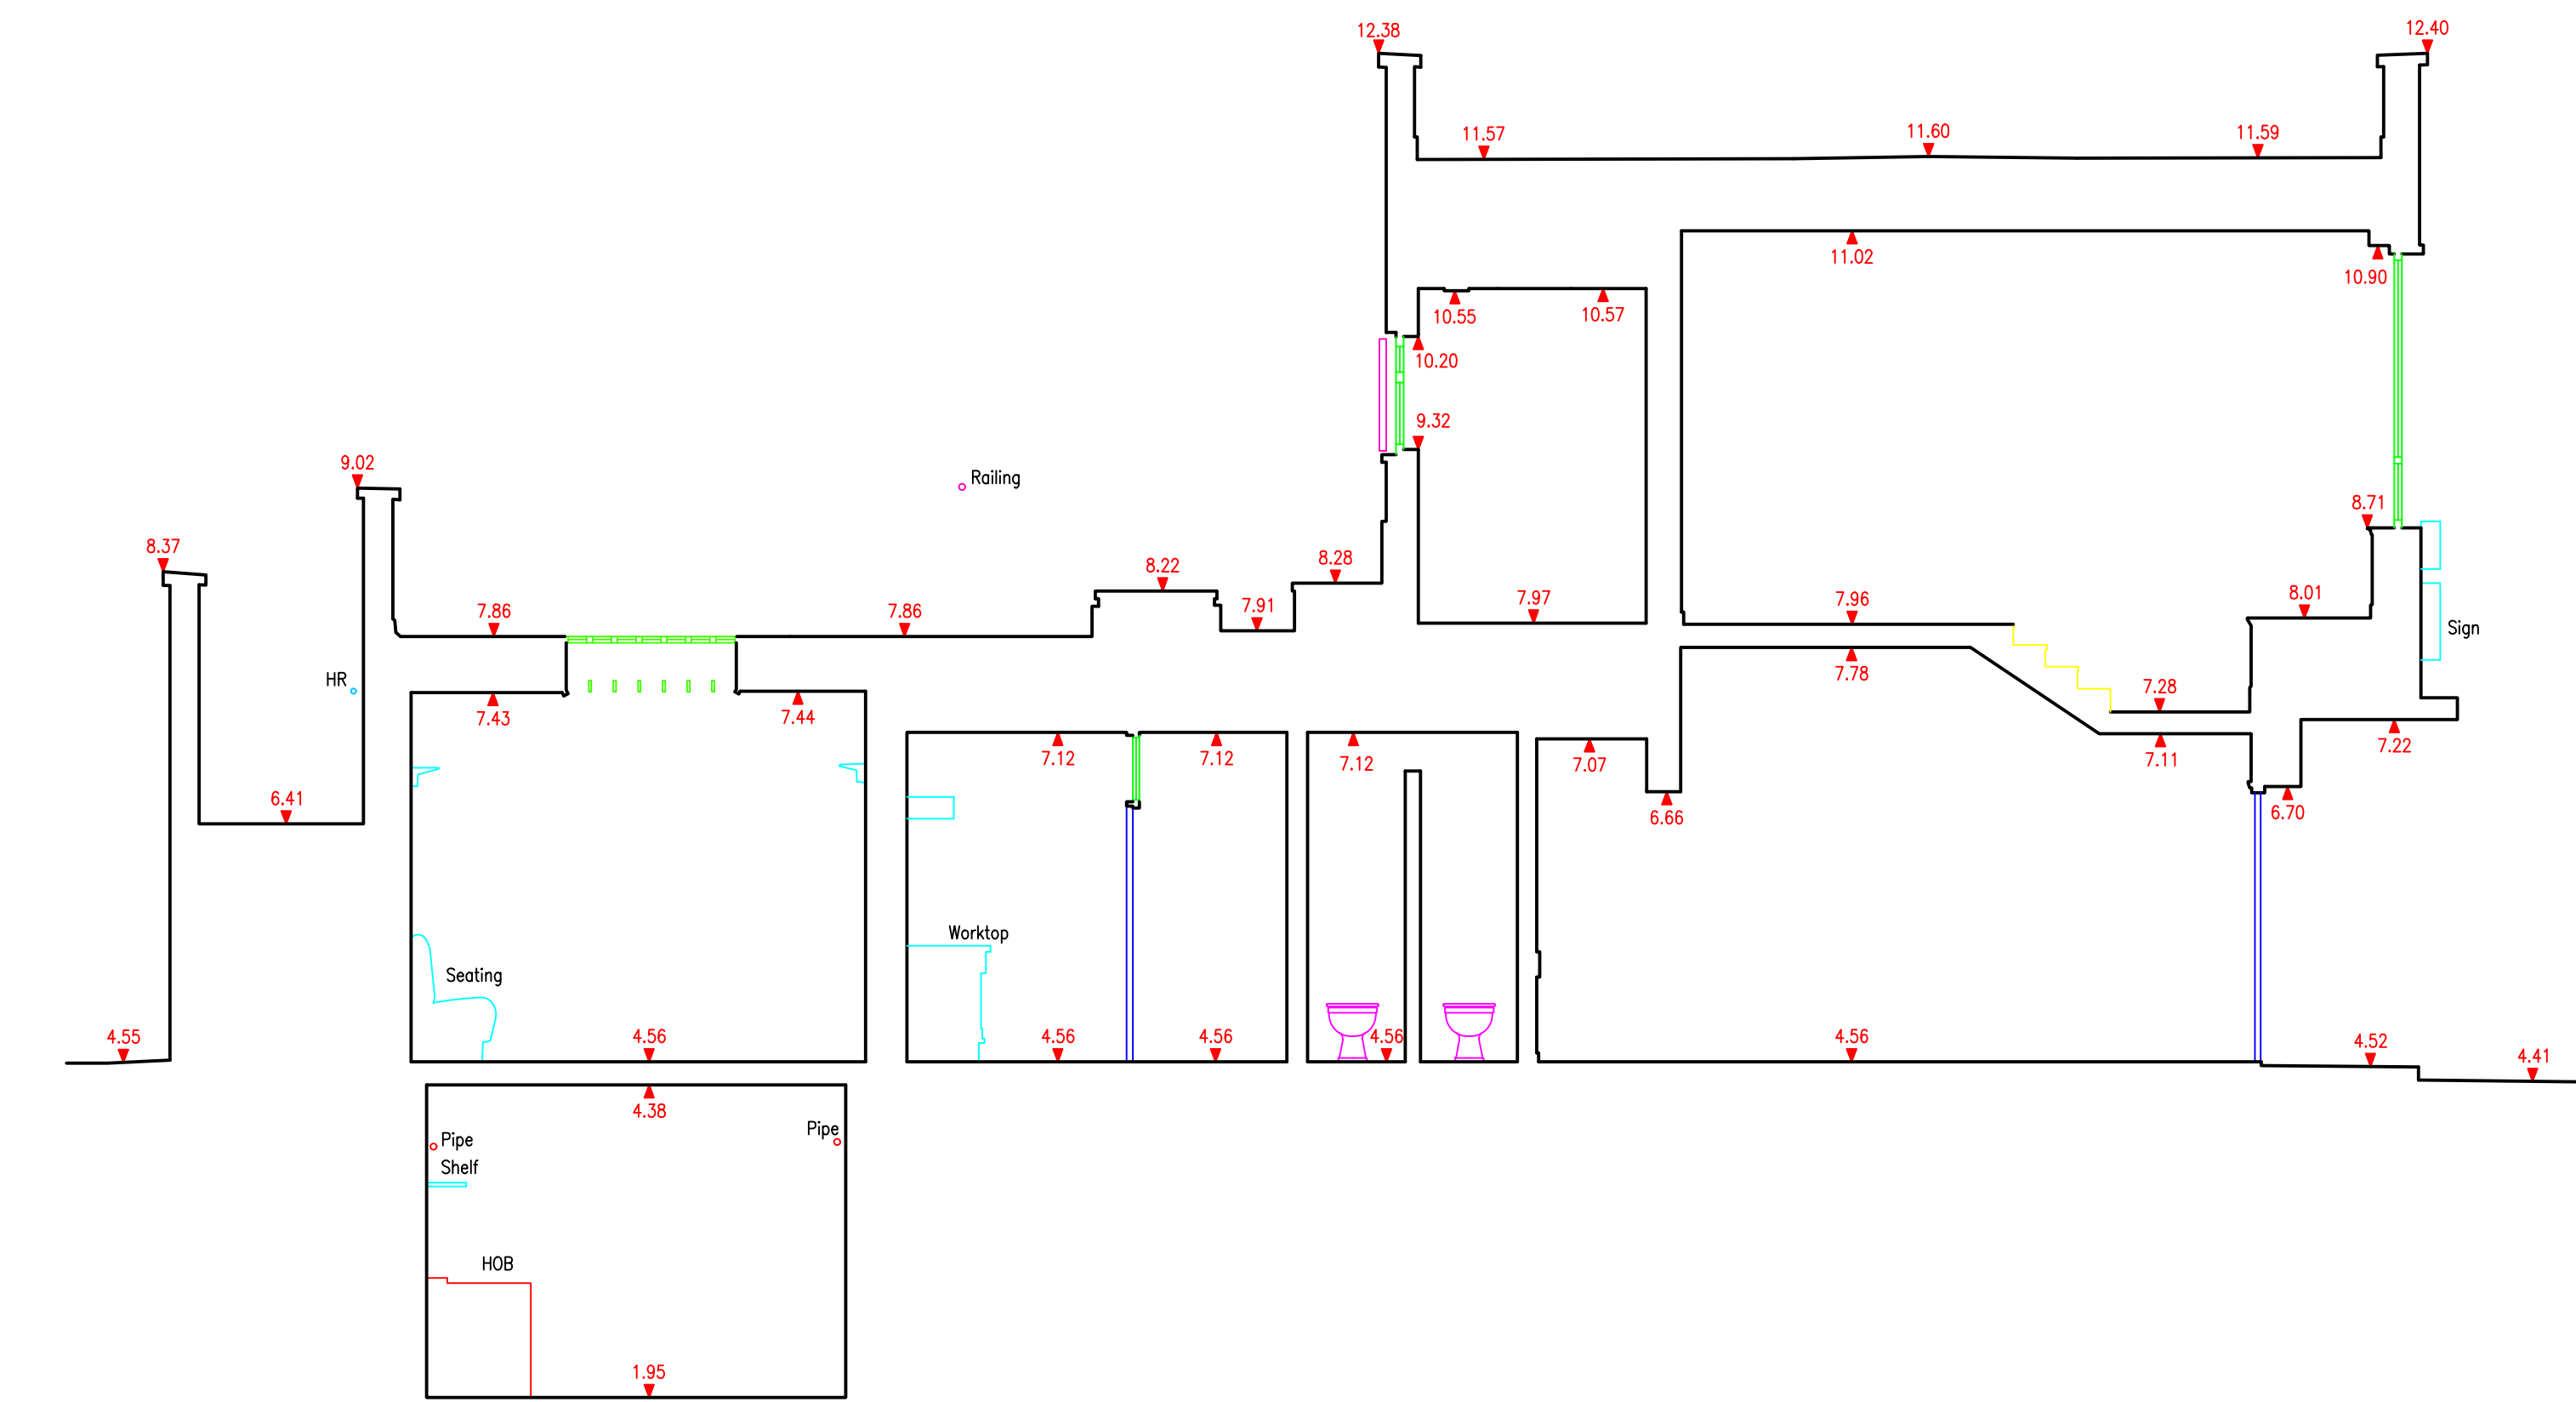

SECTION 2

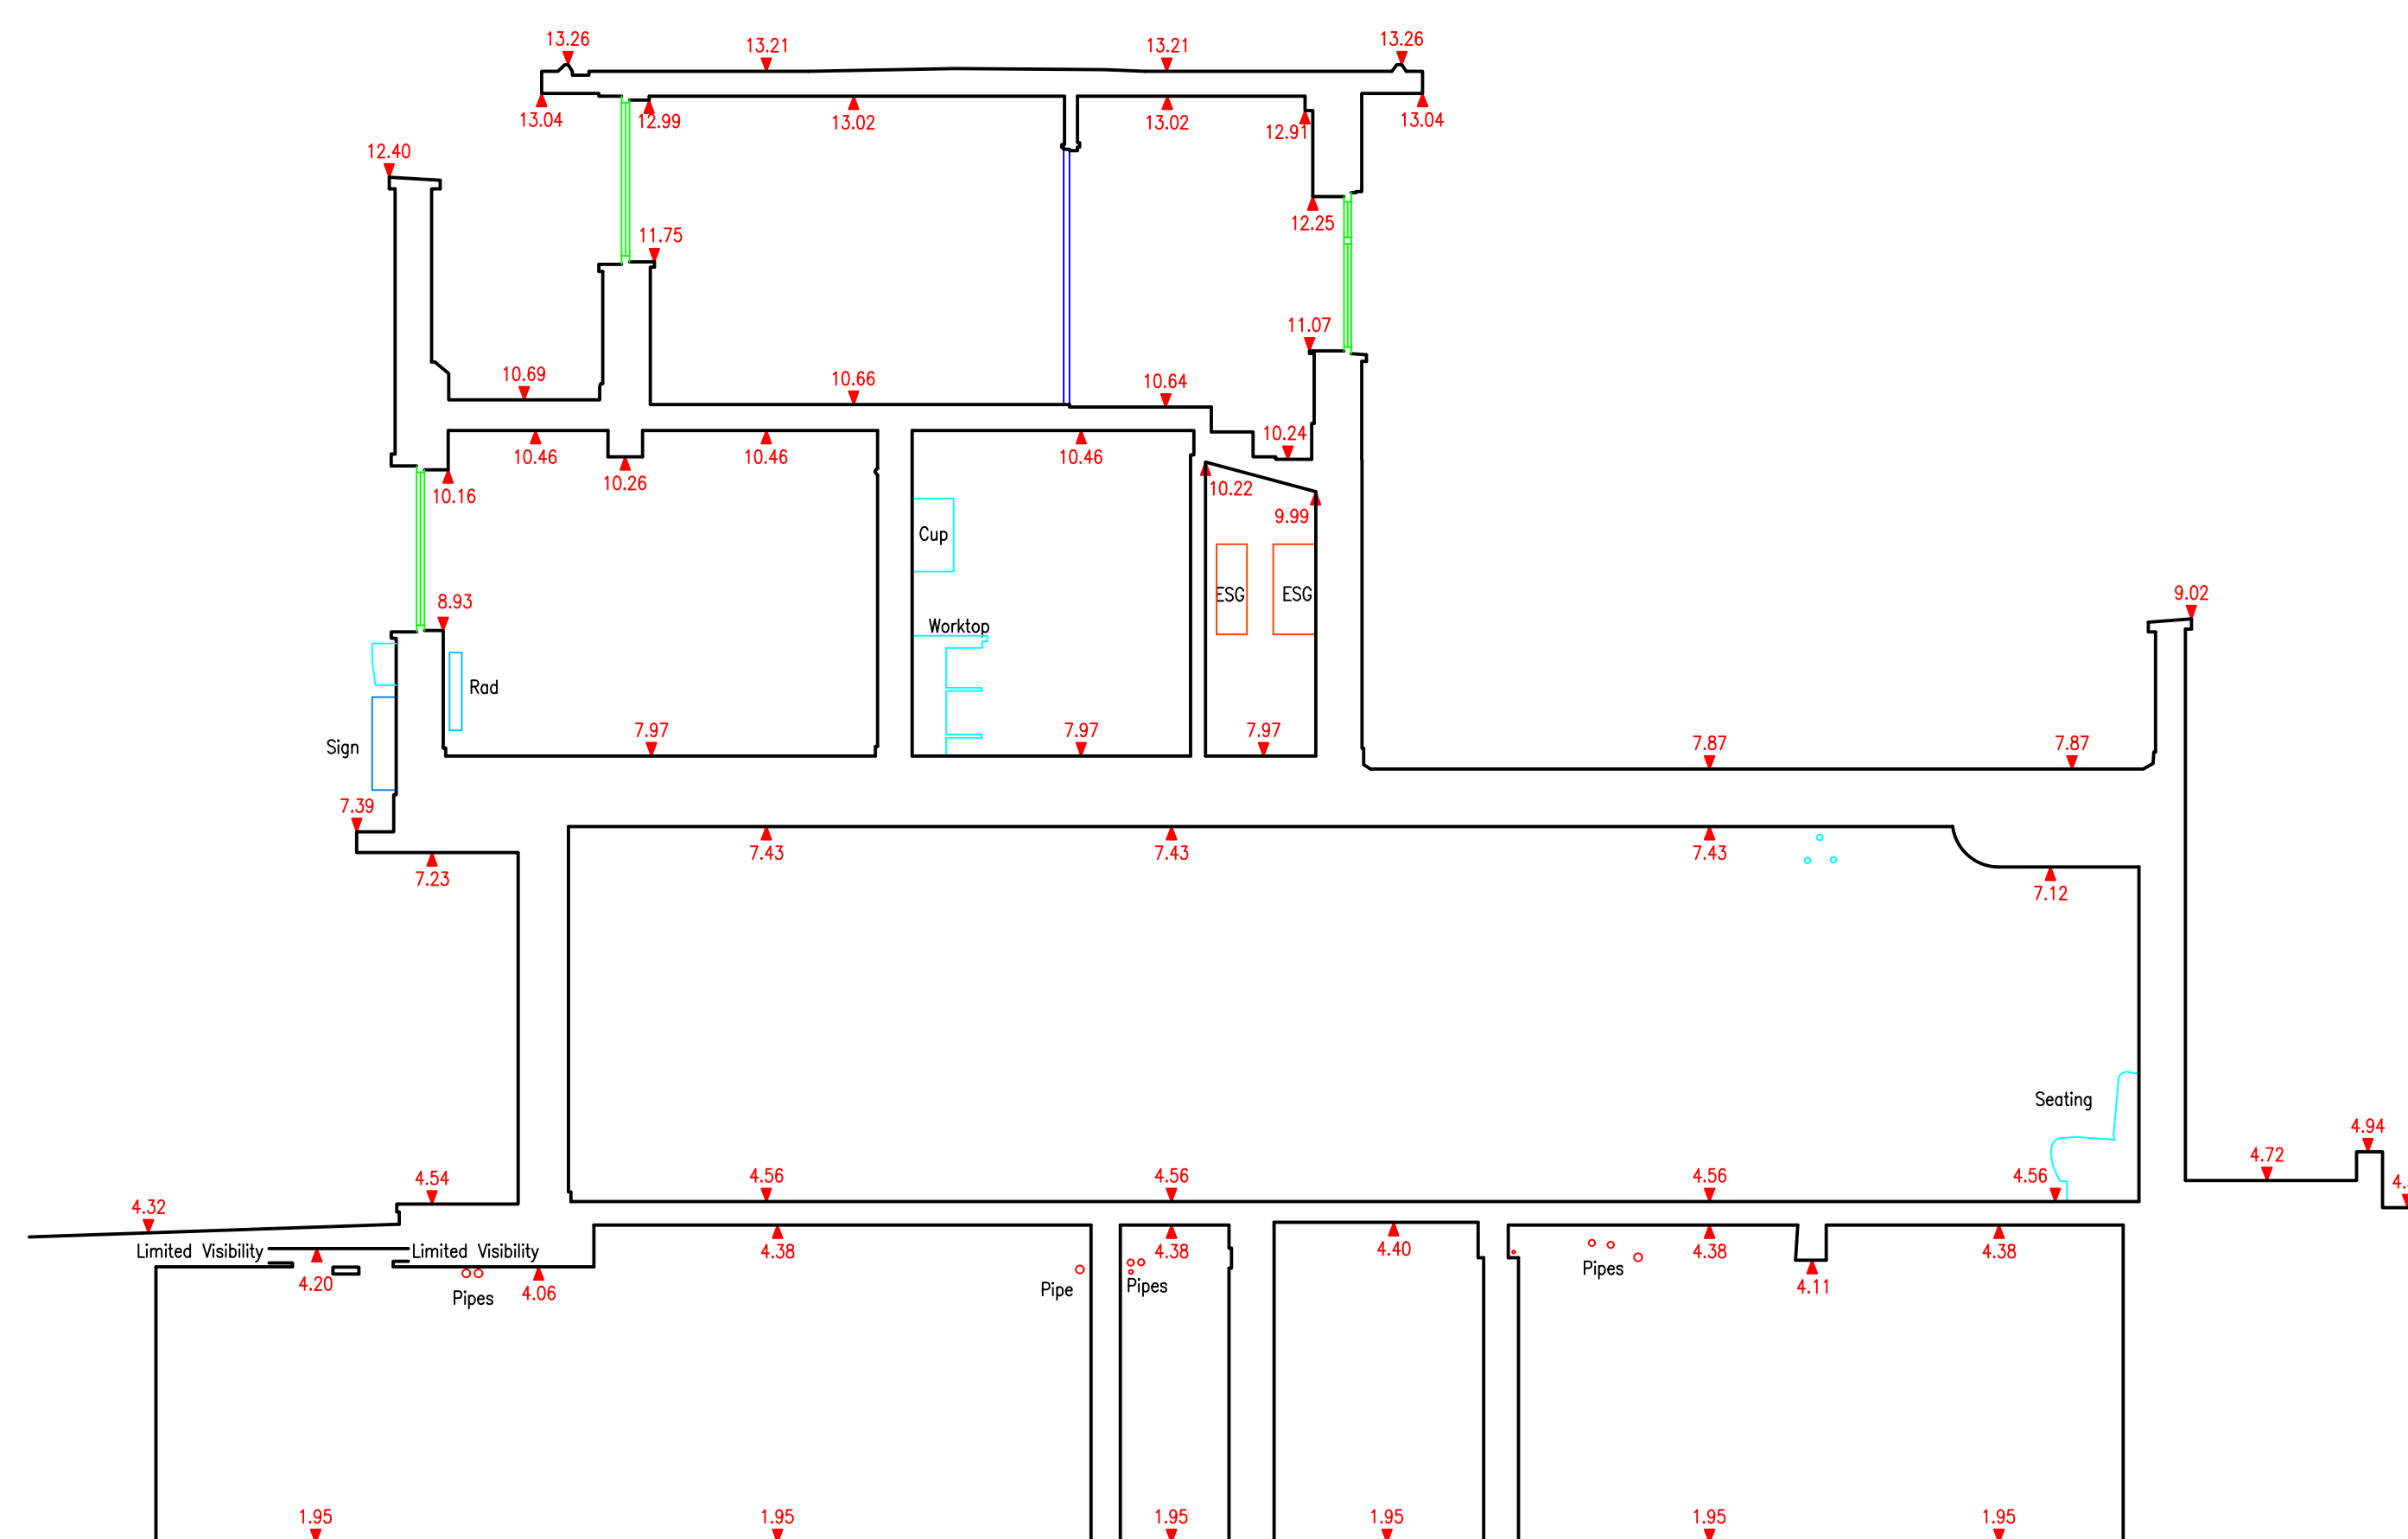

SECTION 3

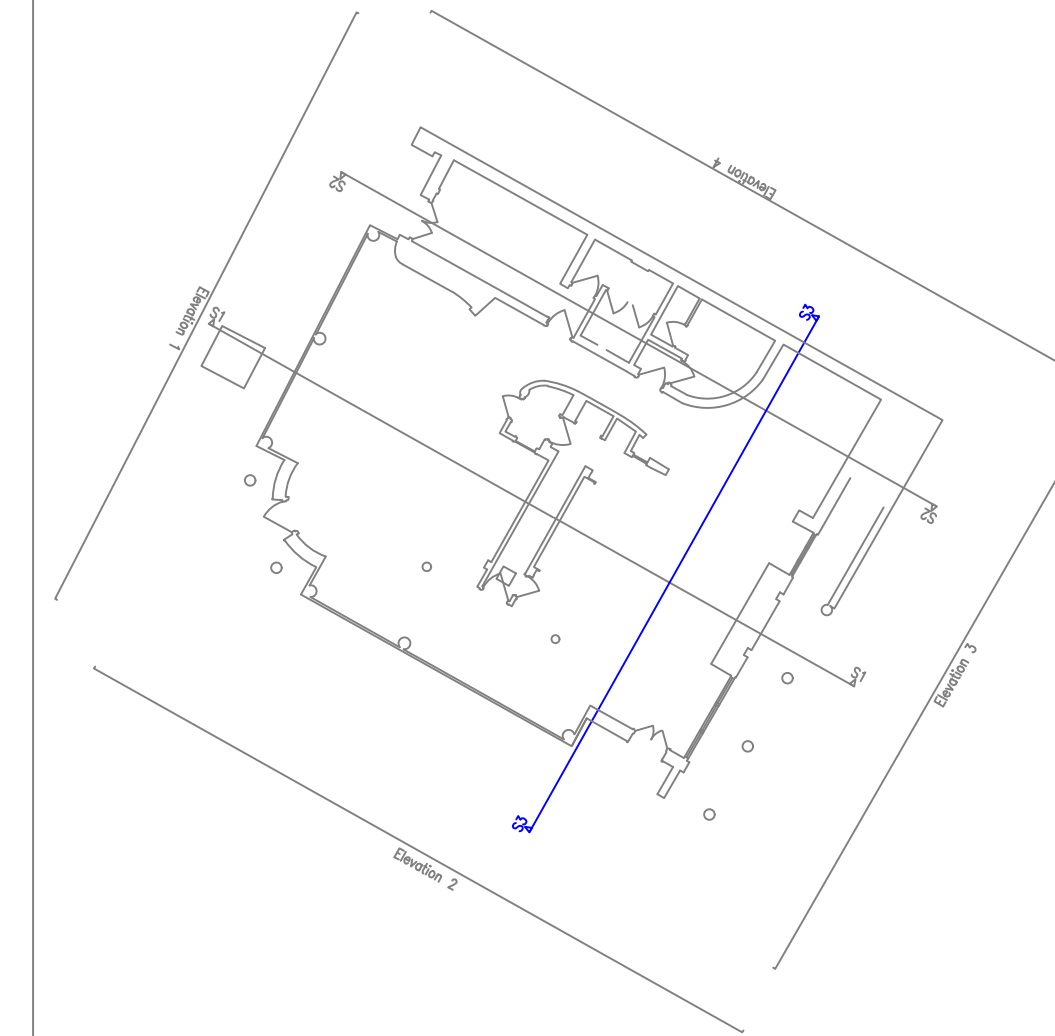[illegible][illegible]

MESS SYMBOLS			
	Ceiling Level		Ceiling Height
	False Ceiling Level		False Ceiling Height
	Beam Soffit Level		Beam Soffit Height
	Stair Level		Stair Height
	Head Level		Head Height
	Min Ceiling Sloping Level		Min Ceiling Sloping Height
	Max Ceiling Sloping Level		Max Ceiling Sloping Height
	Arch Levels		Arch Heights
	Door Level		Door Height
	Spot Level		Feature Height
	Spot Level Elevation		Room Floor
	Stair/Step Arrows		Point Down
	Point Up		Stair/Step Arrows
	Sloping Ceiling		Assumed Position
	Point Up		



Project	
47-49 Dorset Road London SW8 1EX	
Description	
Sections	
Survey Date	Drawing Date
14/07/2025	05/08/2025
Sheet	Scale
A0	1:50
Drawing No.	
3753-SP-ZZ-M2-01	
Checked	Revision
PS	P01