


36 Langlands Court, East Kilbride
 CM/LL 18/3/26

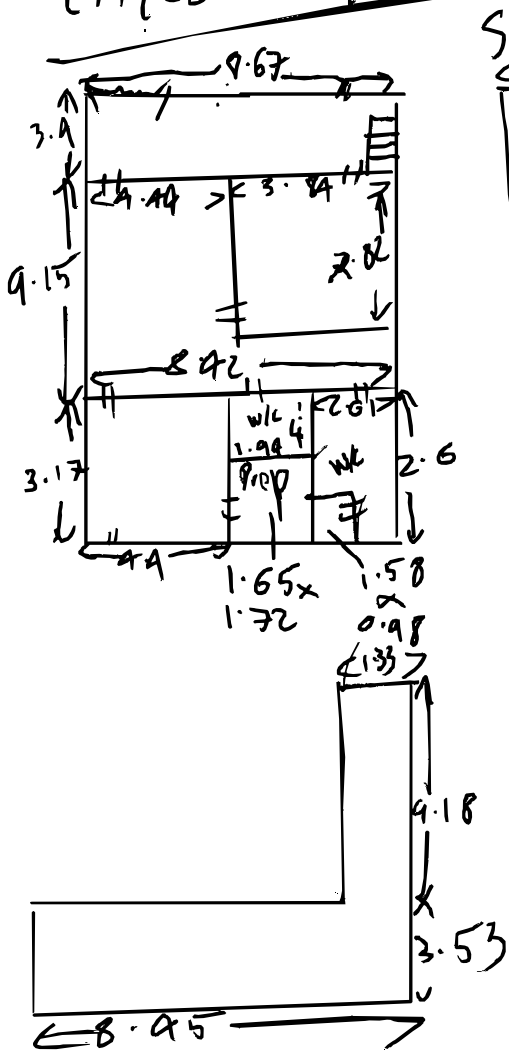

5.86m Eaves

Electric Heating
 3 Phase
 Code Alarm on site
 Communal Yard Rear