


GROUND FLOOR PLAN

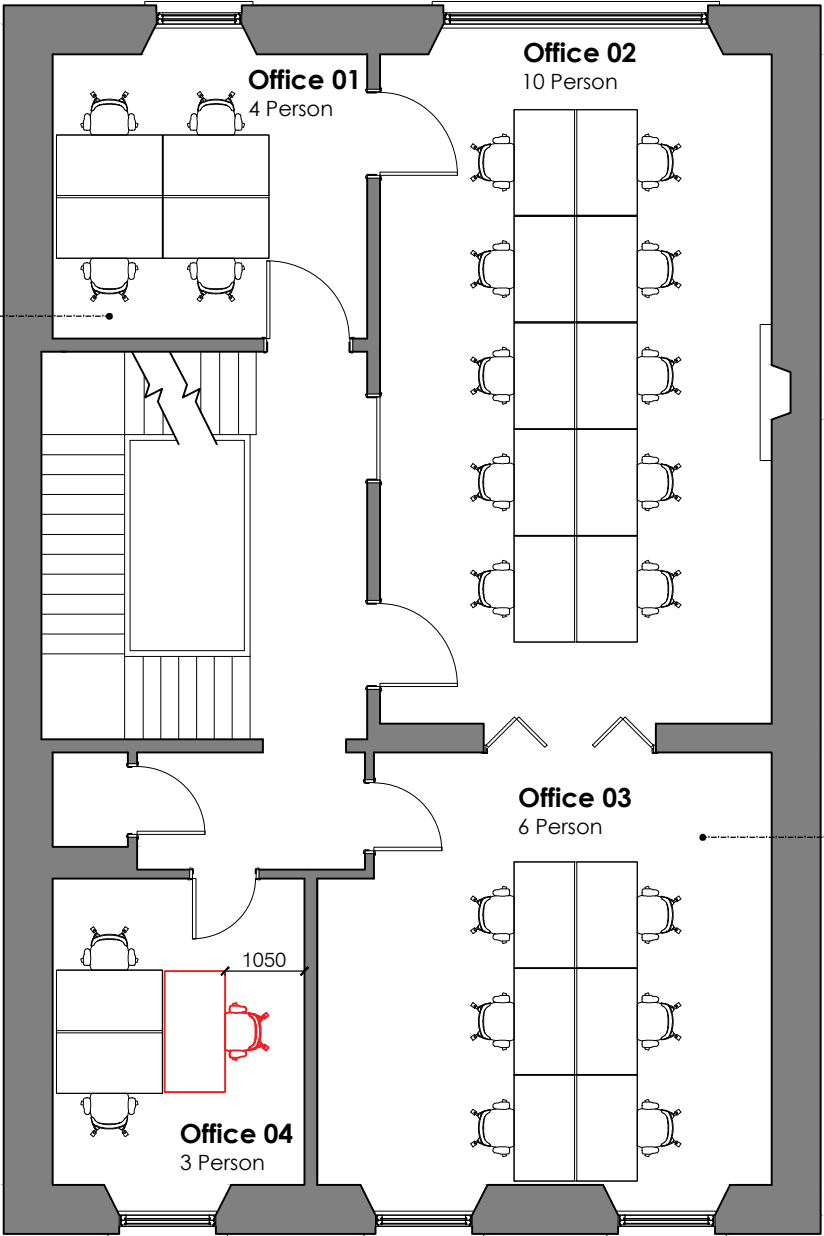

FIRST FLOOR PLAN OPTION 2

18 No. 1400 x 800mm Workstations

<div><div>ois</div><div>office interiors scotland</div><div><div>Bute House</div><div>Arran Road</div><div>Perth</div><div>PH1 3DZ</div><div>Telephone: +44 (0)844 887 1408</div><div>email: info@danscot.co.uk</div><div>www.danscot.co.uk</div></div></div>	Client FMG Devs Ltd		Drawing Proposed Ground & First Floor Space Plan		Revisions 0 Date of first issue 04.07.25	
	Project FF&E		Job No. DWG No. 03		Notes Where dimensions are not given, drawings must not be scaled and the matter referred to Danscot Interiors. In the event of any dimensional conflict between Danscot Interiors Drawings, the matter must be referred to Danscot Interiors for clarification. The Contractor must also refer to any separate Danscot Interiors Specification to be read in conjunction with this drawing.	
	Scale 1:100 @A3	Date 01-07-25	Drawn MB	Checked -		