
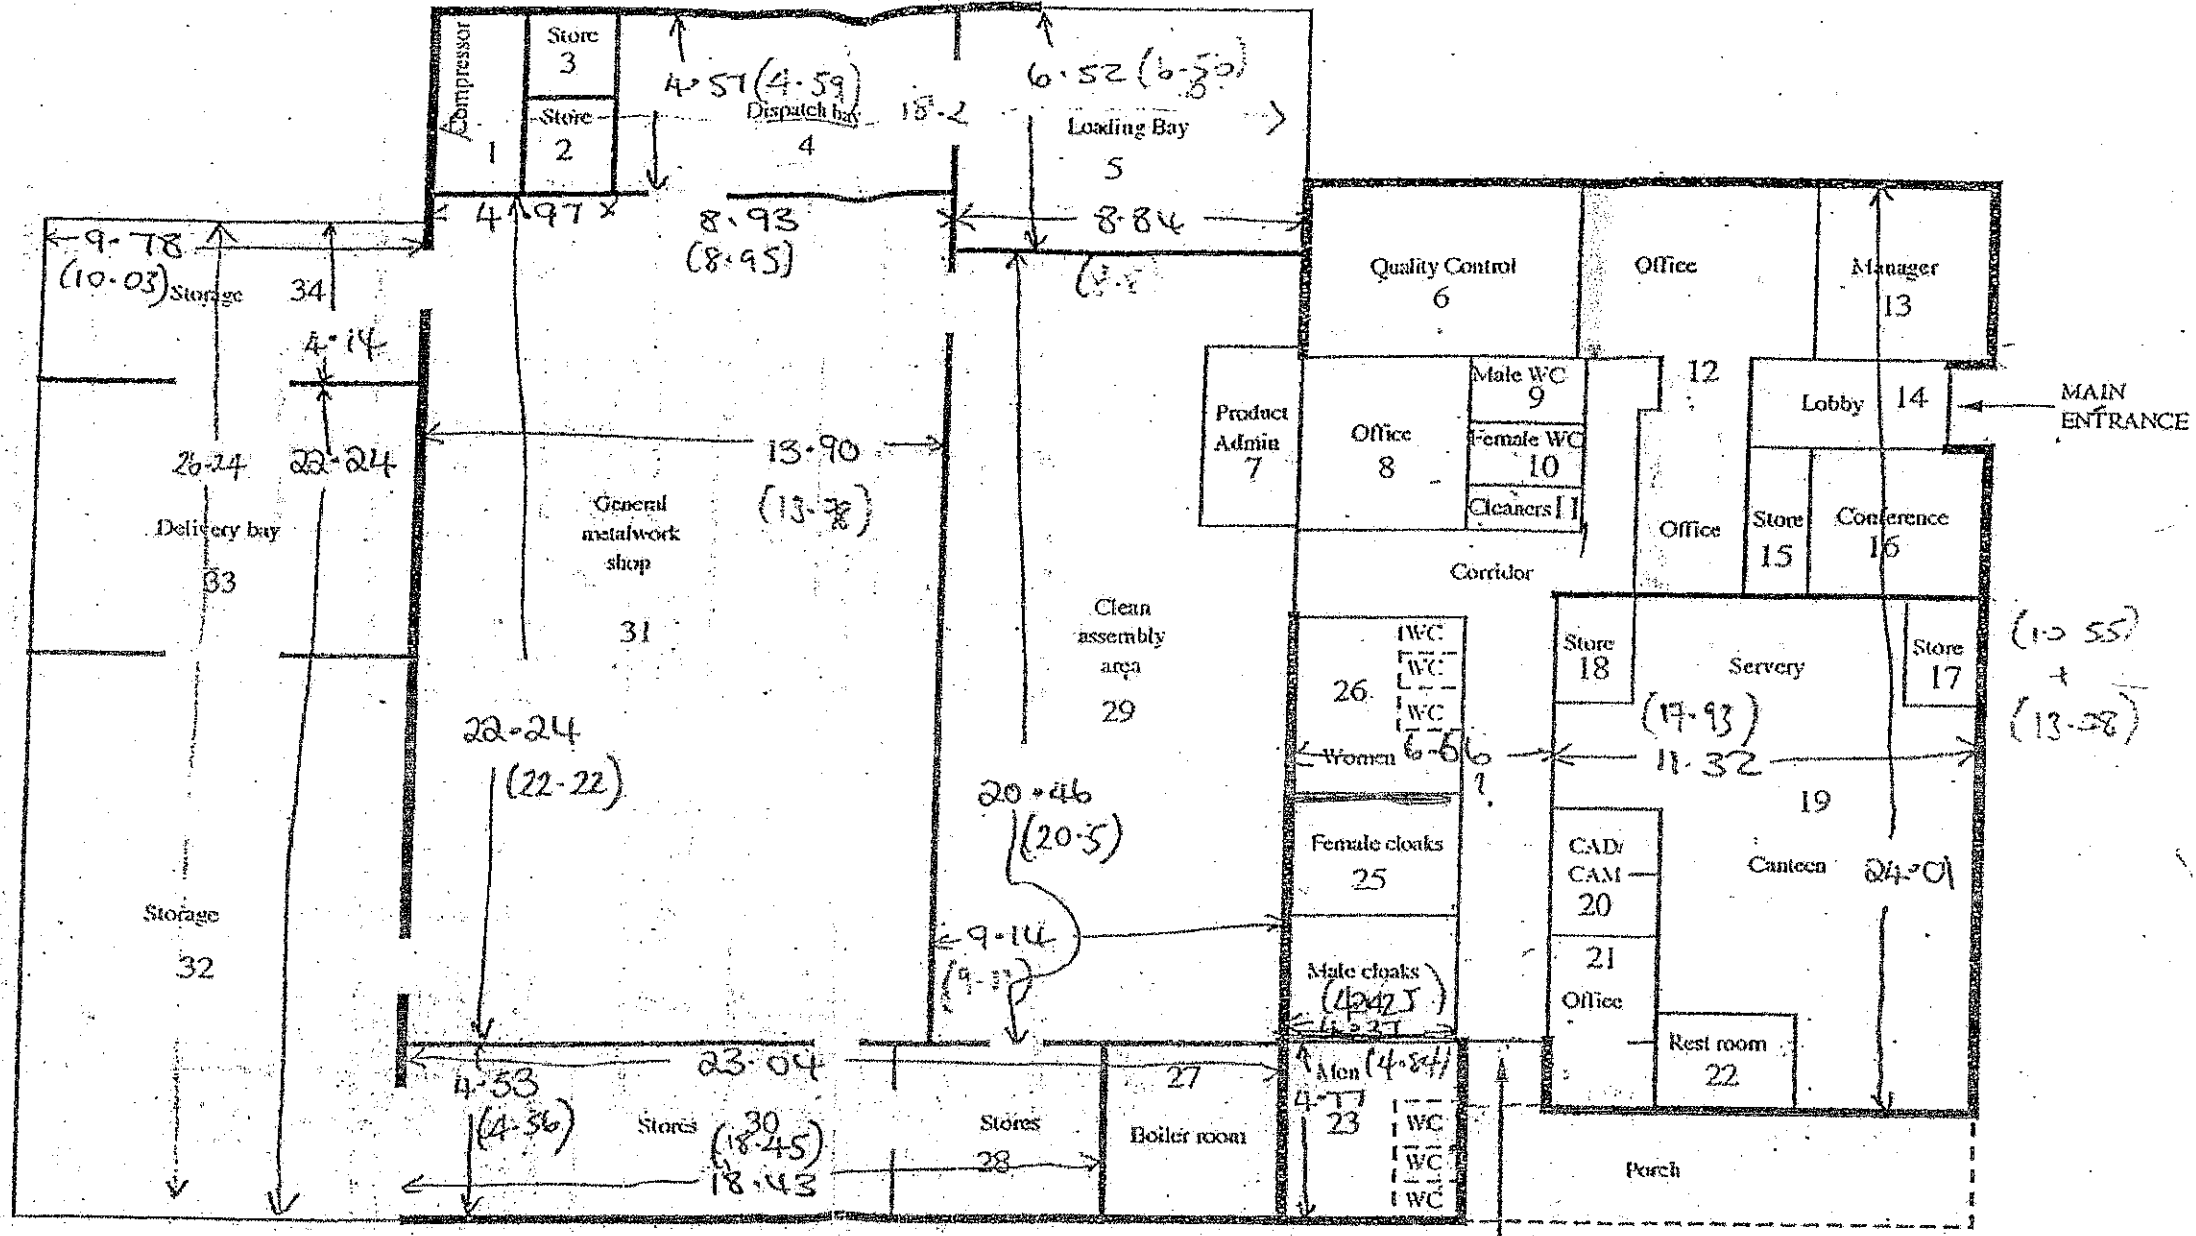


CRAK
02920 850990

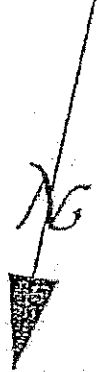

TORFAEN COUNTY BOROUGH
Bwrdeistref Sirol Torfaen

SOCIAL SERVICES

Monwel Factory, Polo Grounds
New Inn, Pontypool


Minimal floor plan

Ground floor

Total area 1475 square metres


EAVES - 5.076
APEX - 7.30

OLD RSD (ROAD facing)
W - 4.3
H - 3.815

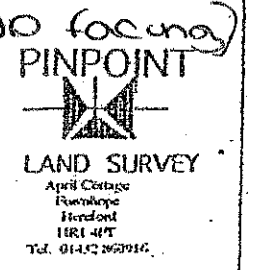

New RSD
W - 7.019
H - 5.017

Scale: 1:200
Date: September 7 1998
Drawing: PP010998/2

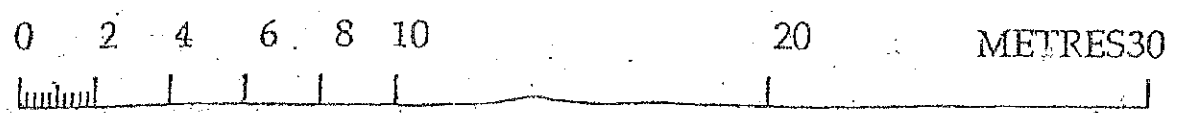

Asbestos Survey
EPC Survey Needed