



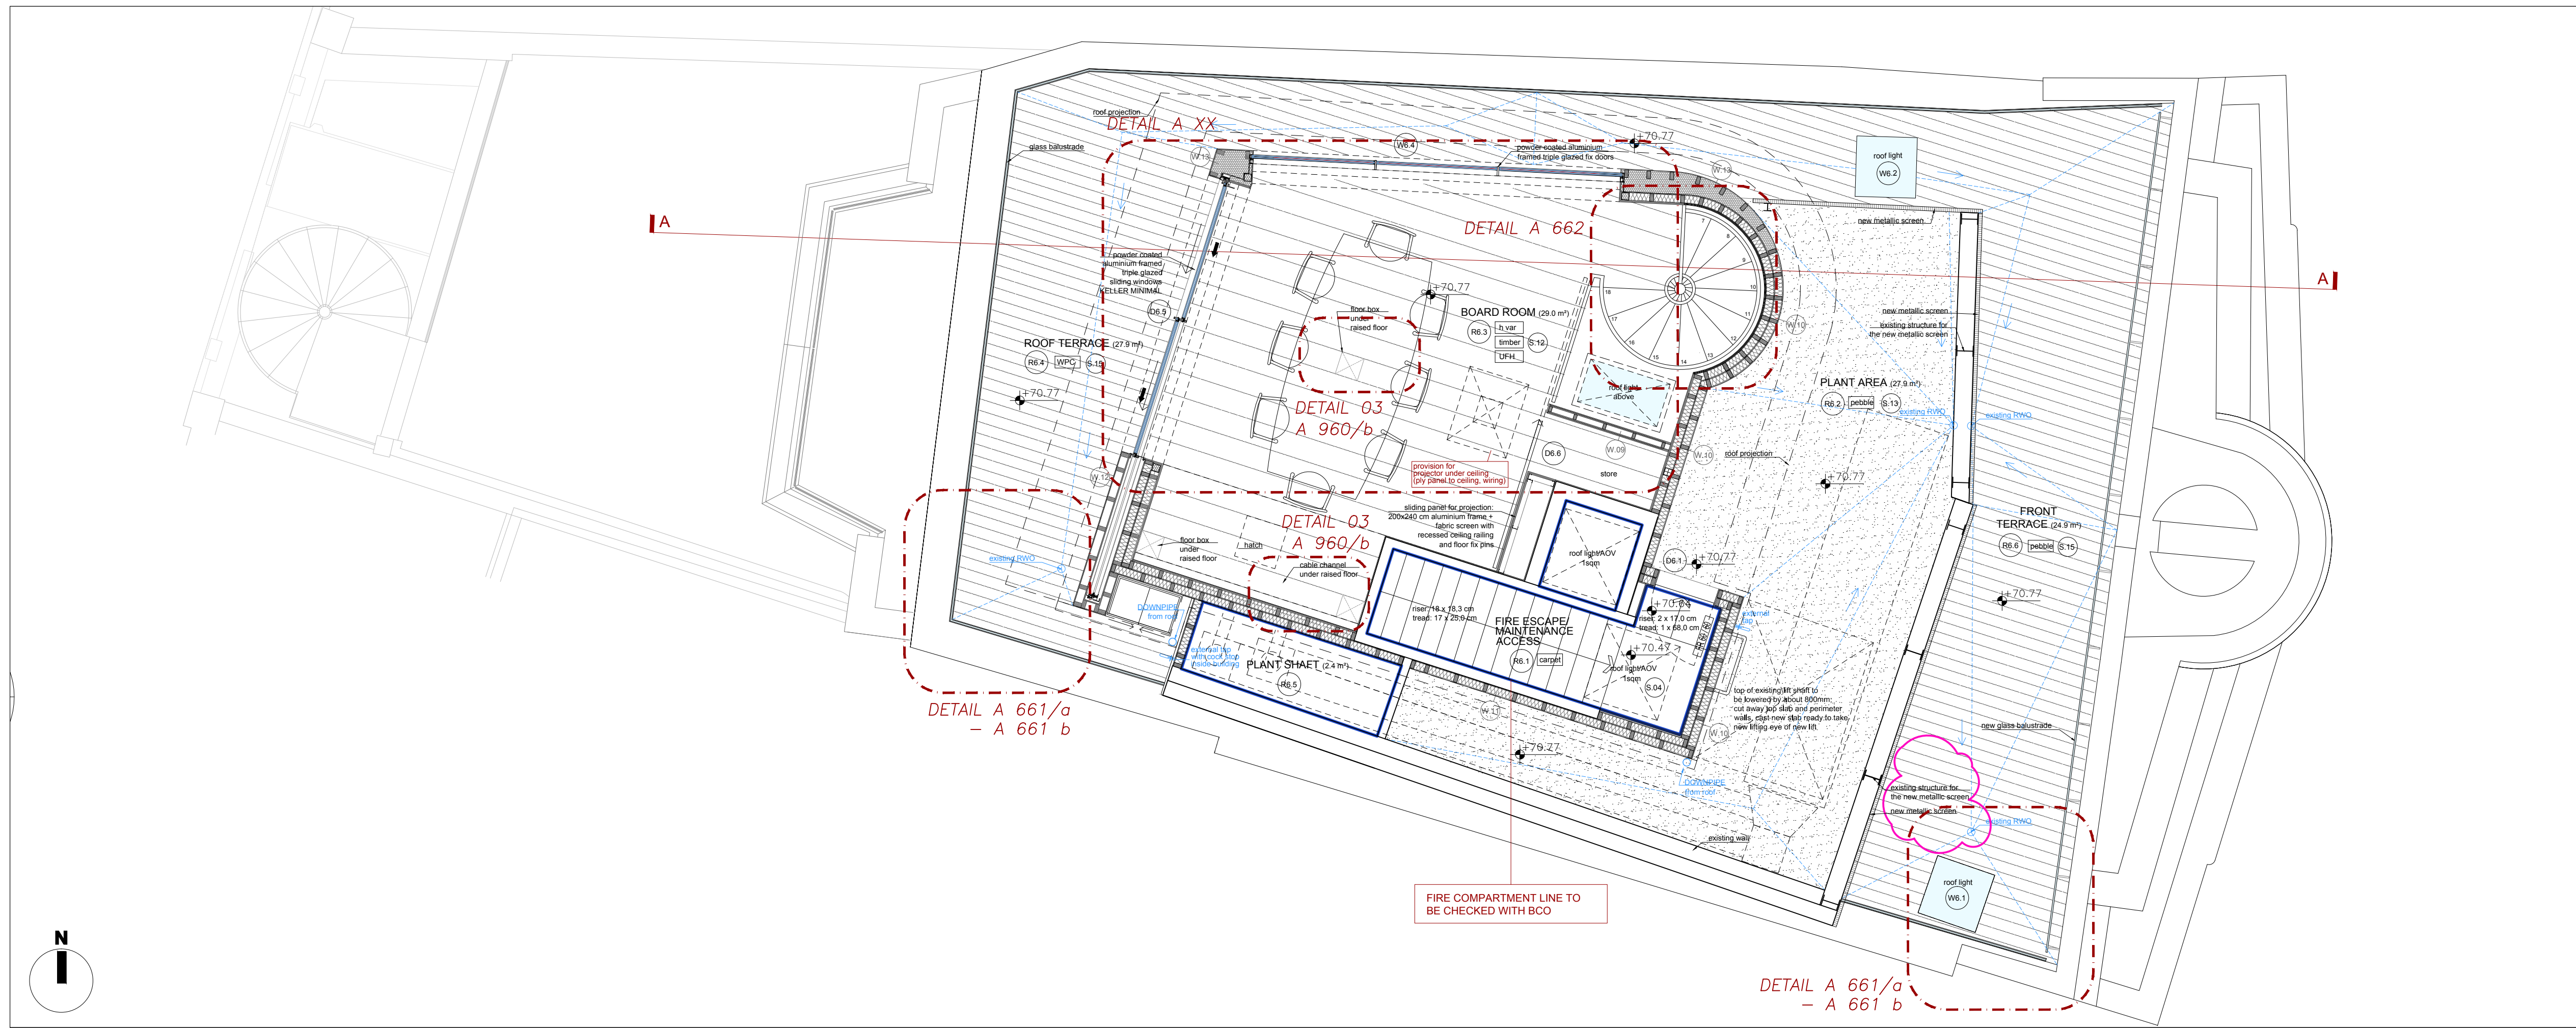

6th FLOOR PLAN
1:50 @ A1 Size

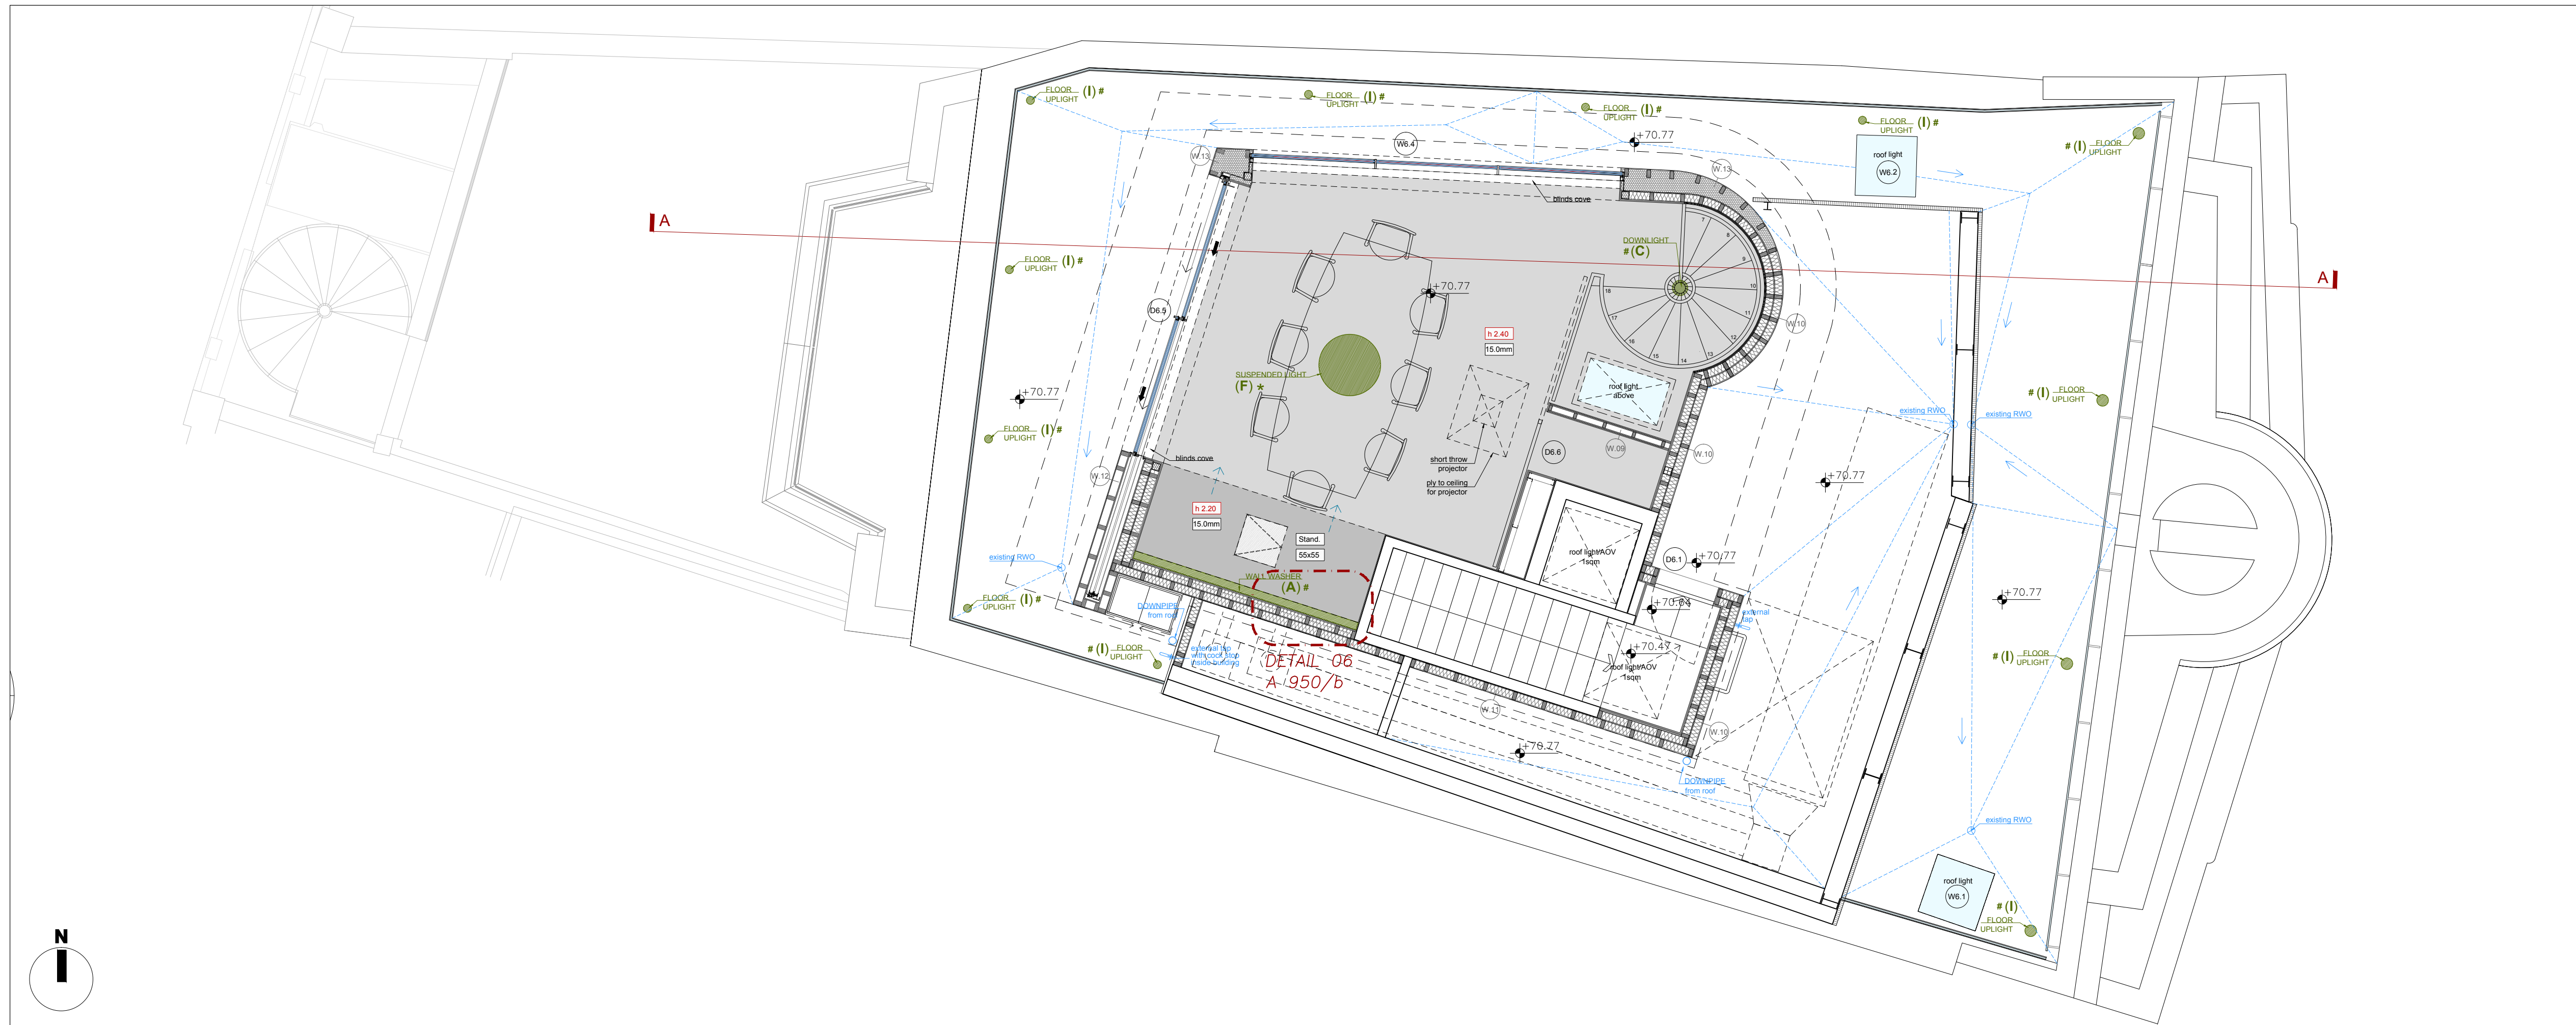

6th FLOOR: CEILING PLAN
1:50 @ A1 Size

LEGEND	
h 0.00	NET HEIGHT
RB.0	ROOMS CODE
DB.0	DOORS CODE
WB.0	WINDOWS CODE
W.00	WALL CODE (for walls details refer to A 920 drawing)
S.00	SLAB CODE (for slab details refer to A 930 drawing)
	CEILING EXTRACT FAN
	LIGHT SWITCH
	DIMMER LIGHT SWITCH
	SPEAKERS TO CEILING
	30 MIN FIRE RATING
	60 MIN FIRE RATING

LEGEND / CEILING	
h 0.00	CEILING NET HEIGHT
	STANDARD BOARDS - GYPROC WALLBOARD
	STANDARD BOARDS - GYPROC WALLBOARD
	PERFORMANCE BOARDS - GYPROC MOISTURE RESISTANT
15.0mm	PLASTERBOARD THICKNESS
	VERTICAL GYPSUM FASCIA
	COVE LIGHTING
	GYPROC PROFILEX STANDARD ACCESS PANEL
55x55	HATCH DIMENSIONS

LEGEND / LIGHTING	
(A)	WALL WASHER, FLOS, Soft LED curtain recessed
(B)	DOWN LIGHT, REGENT, Echo 210 LED (IP20)
(C)	DOWN LIGHT, REGENT, Medra LED (IP20)
(C14)	DOWN LIGHT, REGENT, Medra LED (IP44)
(D)	LED TAPE LIGHT, ZONCA, Strip (IP20)
(E)	COVE LIGHTING, ZONCA, Strip (IP20)
(E65)	COVE LIGHTING, ZONCA, Strip (IP65)
(F)	SUSPENDED LIGHT, PENTA LIGHT, Sospensione cilindro maxi (custom made)
(G)	1 £ LIGHT
(H)	1 £ WALL LIGHT
(I)	FLOOR UPLIGHT, (IP65)
*	DAYLIGHT AND MOTION DETECTING LIGHT MANAGEMENT SYSTEM
#	ELECTRIC POWER SWITCHBOARD MANAGEMENT SYSTEM

Notes:
1. No dimensions are to be scaled from this drawing.
2. All dimensions are to be checked on site prior to fabrication
3. Any discrepancies on site have to be reported to the architect.

OFFICE ART AG 8 CITY ROAD, LONDON EC1

REFURBISHMENT OF EXISTING OFFICE BUILDING

6th FLOOR: PLAN + REFLECTED CEILING PLAN	A 106
Status: /	Date: 01.04.2015
Drawn: EP	Scale: 1:50
	ref.: 316
	☐ ☐ ☐

CLIENT / COMMITTENTE
OFFICE ART AG

PLANNING PERMISSION ARCHITECTS
Simon Smith & Michael Brooke Architects
No 3 Scout Lane, London SW4 0LA
0044 20 7627 7630
post@smithbrooke.co.uk

PROJECT MANAGER
iC consulente Zivitechniker GesmbH
Mr. Markus Querner
Schönbrunner Straße 297
1120 Wien, Austria
0043 1 521 69-0
pm.scityroad@ic-ces.at

CONSULTANT ARCHITECTS
VENELLI KRAMER PROGETTI SH
Arch. Ruggero Venelli - Arch. Cecilia Kramer
Via Pisani Dossi 5a, 22100 Como, Italia
0039 031 570779
info@venellikramer.com



LENA ZEIDLER Architect
8 City Road, London EC1
0044 7715395952 (mobile)
lena.zeidler@8cityroad.co.uk

M&E PROJECT

REVISION	
N	Extension of new metallic screen updated.
	29.04.2016