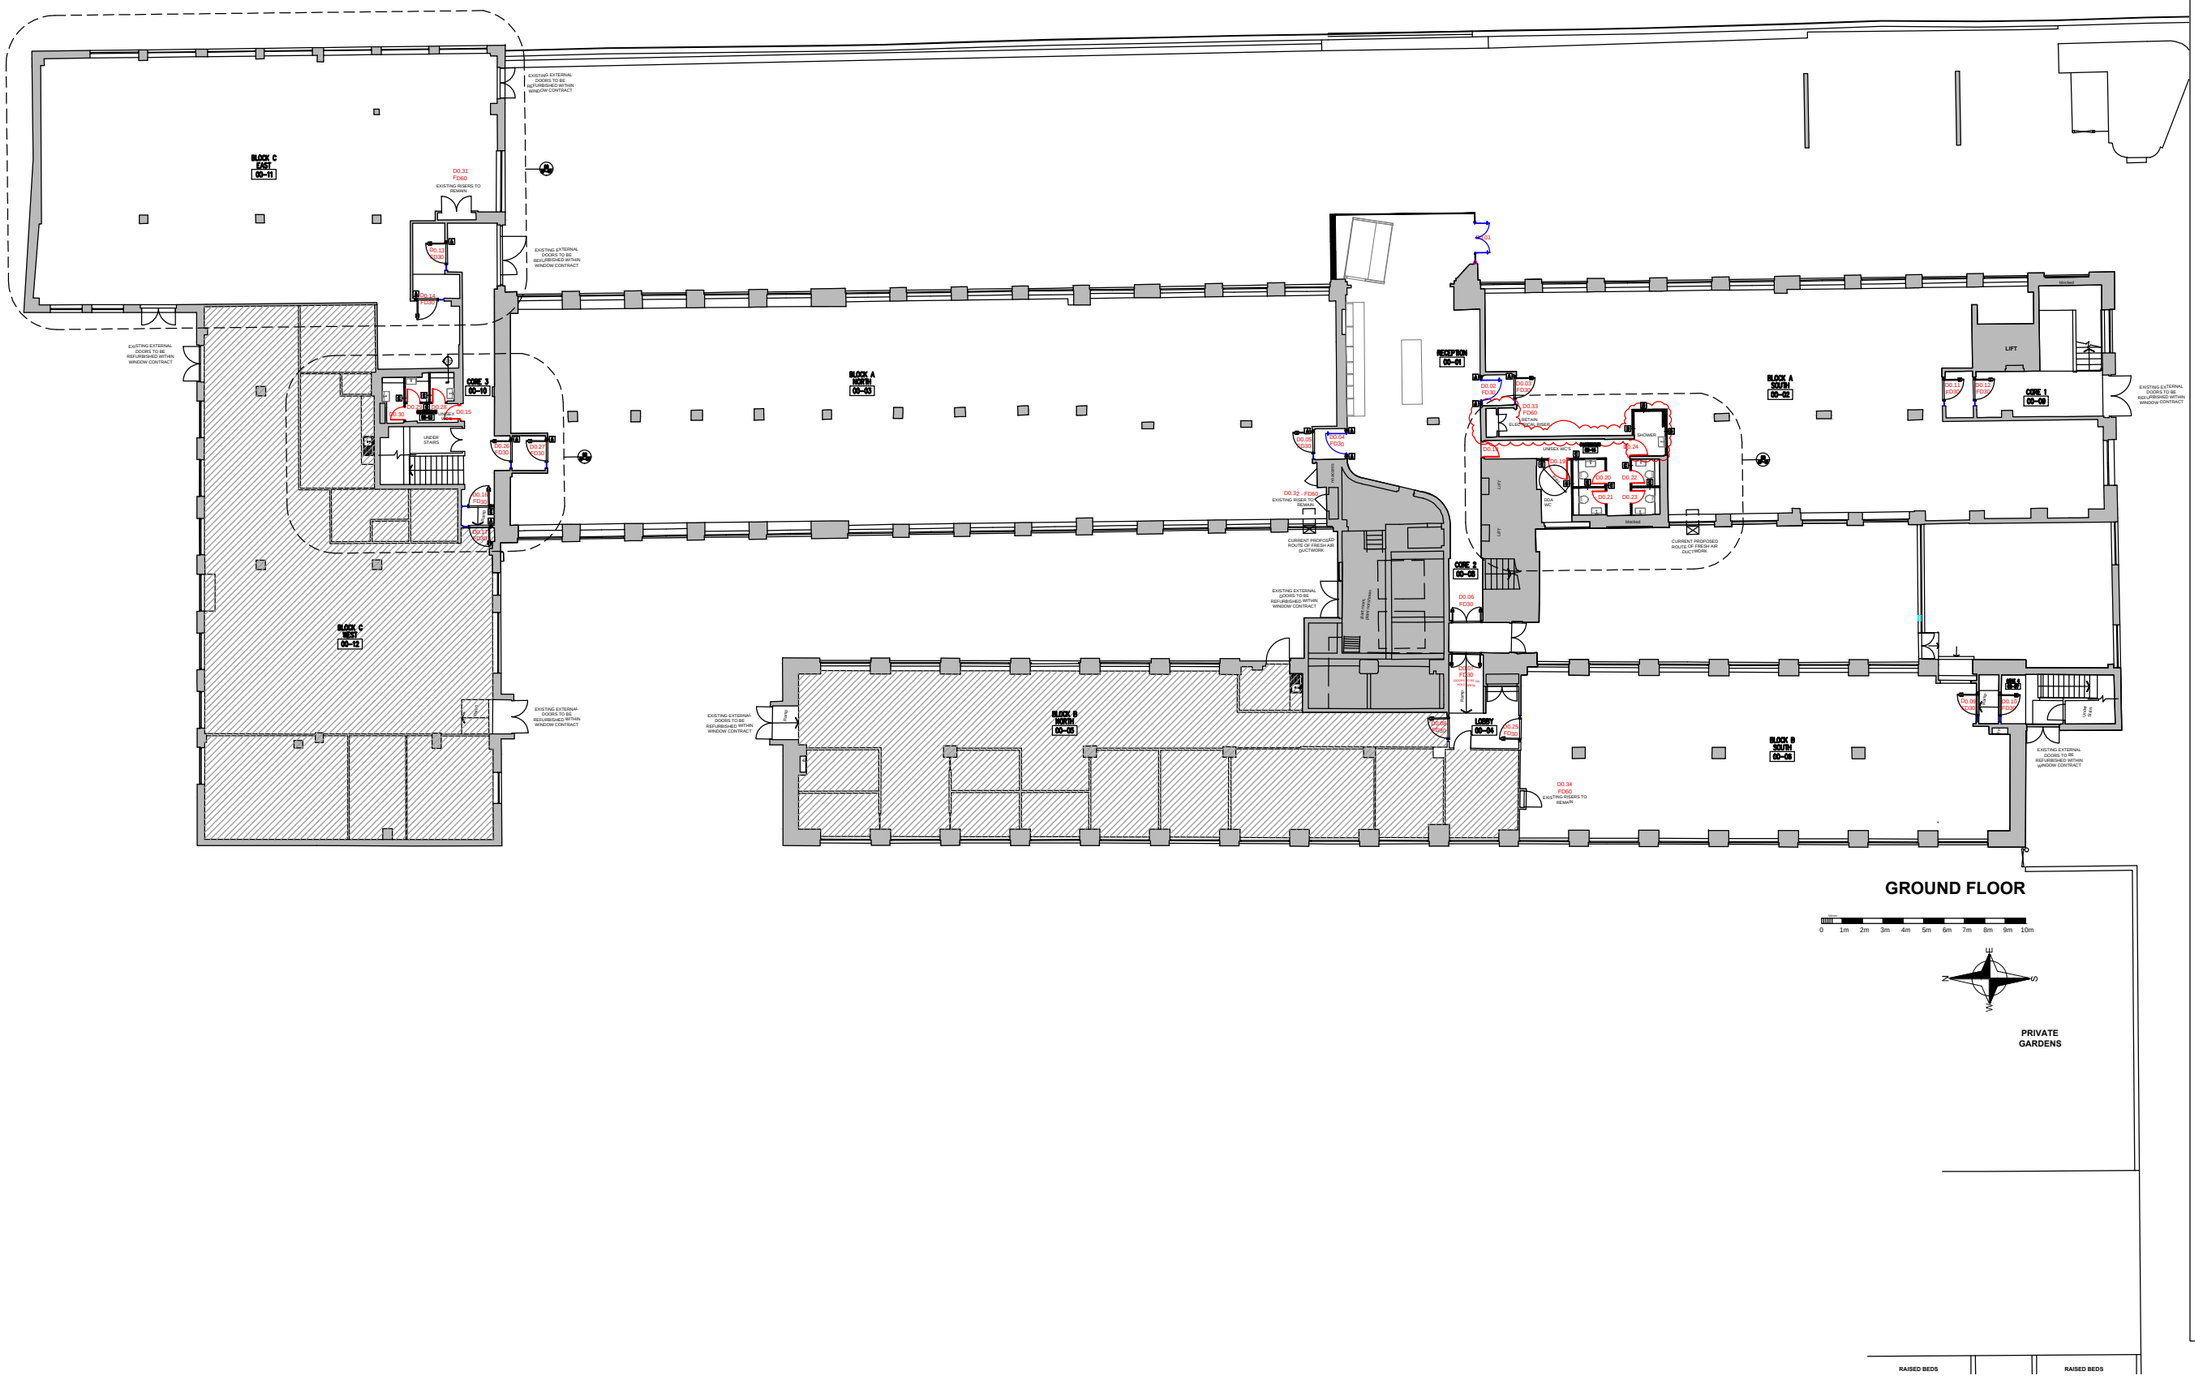

ThirdWay

©Copyright

Copyright of this drawing belongs to & is vested in **THIRDWAY INTERIORS** and may not be reproduced or without written consent by **THIRDWAY INTERIORS**. Any persons, firm or company unlawfully reproducing or distributing this drawing or in any way infringing the copyright therein will be prosecuted.

This document is the property of **THIRDWAY INTERIORS**. Copyright is reserved by them, and the drawing is issued on the condition that it is not copied, reproduced or retained by, nor disclosed to any unauthorised person, either wholly or in part, without the consent in writing from **THIRDWAY INTERIORS**.

Note

ALL DIMENSIONS MUST BE CHECKED ON SITE.
DO NOT SCALE FROM THIS DRAWING.
THIS DRAWING IS FOR DISCUSSION PURPOSES ONLY AND IS SUBJECT TO FIRE OFFICER AND BUILDING REGULATION APPROVALS BEING OBTAINED.

Drawing Approval

Client Signature	
Printed Name	
ThirdWay Signature	
Date	
Specification Ref	

Status

- [ ] Preliminary/Info.
- [ ] Contract
- [ ] Construction
- [ ] Approval/Comment
- [ ] As-Built
- [ ] Building Control

Revision Detail

Rev	Detail	By	Date
A	INFORMATION	RG	22.05.15
B	INFORMATION	RG	28.04.15
C	INFORMATION	RG	12.05.15
D	INFORMATION	RG	19.05.15
E	UPDATED PACK	RG	22.05.15

PRELIMINARY DRAWING

Client

CAMBRIDGE HOUSE REALTY LTD

Project Title

ALL FLOORS
THE AIRCRAFT FACTORY
100 CAMBRIDGE GROVE
LONDON
W6 0LE

Drawing Title

GROUND FLOOR
GENERAL ARRANGEMENT
WORKING DRAWING

Date: 30.03.15	Drawn By: DJ
Scale: 1:300@A3	Rev: E
Drawing No: TWI-1017-GF-GA	

ThirdWay
ThirdWay Interiors Ltd
2nd Floor 3-5 Bleeding Heart Yard
London EC1N 8SJ