

AREA PLAN



**100 Lower Mount Street, Dublin 2
Co. Dublin**

Fifth Floor

Gross Internal Area

 GIA 54.7 sq m 589 sq ft

TOTAL GIA: 54.7 sq m 589 sq ft

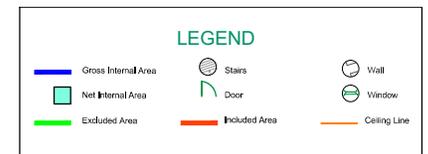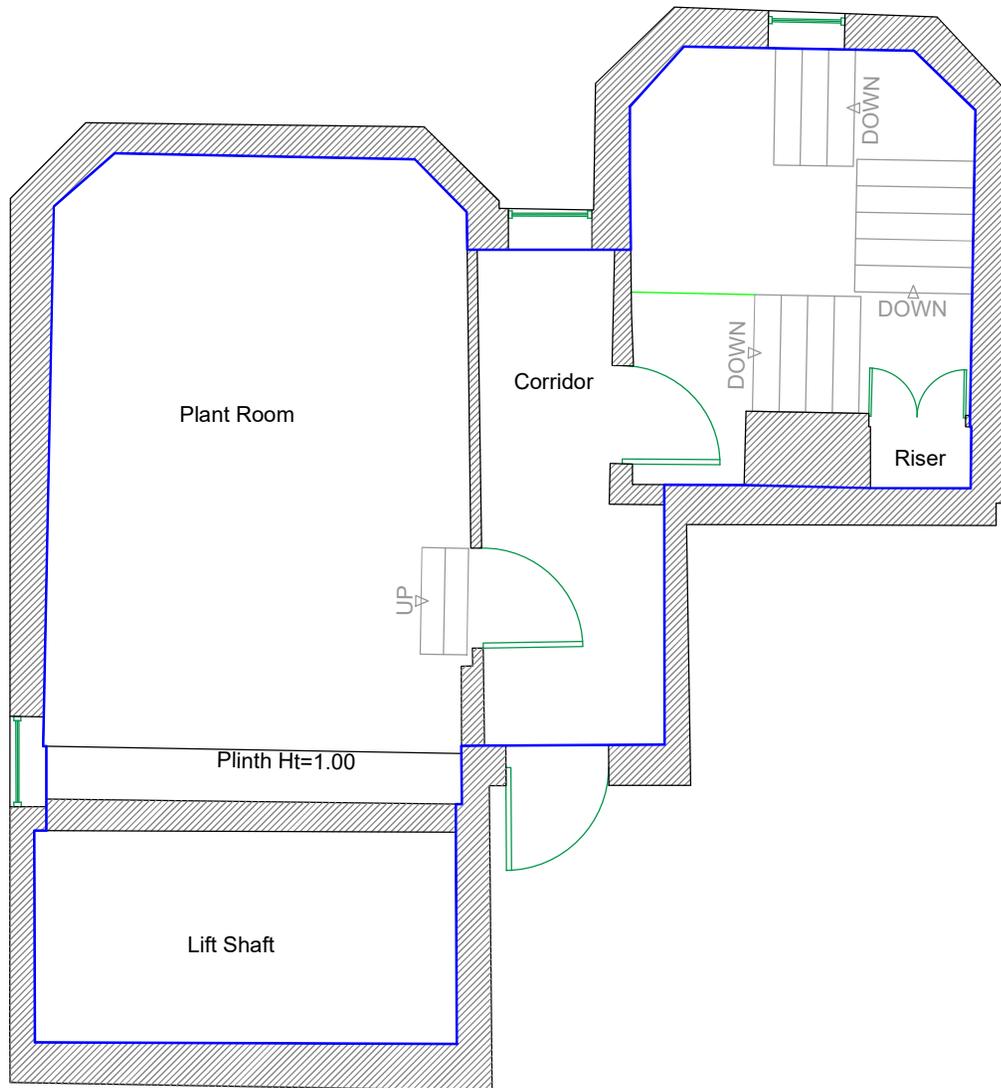

Scaled for presentation purposes

Drawing No.

MSL17828_NIA/GIA_L5

October 2016

murphy
GLOBAL CONSULTING SURVEYORS

Phone: (+353) 045 484040

Fax: (+353) 045 484004

Email: info@murphysurveys.ie

Web: www.murphysurveys.com

Dublin Kildare Cork Belfast Glasgow London



Note:

This drawing complies with the Royal Institution of Chartered Surveyors (RICS) Professional Statement "RICS Property Measurement, 1st edition, May 2015", more particularly Part three (3) - Code of Measuring Practice. It also indicates the extent of the areas quoted, produced to an accuracy commensurate with standard presentation scales. It is held in a scaled digital CAD format.

**Condition of Site:
Vacant
Heavy Fit-Out**

Revised By	Date	Description
AG	October 2016	Final Issue

Head Office
Global House
Kilcullen Business Campus
Kilcullen
Co. Kildare
Ireland

AREA PLAN

**100 Lower Mount Street, Dublin 2
Co. Dublin**

Fourth Floor

Net Internal Area

 NIA 428.1 sq m 4608 sq ft



TOTAL NIA: 428.1 sq m 4608 sq ft

Gross Internal Area

 GIA 500.0 sq m 5382 sq ft

TOTAL GIA: 500.0 sq m 5382 sq ft

4th floor

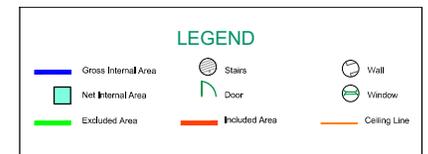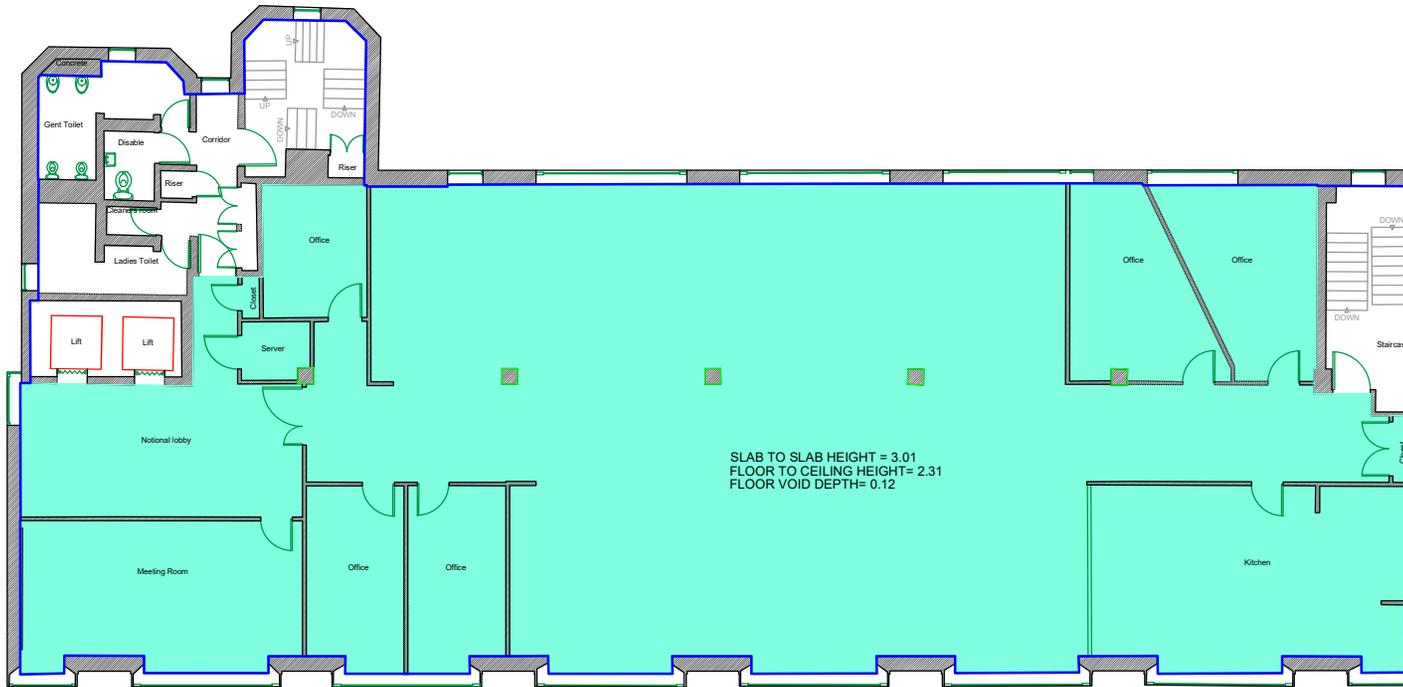

Scaled for presentation purposes

Drawing No.

MSL17828_NIA/GIA_L4

October 2016

murphy
GLOBAL CONSULTING SURVEYORS

Phone: (+353) 045 484040

Fax: (+353) 045 484004

Email: info@murphysurveys.ie

Web: www.murphysurveys.com

Dublin Kildare Cork Belfast Glasgow London



Note:

This drawing complies with the Royal Institution of Chartered Surveyors (RICS) Professional Statement "RICS Property Measurement, 1st edition, May 2015", more particularly Part three (3) - Code of Measuring Practice. It also indicates the extent of the areas quoted, produced to an accuracy commensurate with standard presentation scales. It is held in a scaled digital CAD format.

**Condition of Site:
Vacant
Heavy Fit-Out**


Drawn by	Date	Drawn	Local
AG	October 2016		
AG	October 2016		
AG	October 2016		
Revisions			
No	Date	Description	By
1	22/08/2016	Final Issue	

Head Office
Global House
Kilcullen Business Campus
Kilcullen
Co. Kildare
Ireland

AREA PLAN

**100 Lower Mount Street, Dublin 2
Co. Dublin**

3rd floor

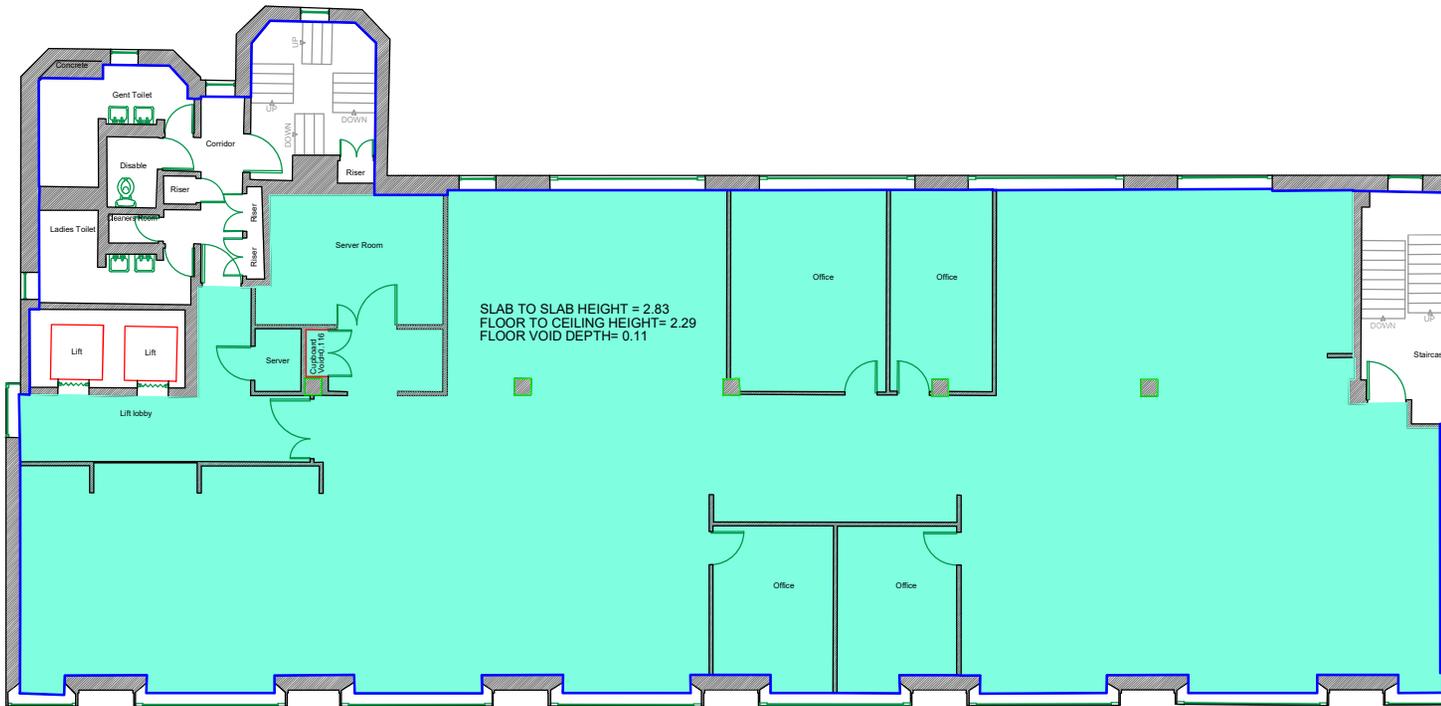

Third Floor

Net Internal Area

■	NIA	426.7 sq m	4593 sq ft
-------------------------------------	-----	------------	------------

TOTAL NIA: 426.7 sq m 4593 sq ft

Gross Internal Area

■	GIA	499.0 sq m	5371 sq ft
-------------------------------------	-----	------------	------------

TOTAL GIA: 499.0 sq m 5371 sq ft



Scaled for presentation purposes

Drawing No.

MSL17828_NIA/GIA_L3

October 2016



GLOBAL CONSULTING SURVEYORS

Phone: (+353) 045 484040

Fax: (+353) 045 484004

Email: info@murphysurveys.ie

Web: www.murphysurveys.com

Dublin Kildare Cork Belfast Glasgow London



Note:

This drawing complies with the Royal Institution of Chartered Surveyors (RICS) Professional Statement "RICS Property Measurement, 1st edition, May 2015", more particularly Part three (3) - Code of Measuring Practice. It also indicates the extent of the areas quoted, produced to an accuracy commensurate with standard presentation scales. It is held in a scaled digital CAD format.

**Condition of Site:
Vacant
Heavy Fit-Out**

Drawn by: AG	Date: October 2016	Drawn: Local
Checked by: MN	Date: October 2016	Grid System: Local
Revisions		
No	Date	Description
1	22/09/2016	Final Issue

**Head Office
Global House
Kilcullen Business Campus
Kilcullen
Co. Kildare
Ireland**

AREA PLAN

**100 Lower Mount Street, Dublin 2
Co. Dublin**

Second Floor

Net Internal Area

 NIA 427.9 sq m 4606 sq ft


TOTAL NIA: 427.9 sq m 4606 sq ft

Gross Internal Area

 GIA 500.1 sq m 5383 sq ft

TOTAL GIA: 500.1 sq m 5383 sq ft

2nd floor

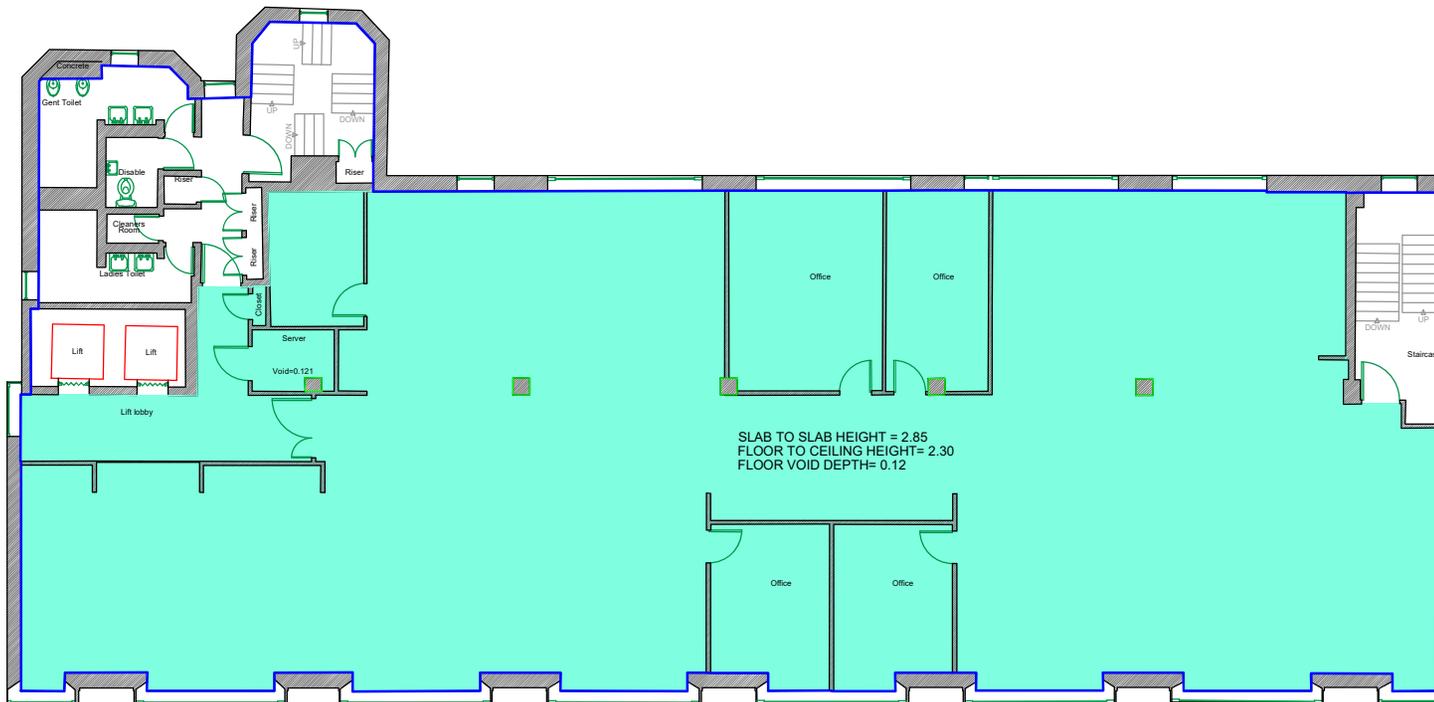

Scaled for presentation purposes

Drawing No.

MSL17828_NIA/GIA_L2

October 2016

murphy
GLOBAL CONSULTING SURVEYORS

Phone: (+353) 045 484040

Fax: (+353) 045 484004

Email: info@murphysurveys.ie

Web: www.murphysurveys.com

Dublin Kildare Cork Belfast Glasgow London



Note:

This drawing complies with the Royal Institution of Chartered Surveyors (RICS) Professional Statement "RICS Property Measurement, 1st edition, May 2015", more particularly Part three (3) - Code of Measuring Practice. It also indicates the extent of the areas quoted, produced to an accuracy commensurate with standard presentation scales. It is held in a scaled digital CAD format.

Condition of Site:

**Vacant
Heavy Fit-Out**


Revised By	Date	Description	Drawn	Local
AG	October 2016			
AG	October 2016			
BN	October 2016			
Revisions				
No	Date	Description	Drawn	Local
1	22/08/2016	Final Issue		

Head Office
Global House
Kilcullen Business Campus
Kilcullen
Co. Kildare
Ireland

AREA PLAN

**100 Lower Mount Street, Dublin 2
Co. Dublin**

1st floor

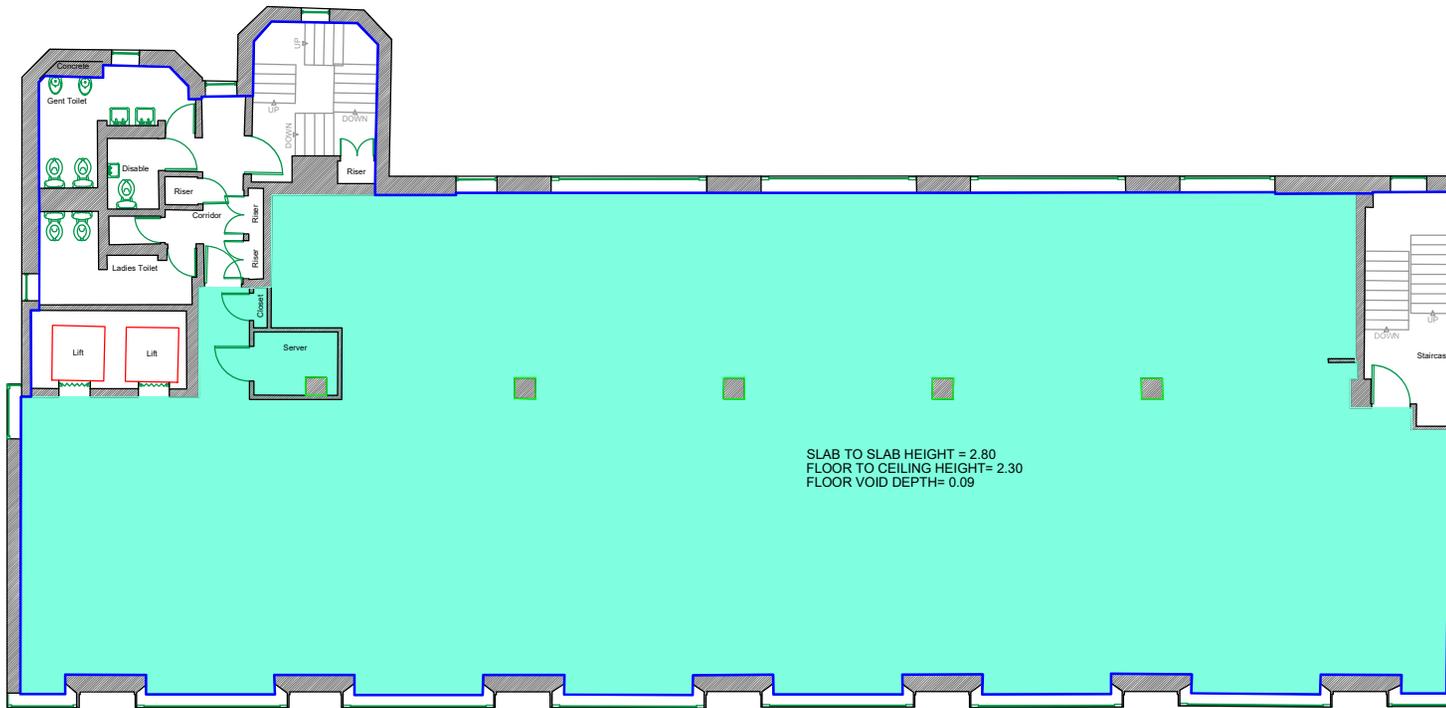

First Floor

Net Internal Area

NIA 425.4 sq m 4579 sq ft

TOTAL NIA: 425.4 sq m 4579 sq ft

Gross Internal Area

GIA 498.5 sq m 5366 sq ft

TOTAL GIA: 498.5 sq m 5366 sq ft



Scaled for presentation purposes

Drawing No.

MSL17828_NIA/GIA_L1

October 2016

murphy
GLOBAL CONSULTING SURVEYORS

Phone: (+353) 045 484040
Fax: (+353) 045 484004
Email: info@murphysurveys.ie
Web: www.murphysurveys.com
Dublin Kildare Cork Belfast Glasgow London



Note:


This drawing complies with the Royal Institution of Chartered Surveyors (RICS) Professional Statement "RICS Property Measurement, 1st edition, May 2015", more particularly Part three (3) - Code of Measuring Practice. It also indicates the extent of the areas quoted, produced to an accuracy commensurate with standard presentation scales. It is held in a scaled digital CAD format.

**Condition of Site:
Vacant
Heavy Fit-Out**

Drawn by: AG	Date: October 2016	Drawn	Local
Checked by: N/A	Date: October 2016	Grid System:	Local
Revisions			
No	Date	Description	
1	22/08/2016	Final Issue	

Head Office
Global House
Kilcullen Business Campus
Kilcullen
Co. Kildare
Ireland

Ground floor

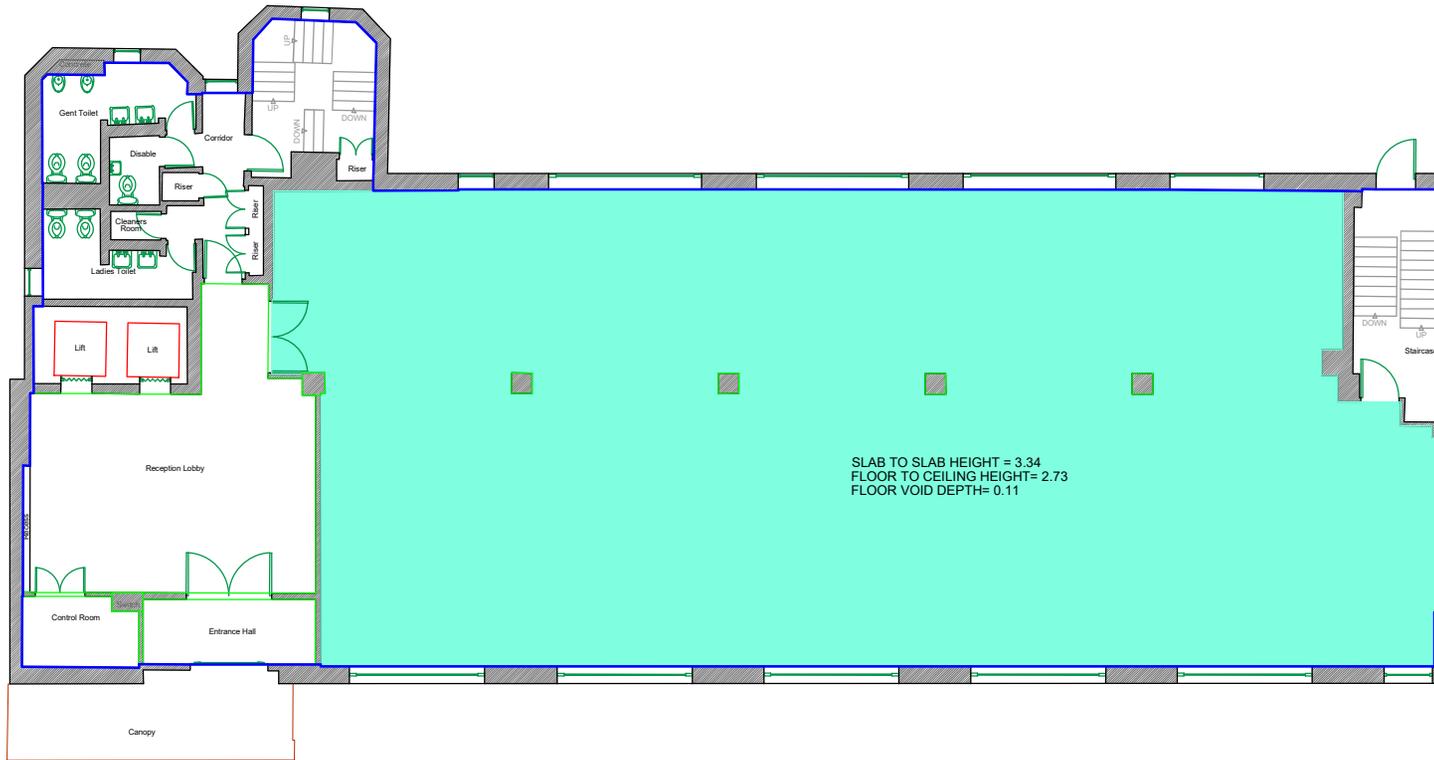

AREA PLAN

**100 Lower Mount Street, Dublin 2
Co. Dublin**

Ground Floor

Net Internal Area

■ NIA	352.2 sq m	3791 sq ft
---	------------	------------

TOTAL NIA: 352.2 sq m 3791 sq ft

The following areas have been EXCLUDED from the Total NIA:

Reception	44.6 sq m	480 sq ft
Entrance Hall	7.6 sq m	82 sq ft
Control Room	5.3 sq m	58 sq ft
Switch	0.4 sq m	4 sq ft

Gross Internal Area

□ GIA	486.8 sq m	5240 sq ft
---	------------	------------

TOTAL GIA: 486.8 sq m 5240 sq ft



Scaled for presentation purposes

Drawing No.

MSL17828_NIA/GIA_LO

October 2016

murphy
GLOBAL CONSULTING SURVEYORS

Phone: (+353) 045 484040
Fax: (+353) 045 484004
Email: info@murphysurveys.ie
Web: www.murphysurveys.com
Dublin Kildare Cork Belfast Glasgow London



Note:

This drawing complies with the Royal Institution of Chartered Surveyors (RICS) Professional Statement "RICS Property Measurement, 1st edition, May 2015", more particularly Part three (3) - Code of Measuring Practice. It also indicates the extent of the areas quoted, produced to an accuracy commensurate with standard presentation scales. It is held in a scaled digital CAD format.

**Condition of Site:
Vacant
Heavy Fit-Out**


Drawn by: AG	Date: October 2016	Drawn	Local
Checked by: N/A	Date: October 2016	Grid System:	Local
		Revisions	
No	Date	Description	
1	22/08/2016	Final Issue	

**Head Office
Global House
Kilcullen Business Campus
Kilcullen
Co. Kildare
Ireland**

AREA PLAN

**100 Lower Mount Street, Dublin 2
Co. Dublin**

Lower floor

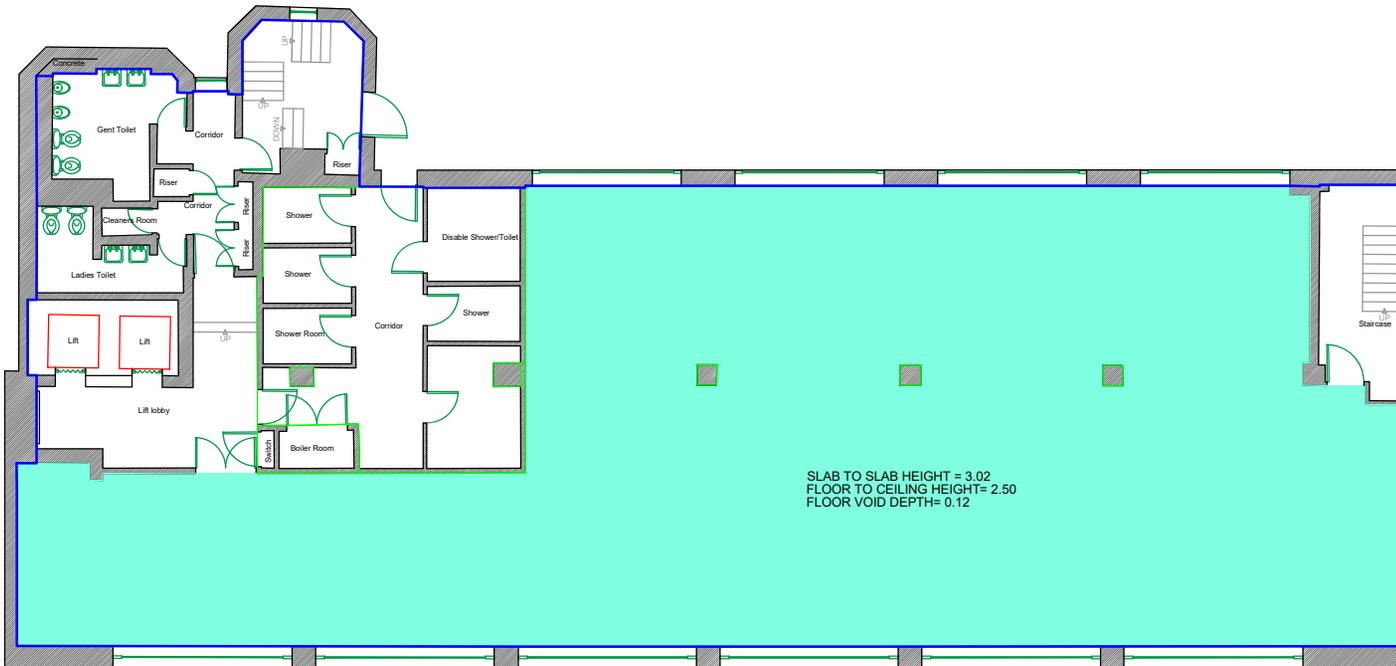

Lower Ground Floor

Net Internal Area

■ NIA	335.5 sq m	3611 sq ft
---	------------	------------

TOTAL NIA: 335,5 sq m 3611 sq ft

The following areas have been EXCLUDED from the Total NIA:

Shower Area	49.9 sq m	537 sq ft
Boiler/Switch Room	3.5 sq m	37 sq ft

Gross Internal Area

□ GIA	480.2 sq m	5169 sq ft
---	------------	------------

TOTAL GIA: 480,2 sq m 5169 sq ft



Scaled for presentation purposes

Drawing No.

MSL17828_NIA/GIA_L-1

October 2016



GLOBAL CONSULTING SURVEYORS

Phone: (+353) 045 484040

Fax: (+353) 045 484004

Email: info@murphysurveys.ie

Web: www.murphysurveys.com

Dublin Kildare Cork Belfast Glasgow London



Note:

This drawing complies with the Royal Institution of Chartered Surveyors (RICS) Professional Statement "RICS Property Measurement, 1st edition, May 2015", more particularly Part three (3) - Code of Measuring Practice. It also indicates the extent of the areas quoted, produced to an accuracy commensurate with standard presentation scales. It is held in a scaled digital CAD format.

**Condition of Site:
Vacant
Heavy Fit-Out**

Drawn by	Date	Drawn	Local
AG	October 2016		
AG	October 2016		
AG	October 2016		
Revisions			
No	Date	Description	By
1	22/08/2016	Final Issue	

**Head Office
Global House
Kilcullen Business Campus
Kilcullen
Co. Kildare
Ireland**