



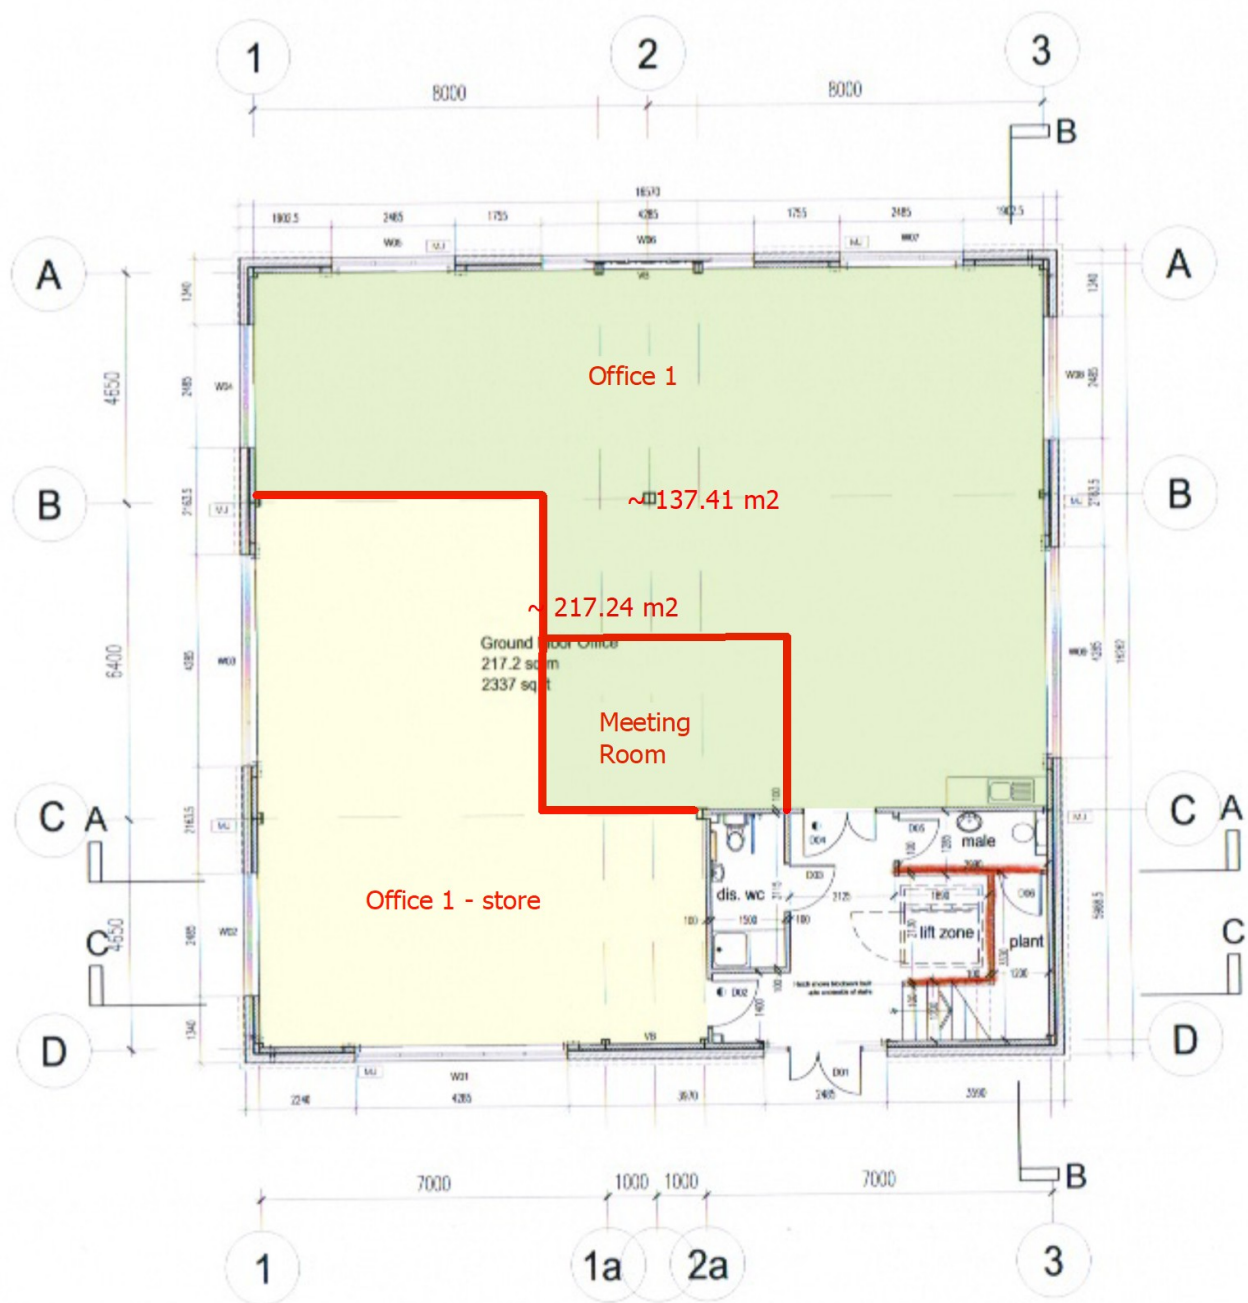

Ground Floor Plan

*Fire rated under stair*

DRAFT

BUILDING REGULATIONS	Self Architects	
	HP Construction	
	Office Unit Hydro Business Park	
	Proposed Ground Floor Plan	
	Drawn by ES@AI	Checked by art
	Date March 2014	Scale B